
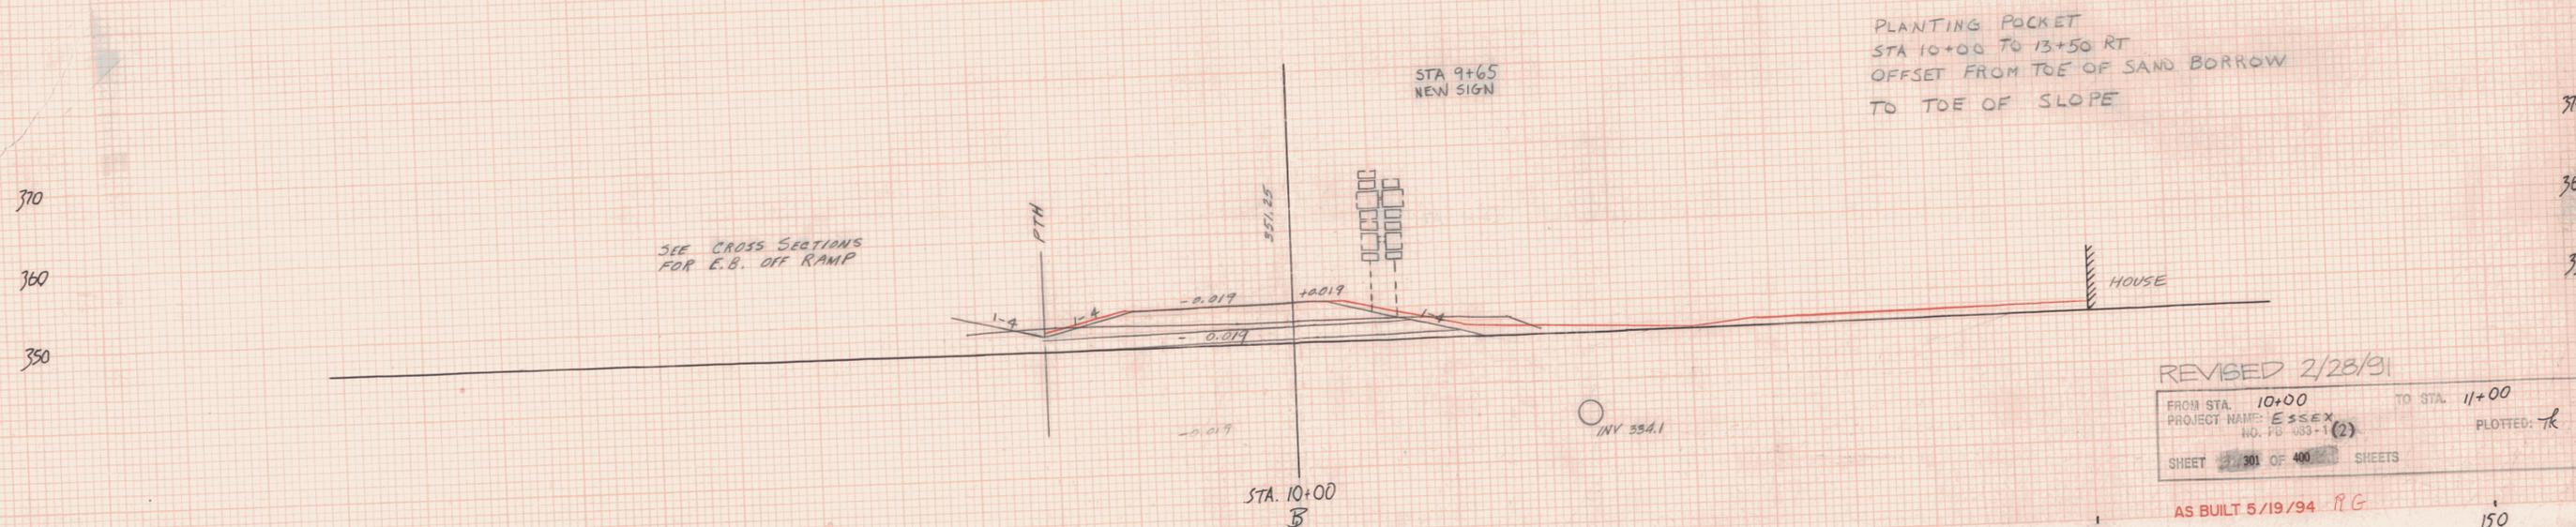
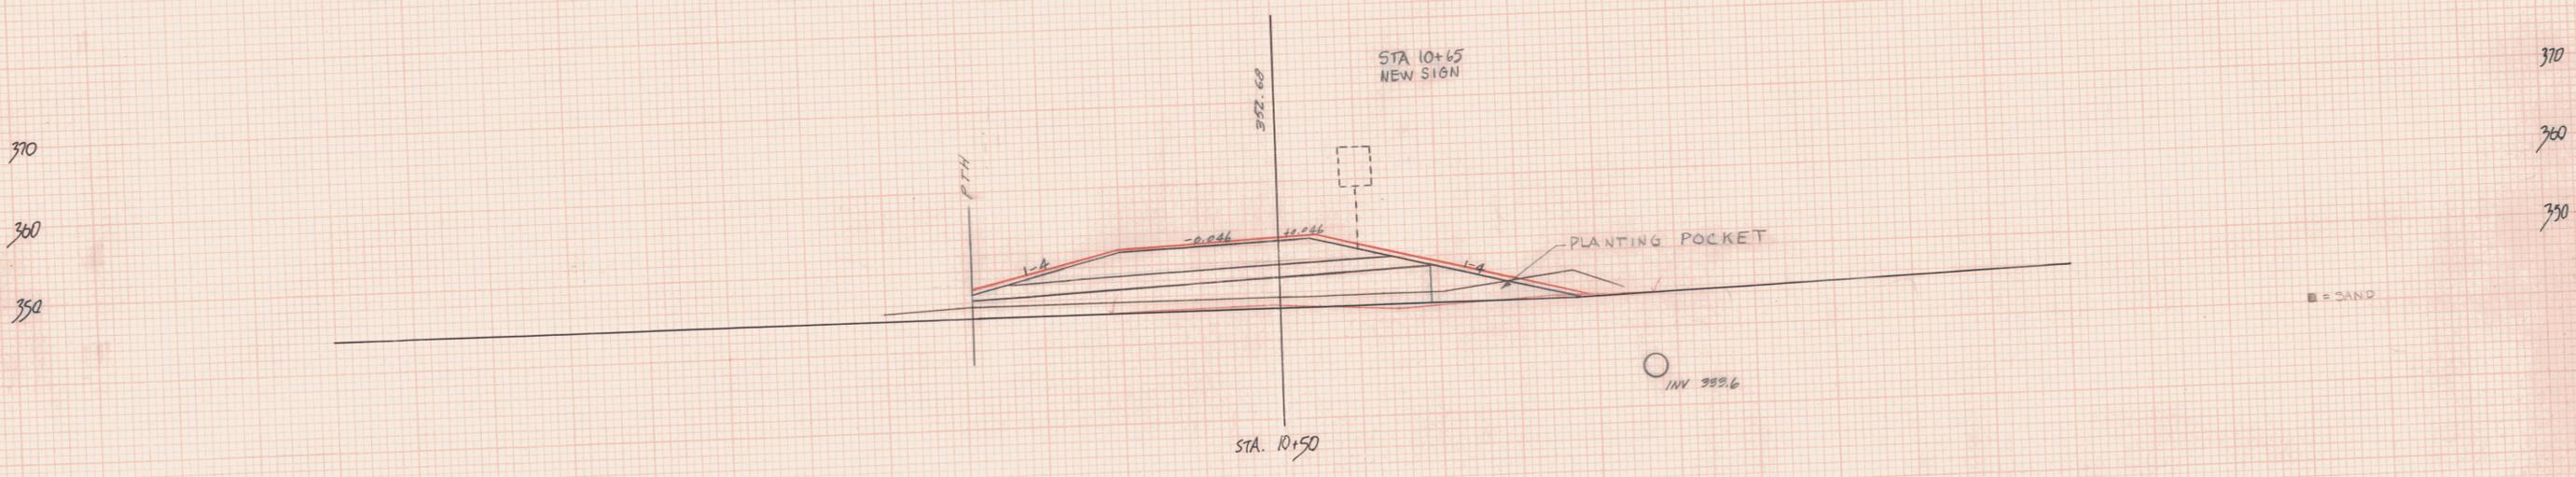


RAMP A
RTE 2A

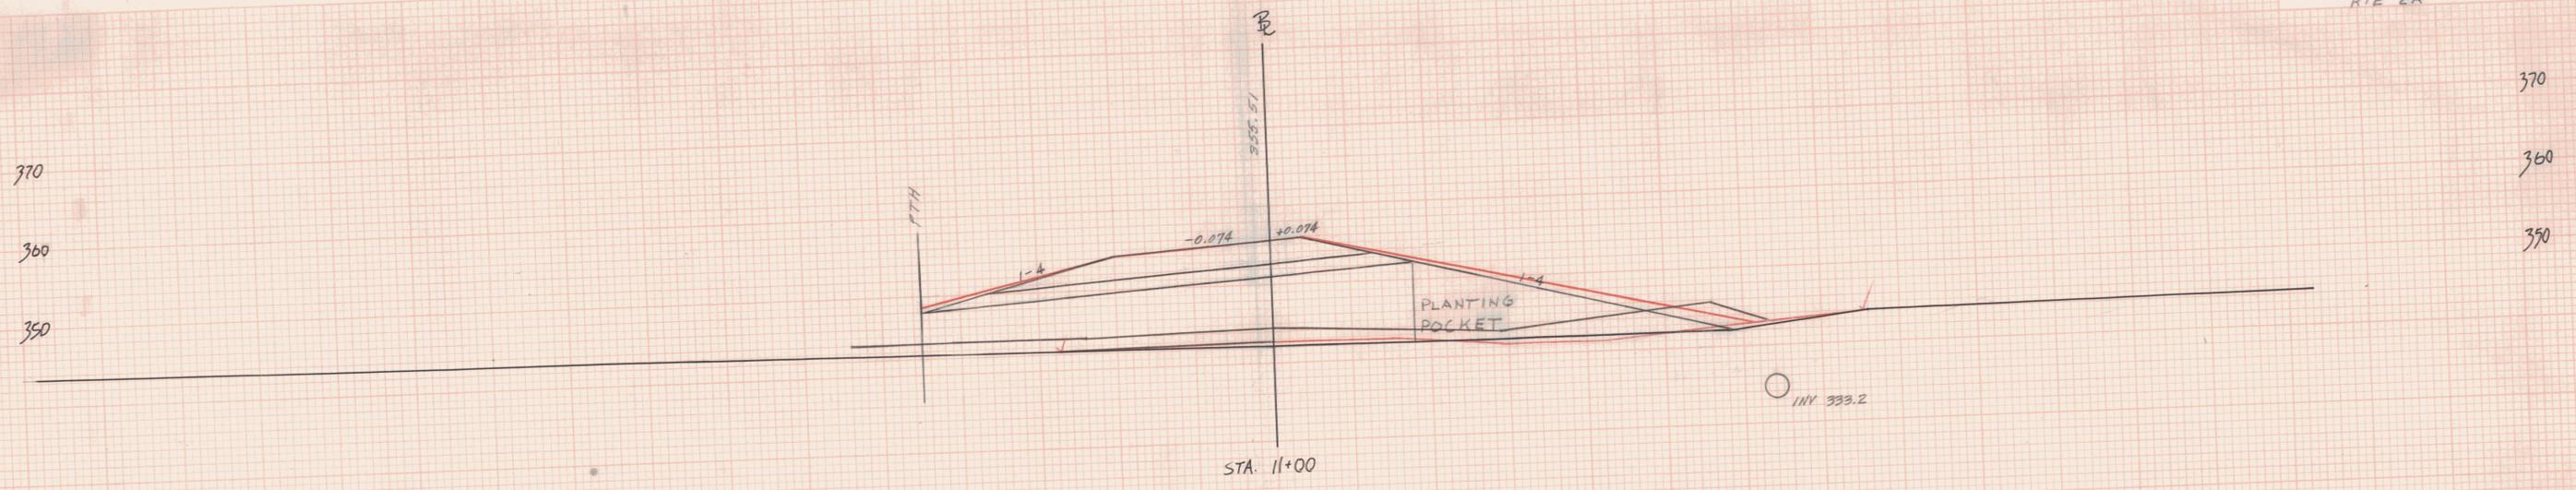

SEE CROSS SECTIONS
FOR E.B. OFF RAMP

PLANTING POCKET
STA 10+00 TO 13+50 RT
OFFSET FROM TOE OF SAND BORROW
TO TOE OF SLOPE

REVISED 2/28/91
FROM STA. 10+00 TO STA. 11+00
PROJECT NAME: ESSEX
NO. PD 300-1(2) PLOTTED: JK
SHEET 301 OF 400 SHEETS

AS BUILT 5/19/94 RIG

DATE: _____
BY: _____
CHECKED: _____
FINAL SURVEY
NOTE BOOK
NO. _____

DATE: _____
BY: _____
CHECKED: _____
ORIGINAL SURVEY
NOTE BOOK
NO. _____