
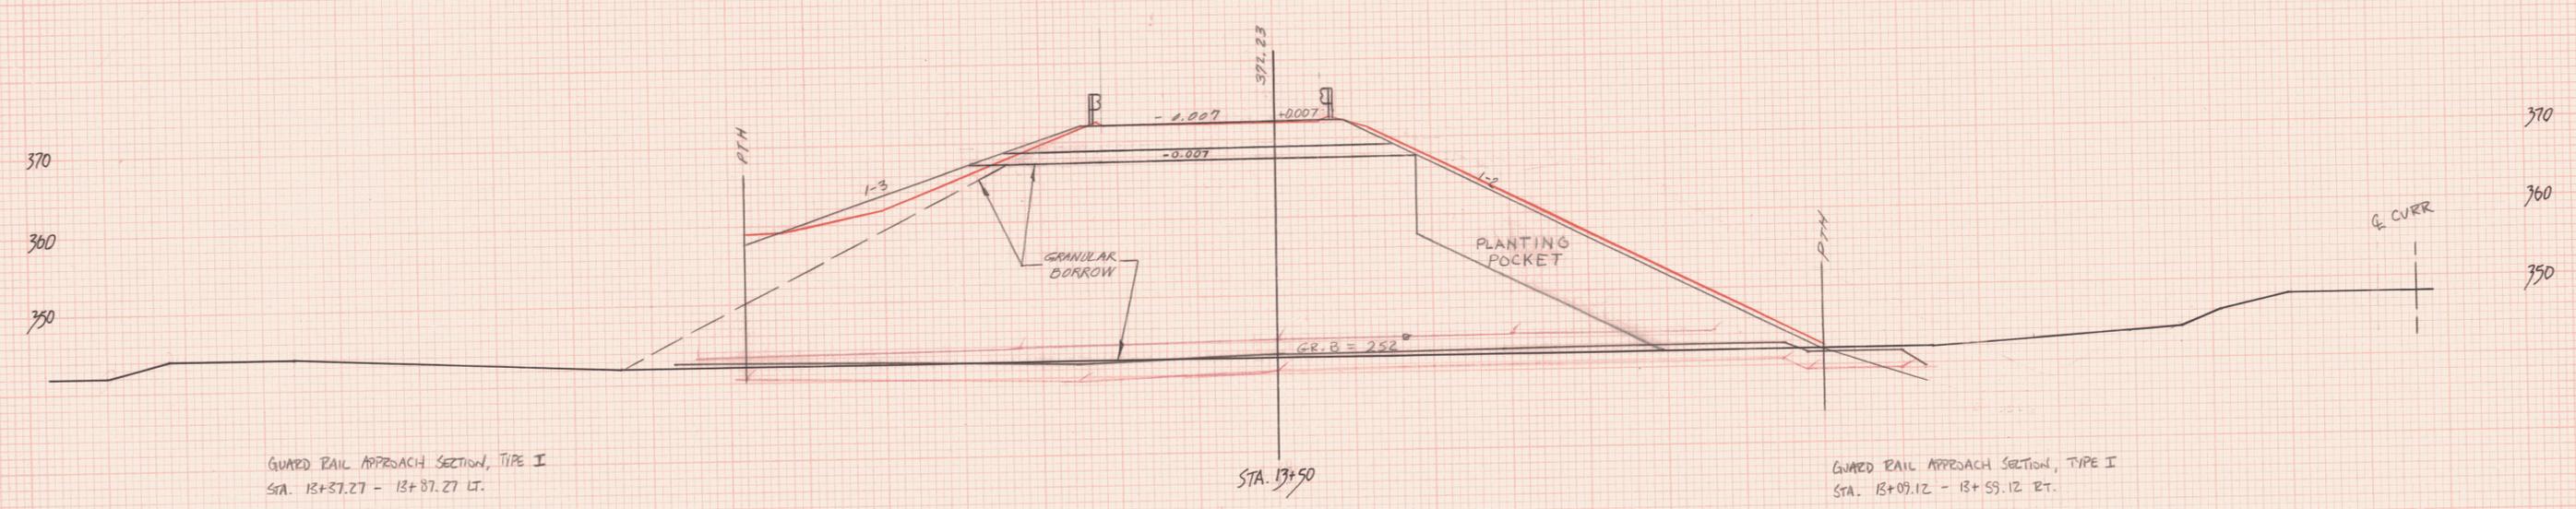



RAMP A
RTE 2A

STA. 13+83.92
END ROADWAY
BEGIN STRUCTURE #6

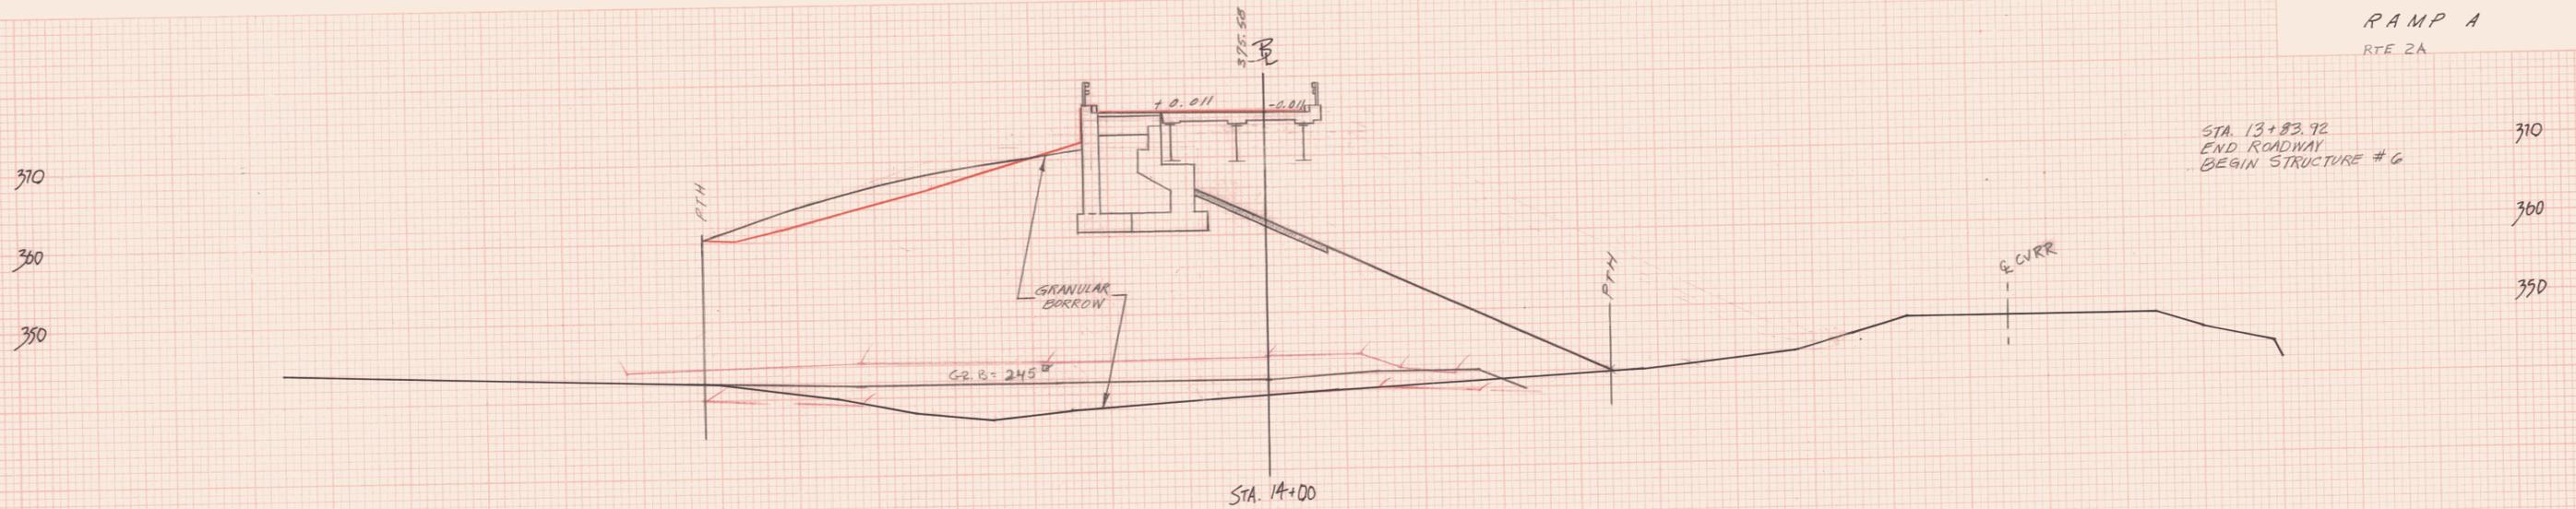

GUARD RAIL APPROACH SECTION, TYPE I
STA. 13+37.27 - 13+87.27 LT.

GUARD RAIL APPROACH SECTION, TYPE I
STA. 13+09.12 - 13+59.12 RT.

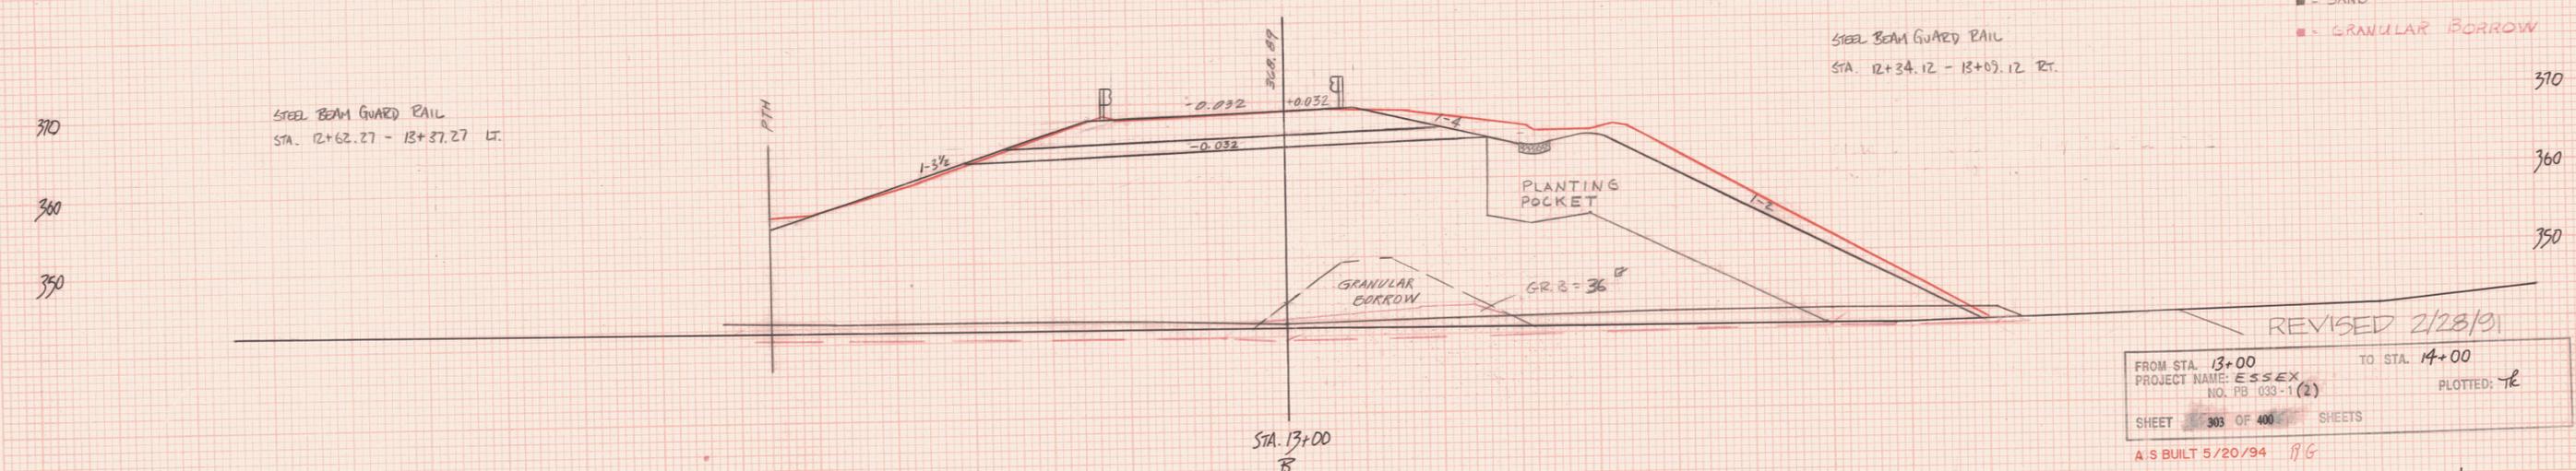

STEEL BEAM GUARD RAIL
STA. 12+62.27 - 13+37.27 LT.

STEEL BEAM GUARD RAIL
STA. 12+34.12 - 13+09.12 RT.

- STRIPPING
- SAND
- GRANULAR BORROW

REVISED 2/28/91

FROM STA. 13+00	TO STA. 14+00
PROJECT NAME: ESSEX	
NO. PB 033-1(2)	
SHEET 303 OF 400 SHEETS	PLOTTED: TR

A S BUILT 5/20/94 196

DATE
BY
FINAL SURVEY
DRAWING
NOTED BOOK
NO.

DATE
BY
ORIGINAL SURVEY
DRAWING
NOTED BOOK
NO.