

RAMP A  
RTE 2A

STA. 17+18.50  
END STRUCTURE  
RESUME ROADWAY

STEEL BEAM GUARD RAIL  
STA. 17+31.83 - 17+56.83 RT.

17+00 - 445+00 RT  
SPECIAL DITCH w/ TYPE II STONE FILL

PLANTING POCKET  
FROM STA 16+75 TO 22+00 RT  
OFFSET FROM TOE OF SAND BORROW  
TO TOE OF SLOPE

GUARD RAIL APPROACH SECTION, TYPE II  
STA. 17+19.33 - 17+31.83 RT.

STEEL BEAM GUARD RAIL  
STA. 17+31.83 - 17+56.83 LT.

GUARD RAIL APPROACH SECTION, TYPE II  
STA. 17+19.33 - 17+31.83 LT.

E. CURB

E. CURB

■ = SAND  
■ = GRANULAR BORROW

REVISED 2/28/91

FROM STA. 16+00 TO STA. 17+00  
PROJECT NAME: ESSEX  
NO. PB: 033-1 (2) PLOTTED: JL  
SHEET 305 OF 400 SHEETS

BUILT AS DESIGNED 5/20/94 198

STA. 16+00

STA. 17+00

STA. 16+50

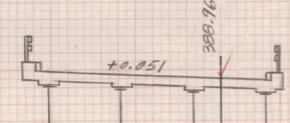
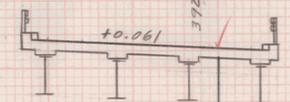
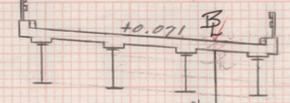


PLATE 3-FULL CROSS SECTION-FULL LINE