


RAMP A  
RTE 2A

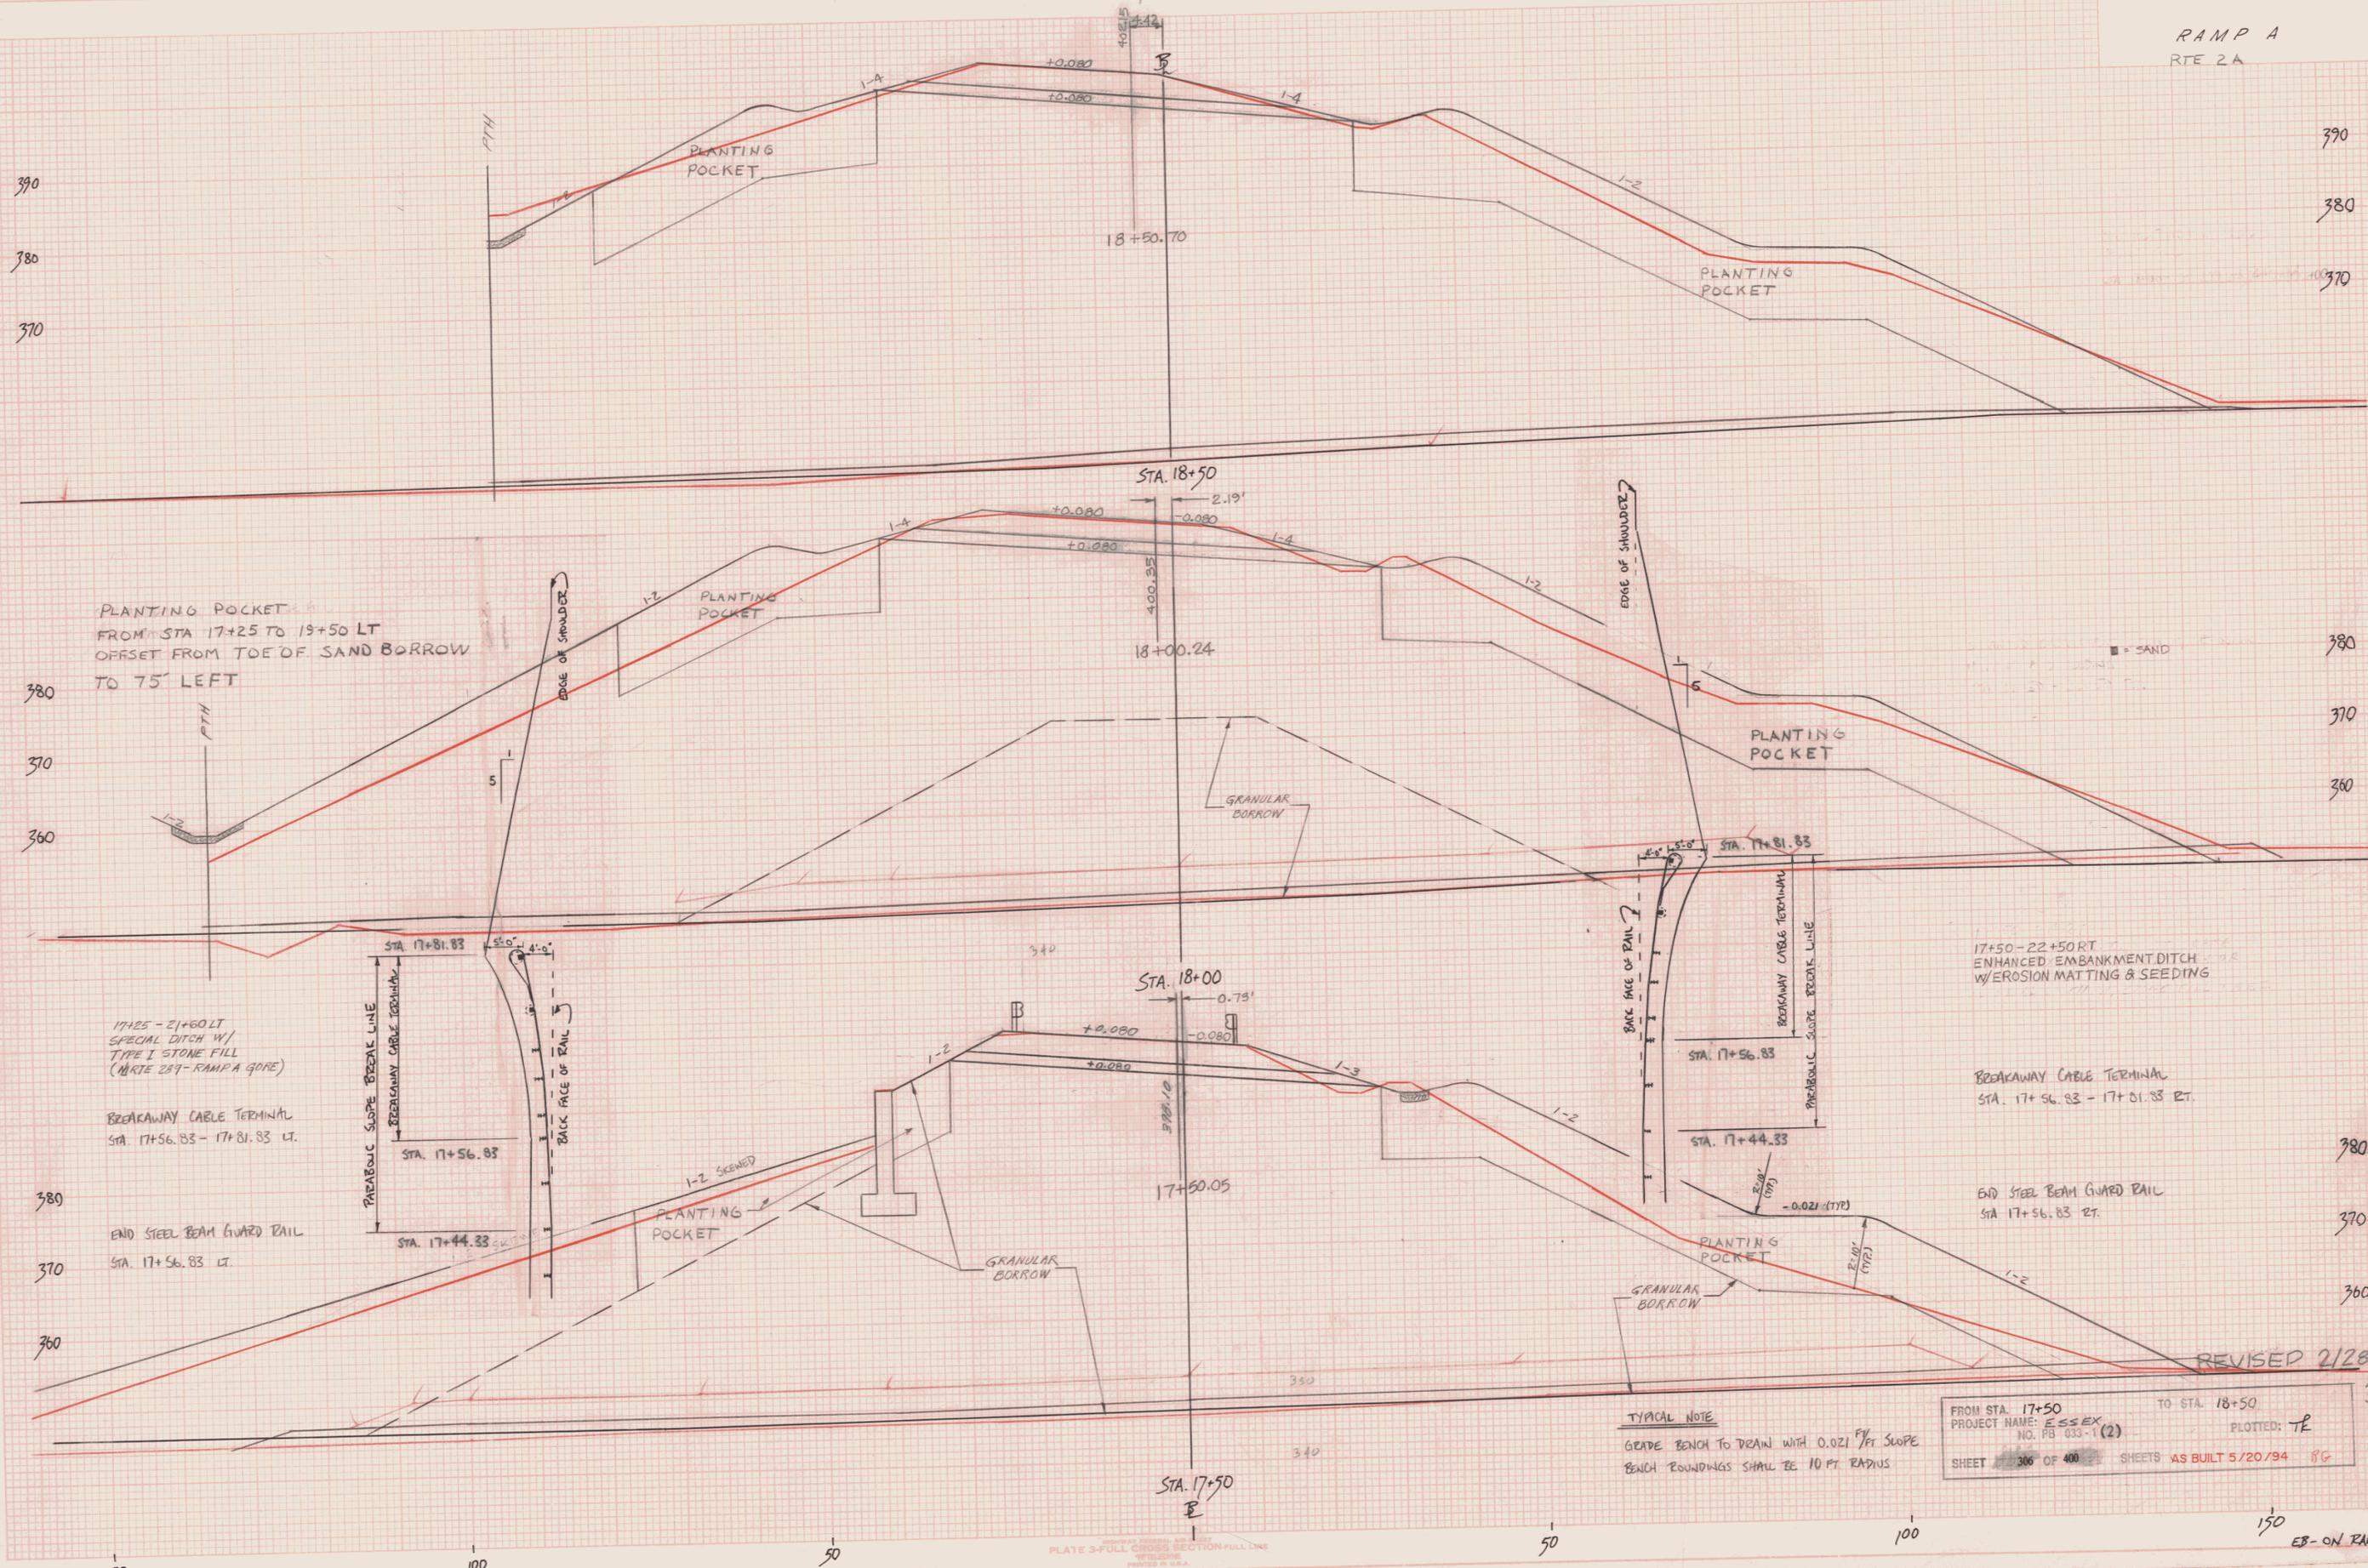

PLANTING POCKET  
FROM STA 17+25 TO 19+50 LT  
OFFSET FROM TOE OF SAND BORROW  
TO 75' LEFT

17+25 - 21+60 LT  
SPECIAL DITCH W/  
TYPE I STONE FILL  
(ROUTE 289 - RAMP A GORE)

BREAKAWAY CABLE TERMINAL  
STA. 17+56.83 - 17+81.83 LT.

END STEEL BEAM GUARD RAIL  
STA. 17+56.83 LT.

17+50 - 22+50 RT  
ENHANCED EMBANKMENT DITCH  
W/ EROSION MATTING & SEEDING

BREAKAWAY CABLE TERMINAL  
STA. 17+56.83 - 17+81.83 RT.

END STEEL BEAM GUARD RAIL  
STA 17+56.83 RT.

TYPICAL NOTE  
GRADE BENCH TO DRAW WITH 0.021 FT/FT SLOPE  
BENCH ROUNDINGS SHALL BE 10 FT. RADIUS

FROM STA. 17+50 TO STA. 18+50  
PROJECT NAME: ESSEX  
NO. PB 033-1(2)  
SHEET 306 OF 400 SHEETS AS BUILT 5/20/94 86  
PLOTTED: TE

REVISED 2/28/91

INV. 346.0

150  
EB - ON RAMP

353 D.F. 145

FINAL SURVEY PLOTTED: [ ]  
NOTE BOOK: [ ]  
NO. [ ]

ORIGINAL SURVEY PLOTTED: [ ]  
NOTE BOOK: [ ]  
NO. [ ]

ROADWAY FEDERAL HIGHWAY  
PLATE 3-FULL CROSS SECTION-FULL LINE  
PRINTED IN U.S.A.