


RAMP A
RTE 2A

FINAL SURVEY DATE
BY
REVISIONS
PLANNED
NOTE BOOK NO.
TEMPERATURE
NO.
ANALYZED

ORIGINAL SURVEY DATE
BY
REVISIONS
PLANNED
NOTE BOOK NO.
TEMPERATURE
NO.
ANALYZED

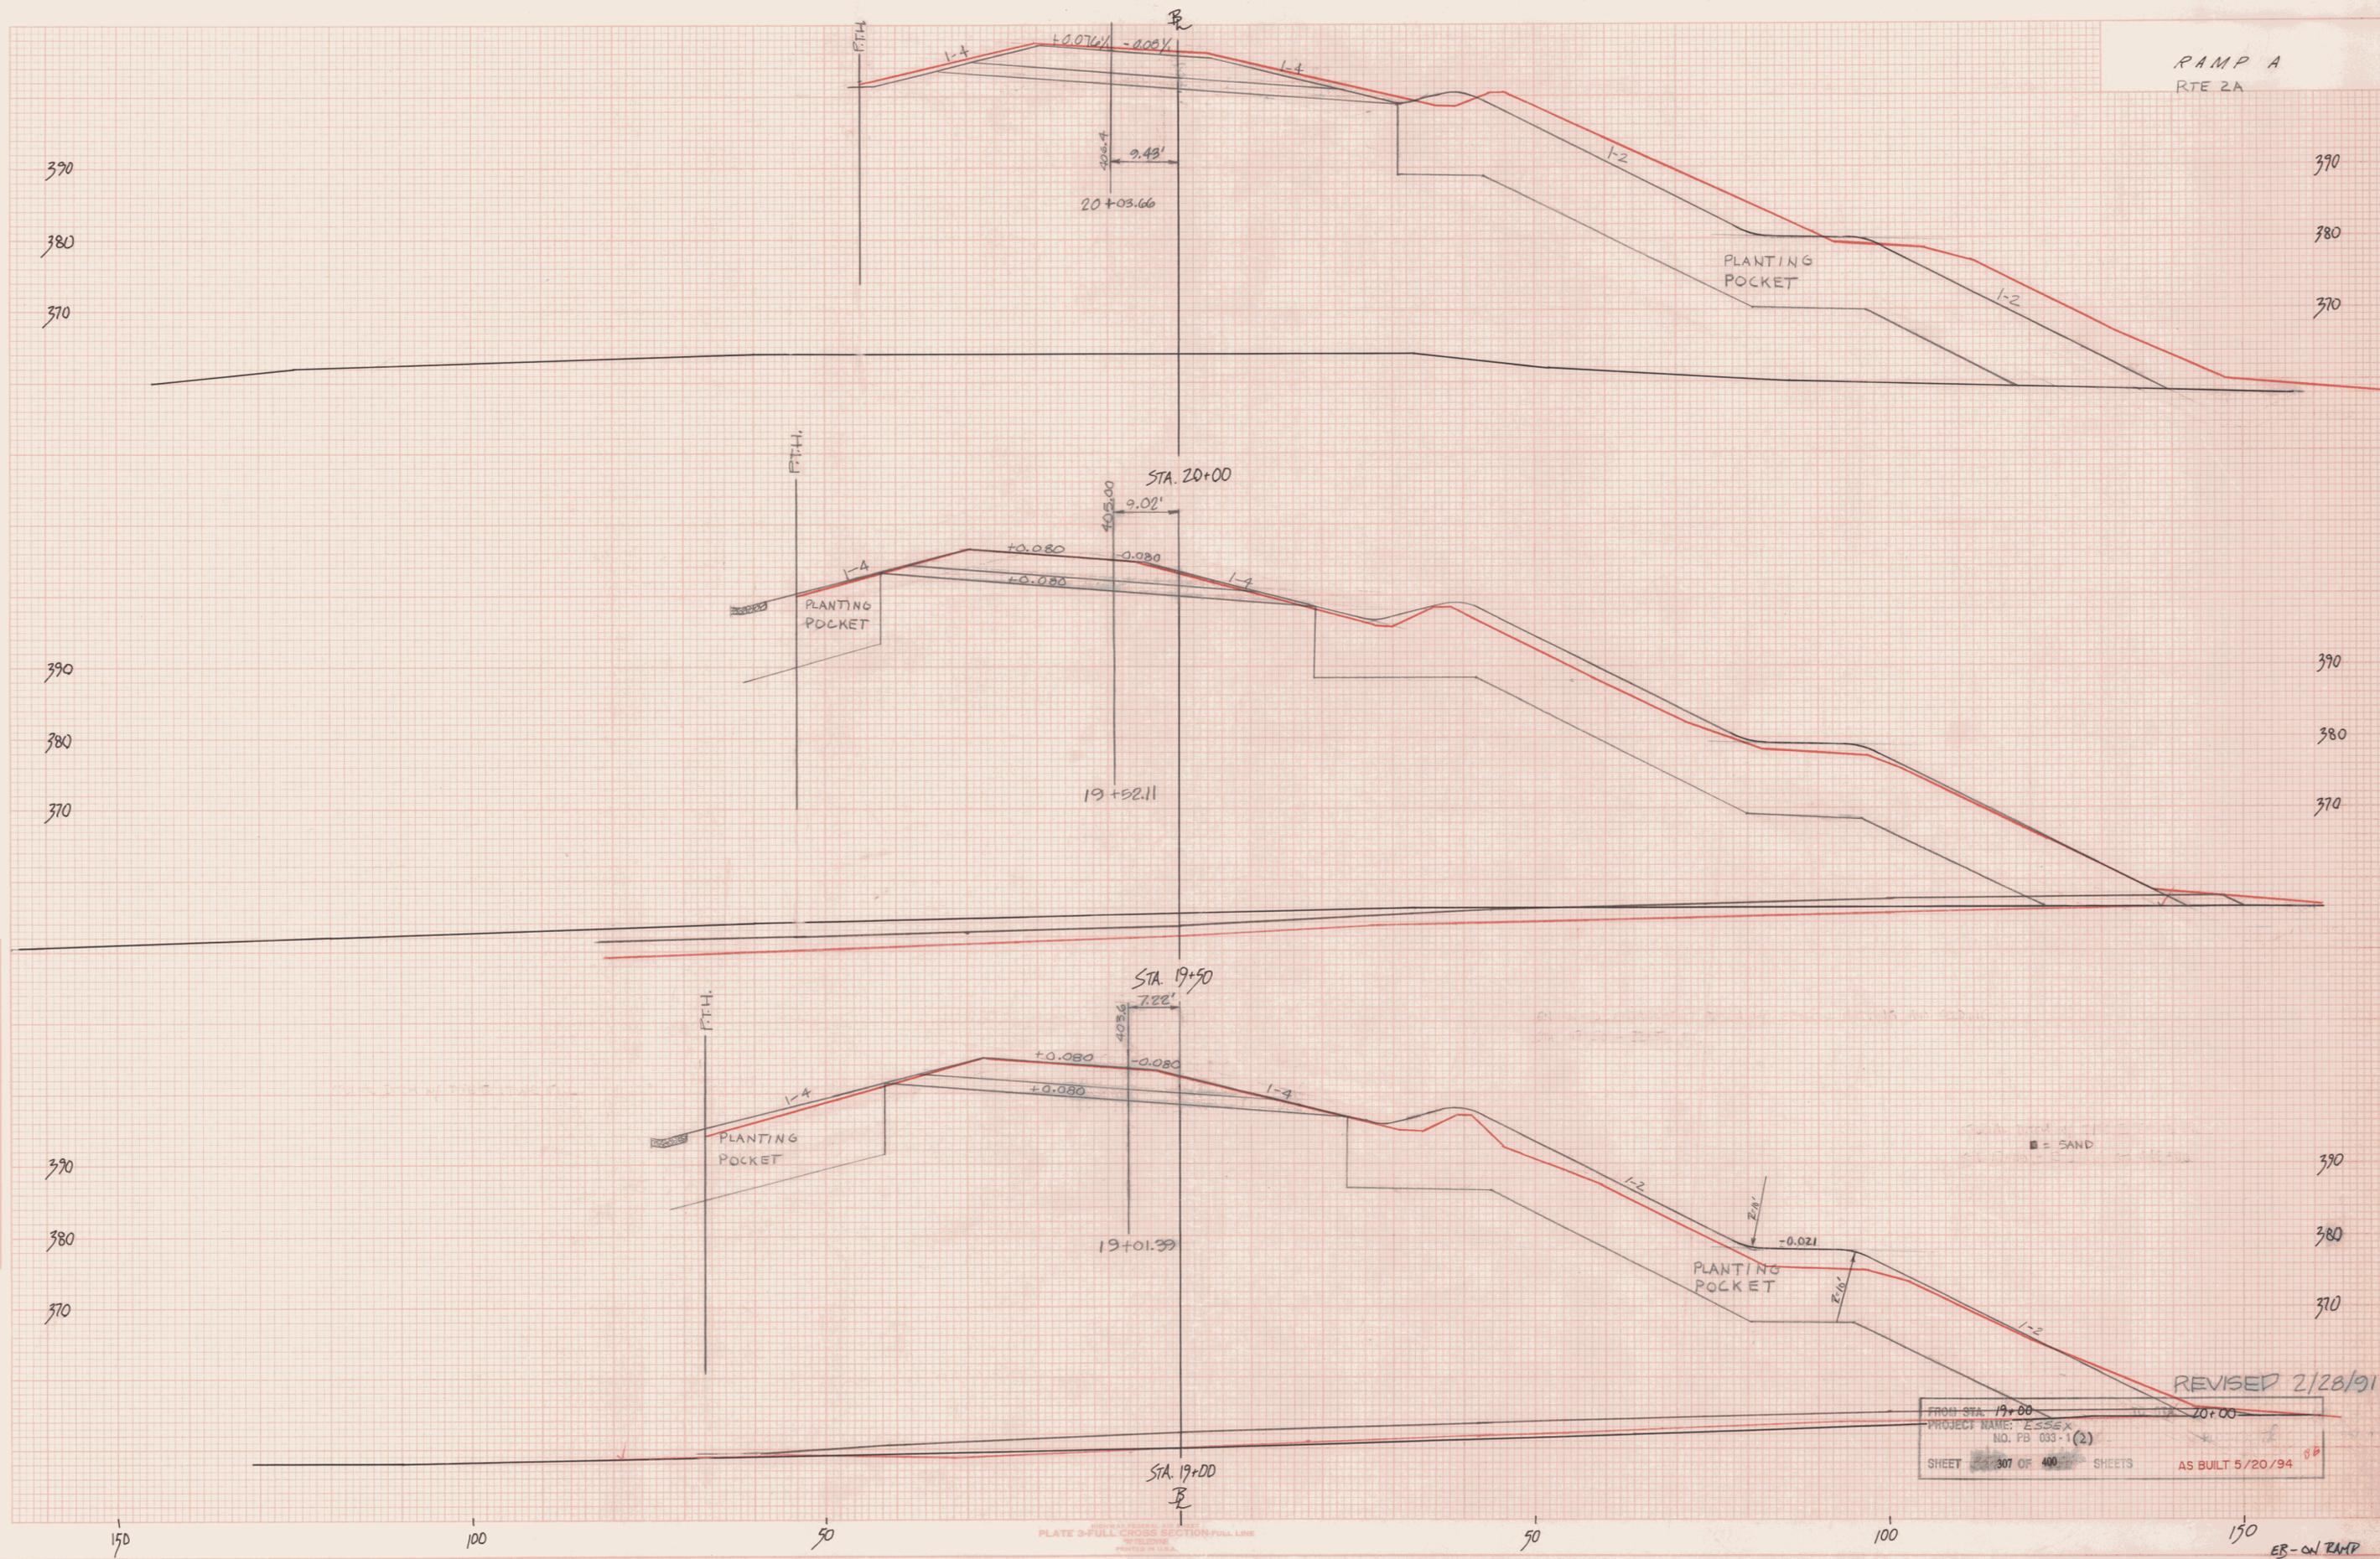

FROM STA. 19+00 TO STA. 20+00
PROJECT NAME: ESSEX
NO. PB 033-1(2)
SHEET 307 OF 400 SHEETS AS BUILT 5/20/94

REVISED 2/28/91

PLATE 3-FULL CROSS SECTION-FULL LINE
PRINTED IN U.S.A.