


RAMP A
RTE 2A

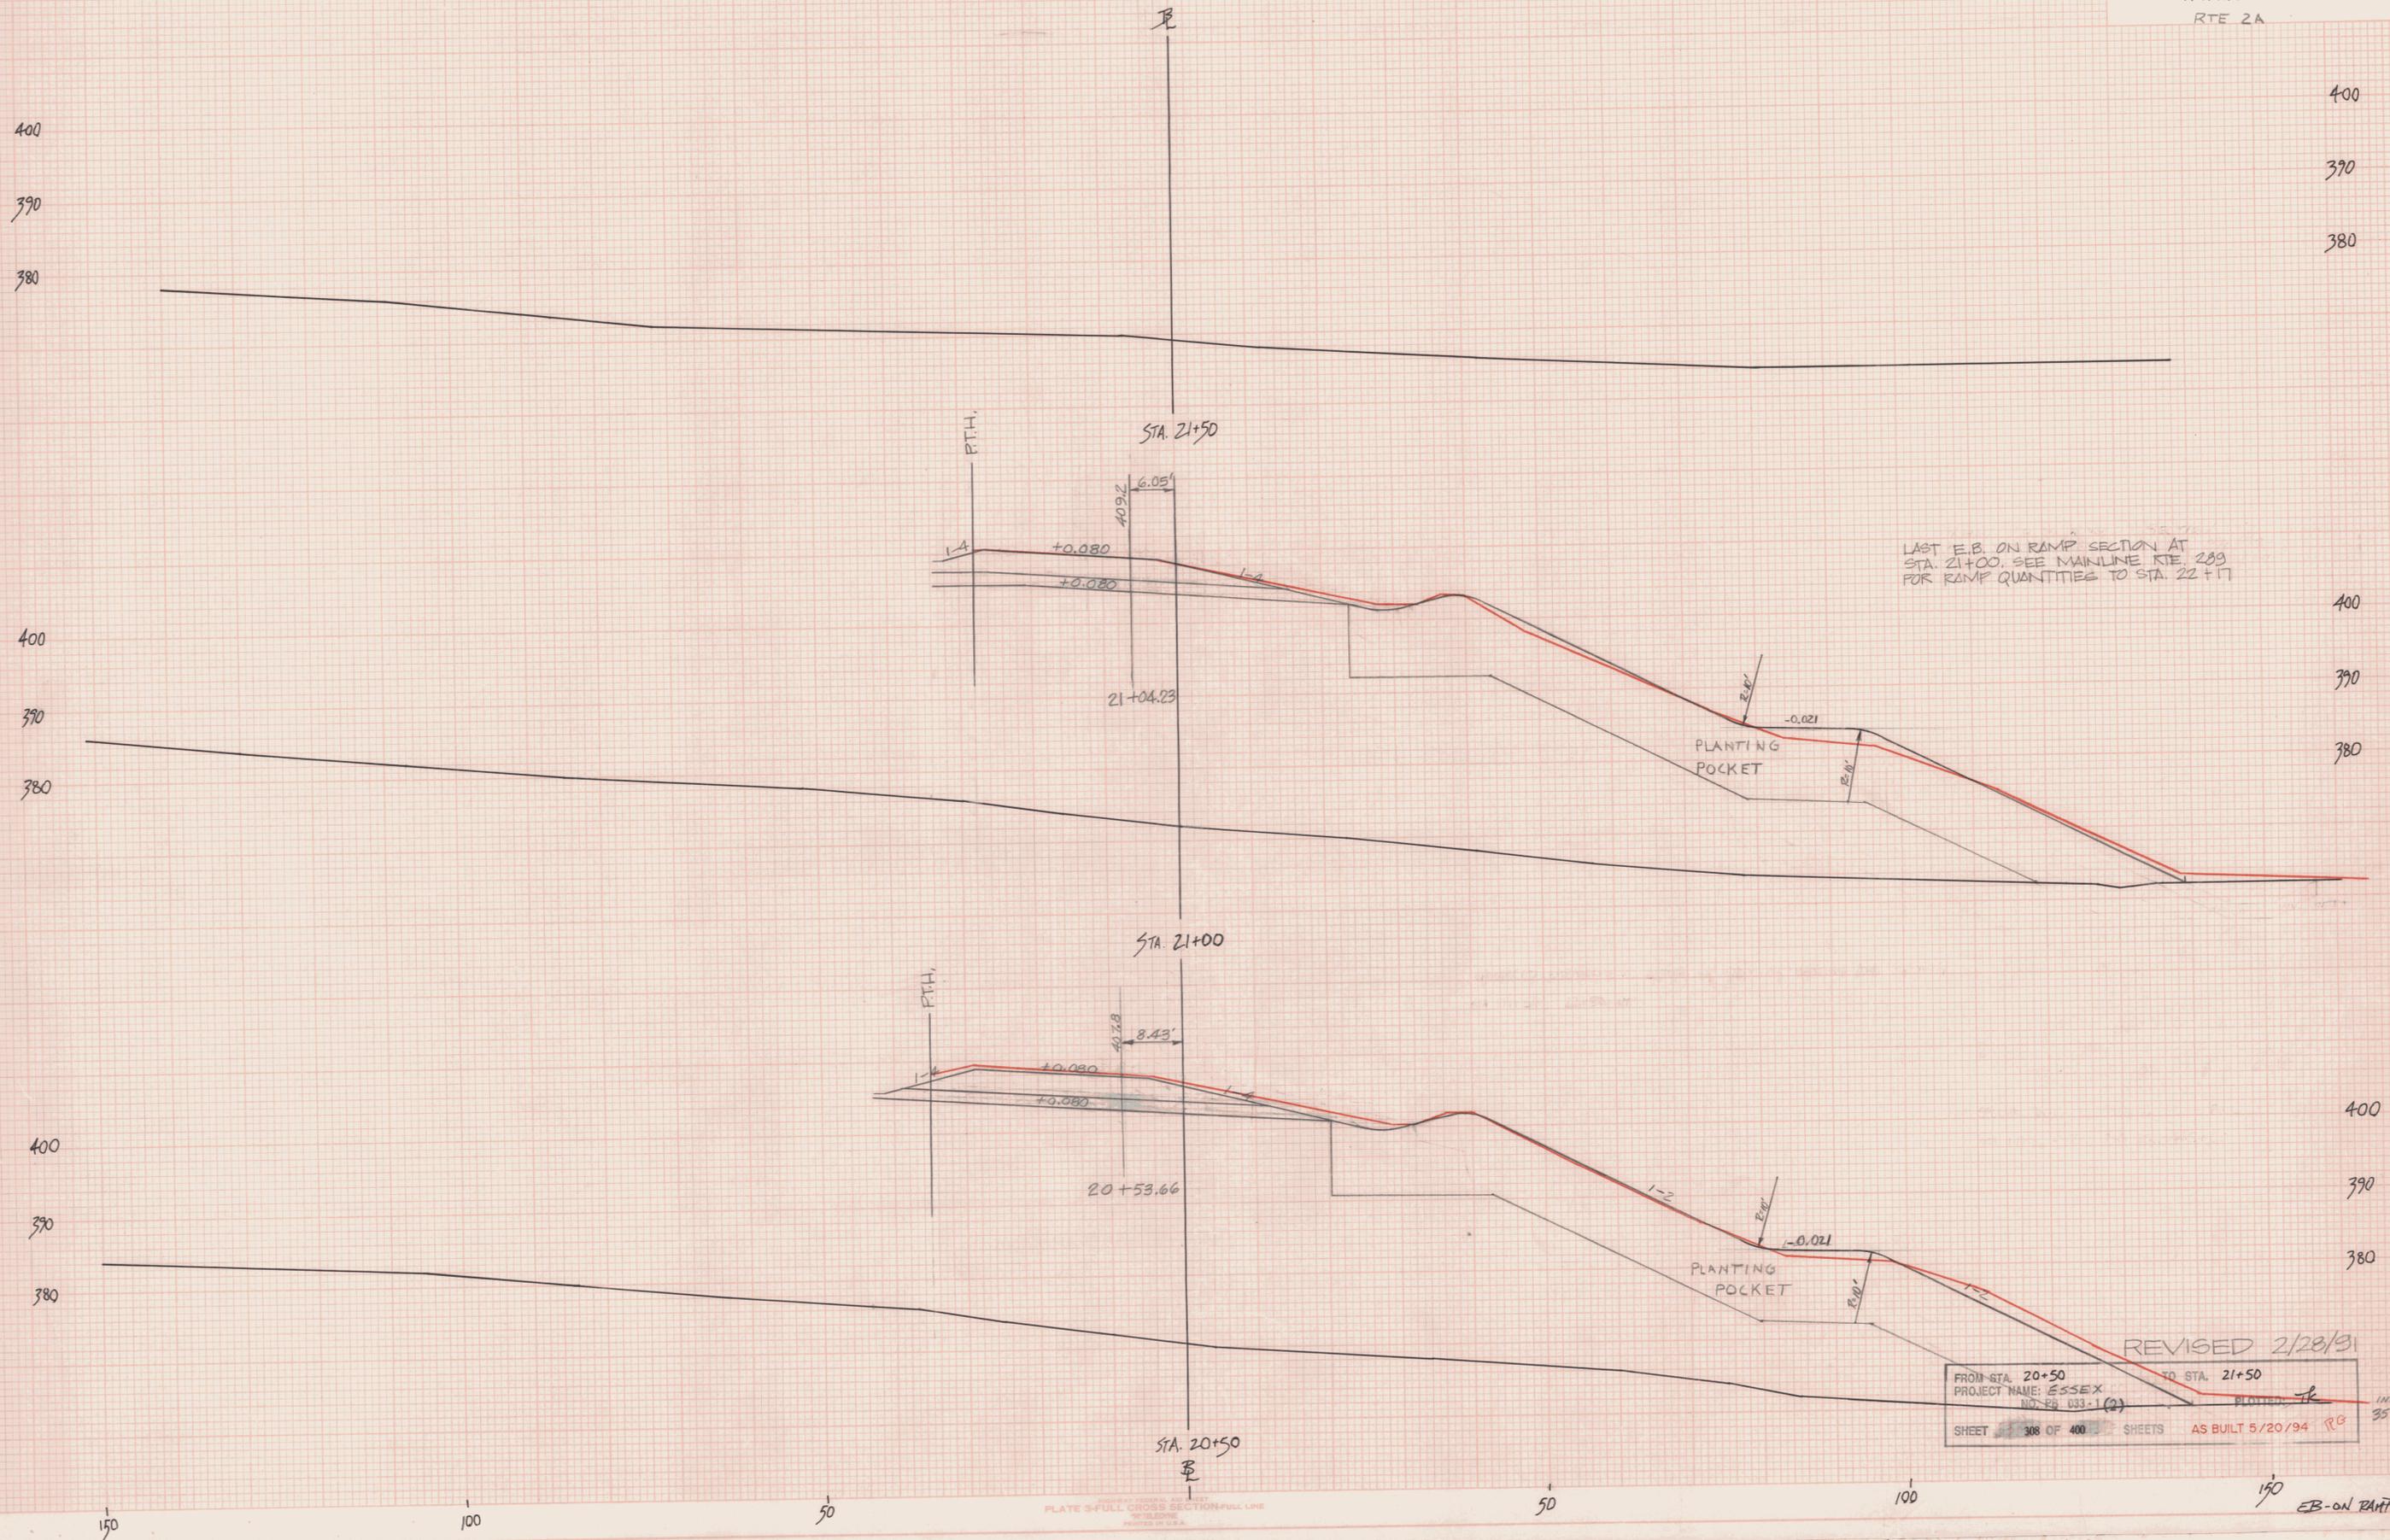

FINAL
SURVEY
ROUTE BOOK
NO.

ORIGINAL
SURVEY
ROUTE BOOK
NO.

ROADWAY FEDERAL AGENT
PLATE 3-FULL CROSS SECTION-FULL LINE
SCALE
PRINTED IN U.S.A.