

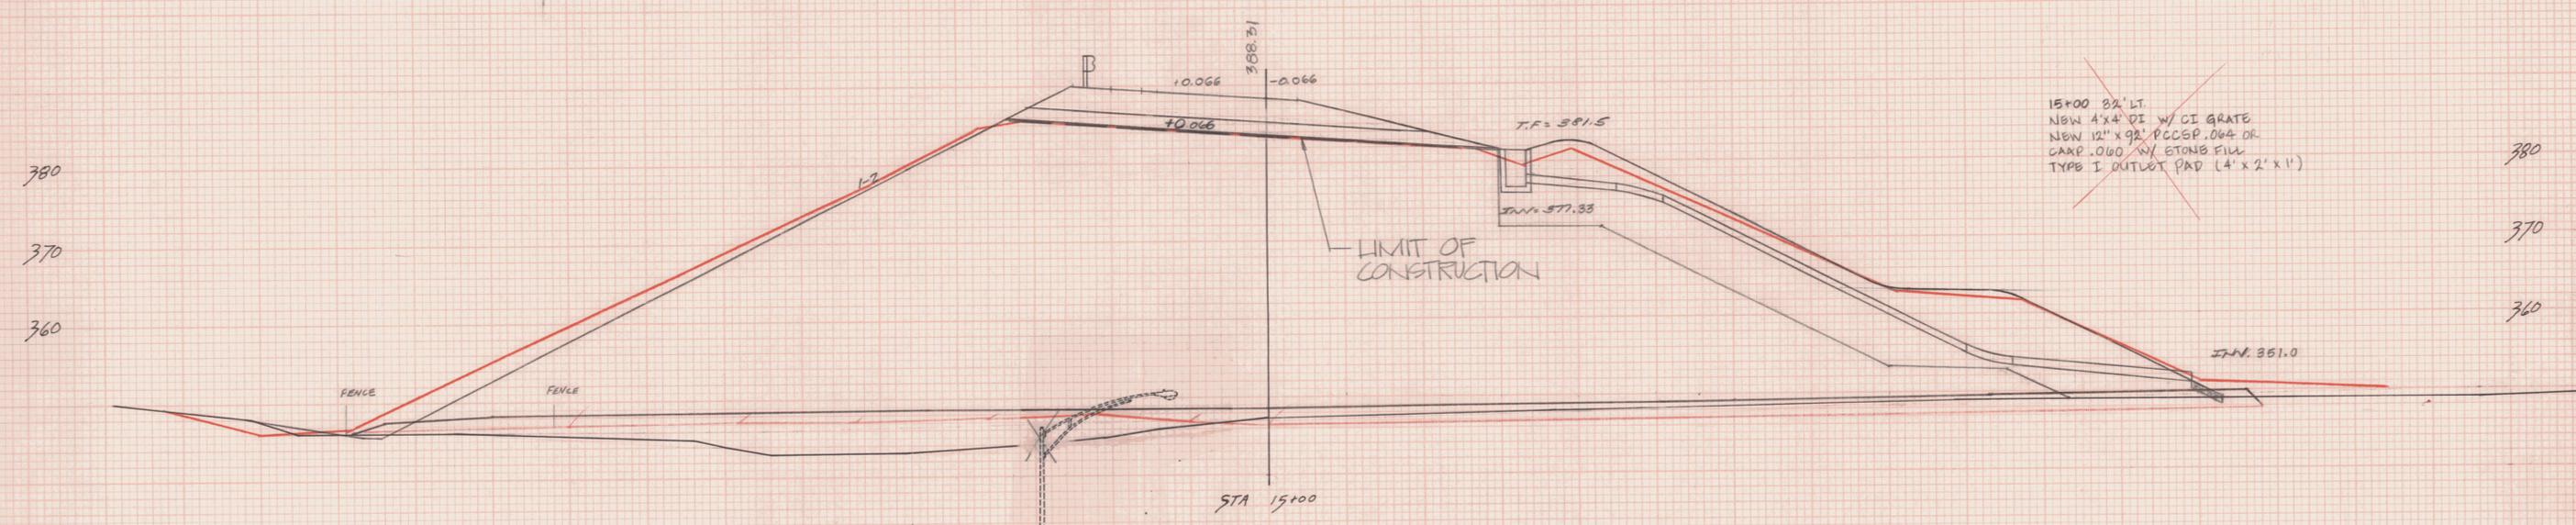


RAMP B
RTE 2A

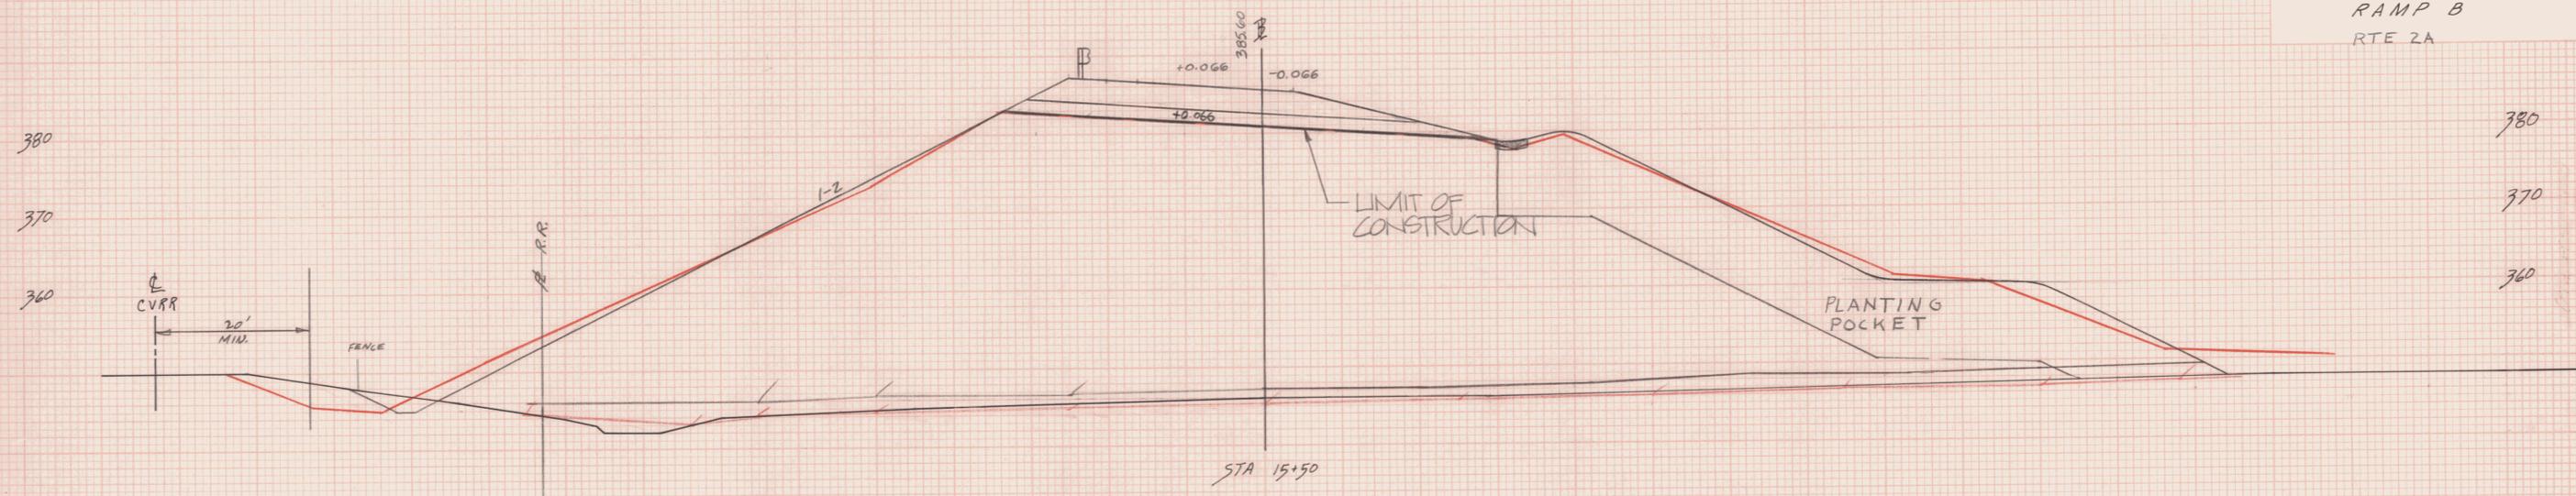

15'x00 32' LT.
NEW 4'x4' DI W/ CI GRATE
NEW 12" x 9" PCCSP.064 OR
CAMP.060 W/ STONE FILL
TYPE I OUTLET PAD (4' x 2' x 1')

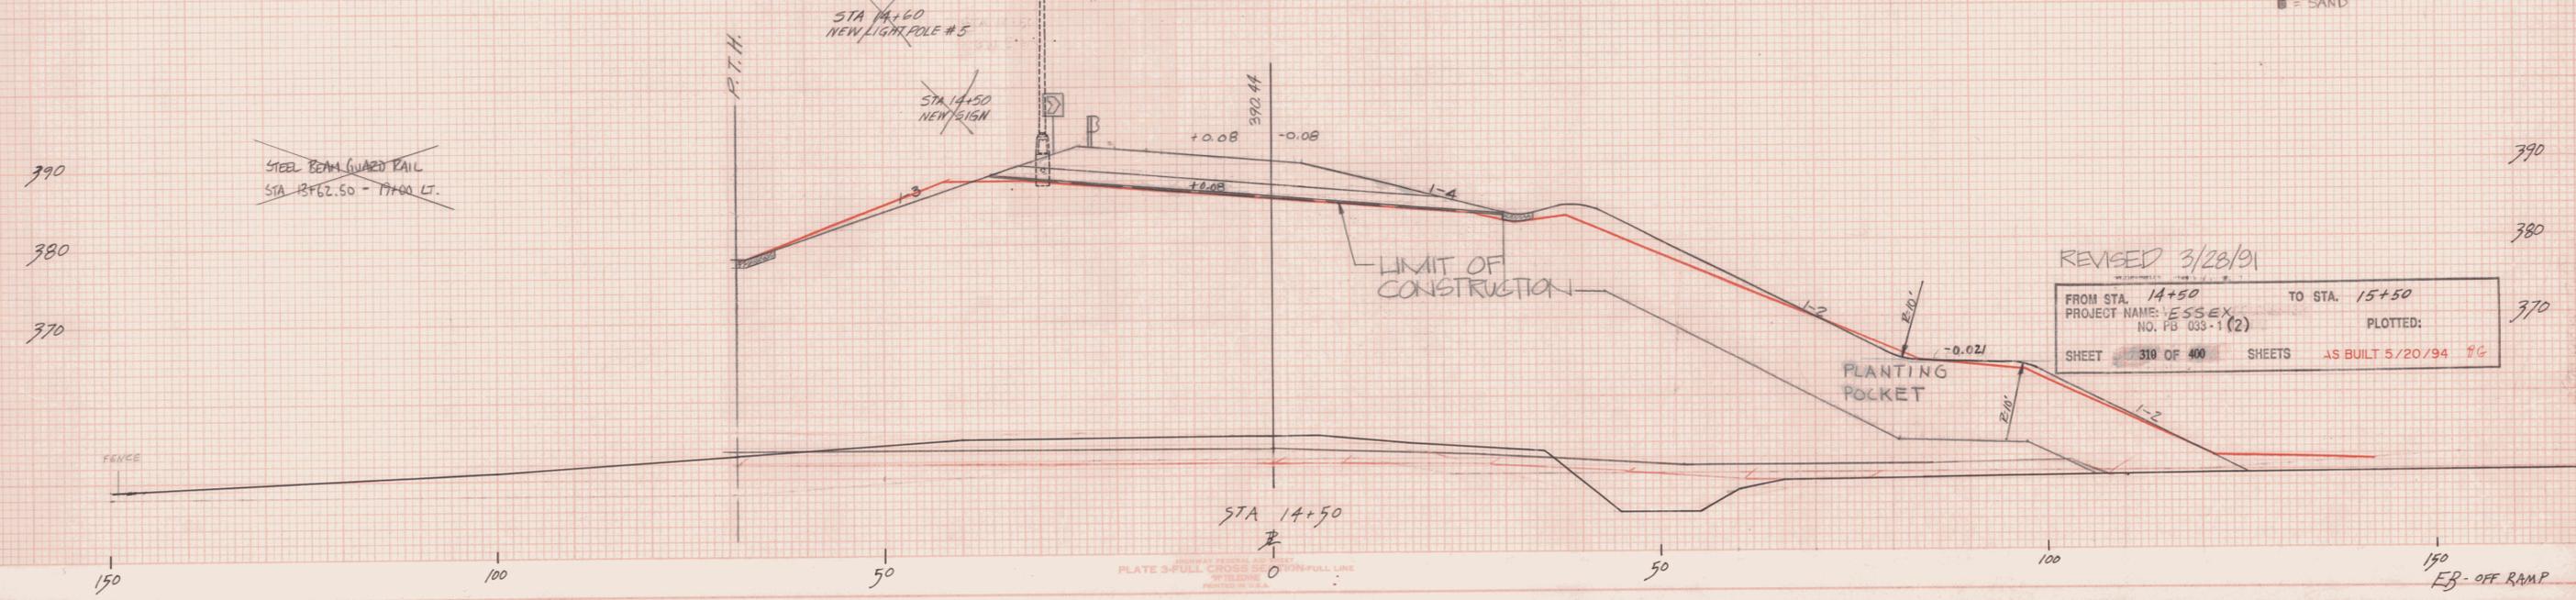

REVISED 3/28/91
FROM STA. 14+50 TO STA. 15+50
PROJECT NAME: ESSEX
NO. PB 033-1 (2) PLOTTED:
SHEET 310 OF 400 SHEETS AS BUILT 5/20/94 96

PLATE 3-FULL CROSS SECTION ON FULL LINE
PRINTED IN U.S.A.

FINAL SURVEY
DATE: _____
BY: _____
CHECKED: _____
DATE: _____

ORIGINAL SURVEY
DATE: _____
BY: _____
CHECKED: _____
DATE: _____