


RAMP B
RTE 2A

17+00-20+00 RT
ENHANCED EMBANKMENT DITCH
W/ TYPE I STONE FILL

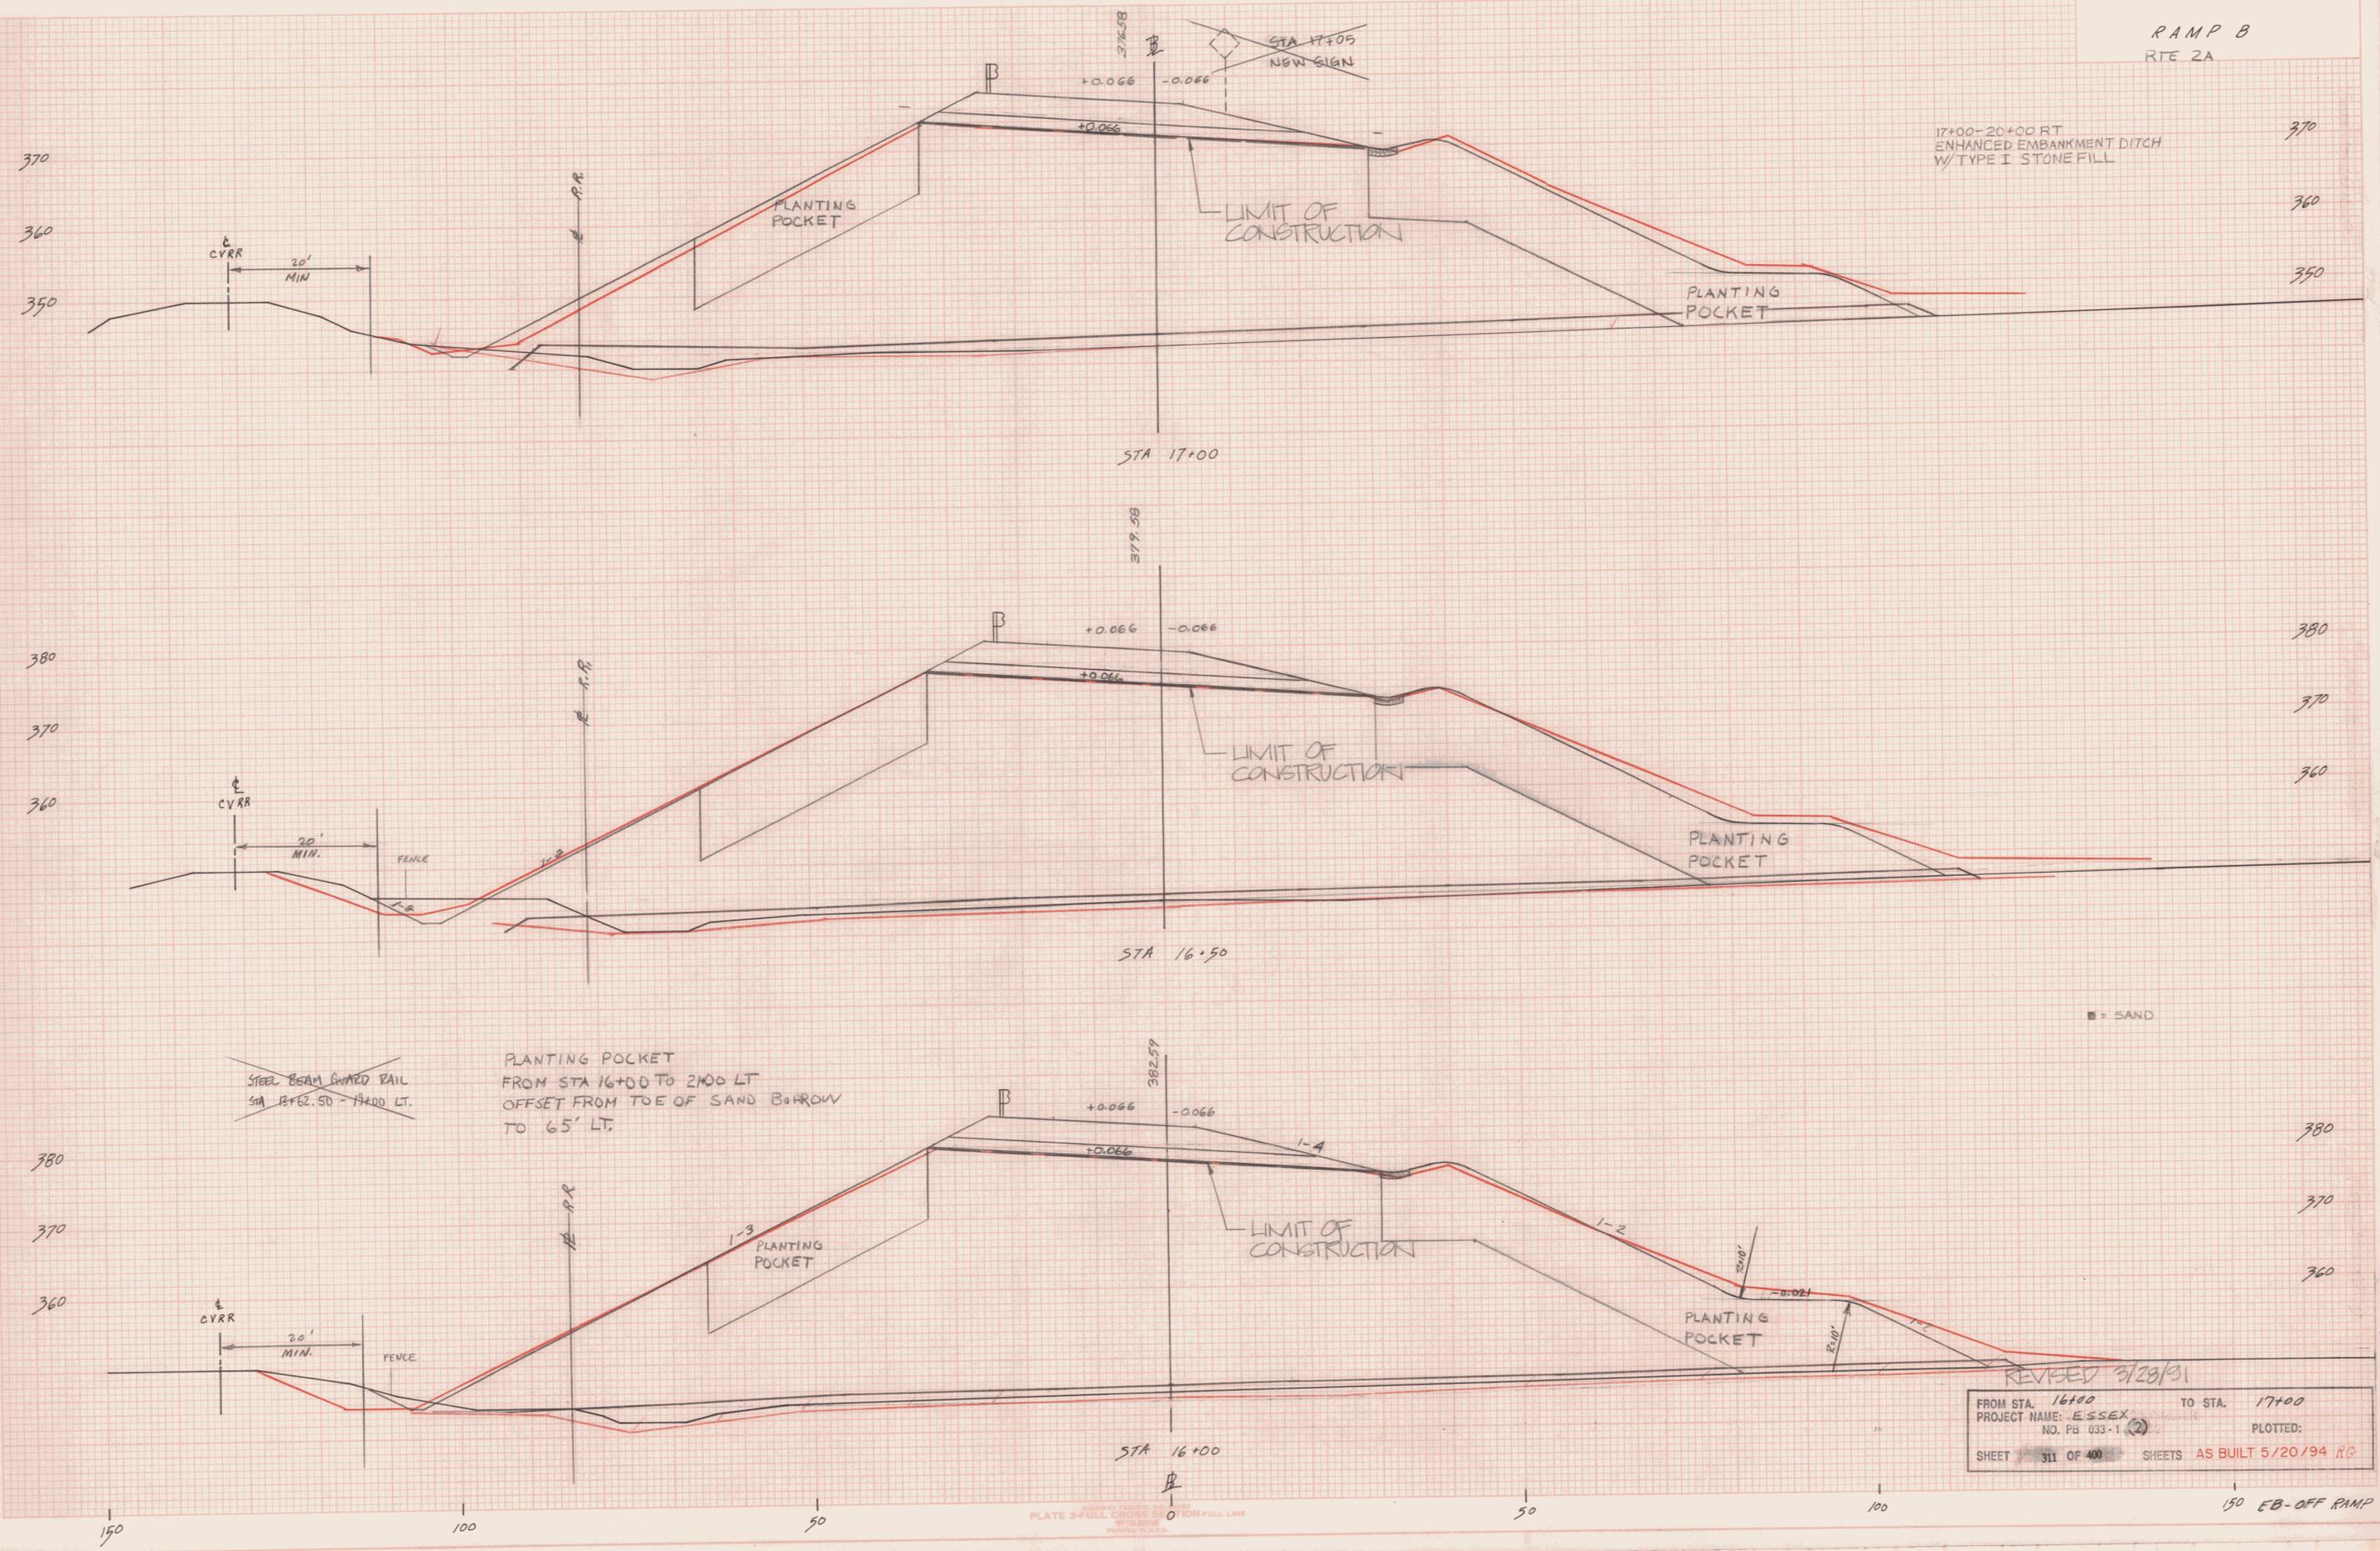

PLANTING POCKET
FROM STA 16+00 TO 2100 LT
OFFSET FROM TOE OF SAND BARRROW
TO 65' LT.

STEEL BEAM GUARD RAIL
STA 16+2.50 - 16+00.00

REVISED 3/28/31

FROM STA. 16+00	TO STA. 17+00
PROJECT NAME: ESSEX	
NO. PG 033-1 (2)	
PLOTTED:	
SHEET 311 OF 400	SHEETS AS BUILT 5/20/94 RG

150 EB-OFF RAMP

DATE
BY
ORIGINAL SURVEY
SURVEY
NOTE BOOK
NO.

DATE
BY
ORIGINAL SURVEY
SURVEY
NOTE BOOK
NO.

PLATE 3-FULL CROSS SECTION-FULL LINE
PRINTED IN U.S.A.