
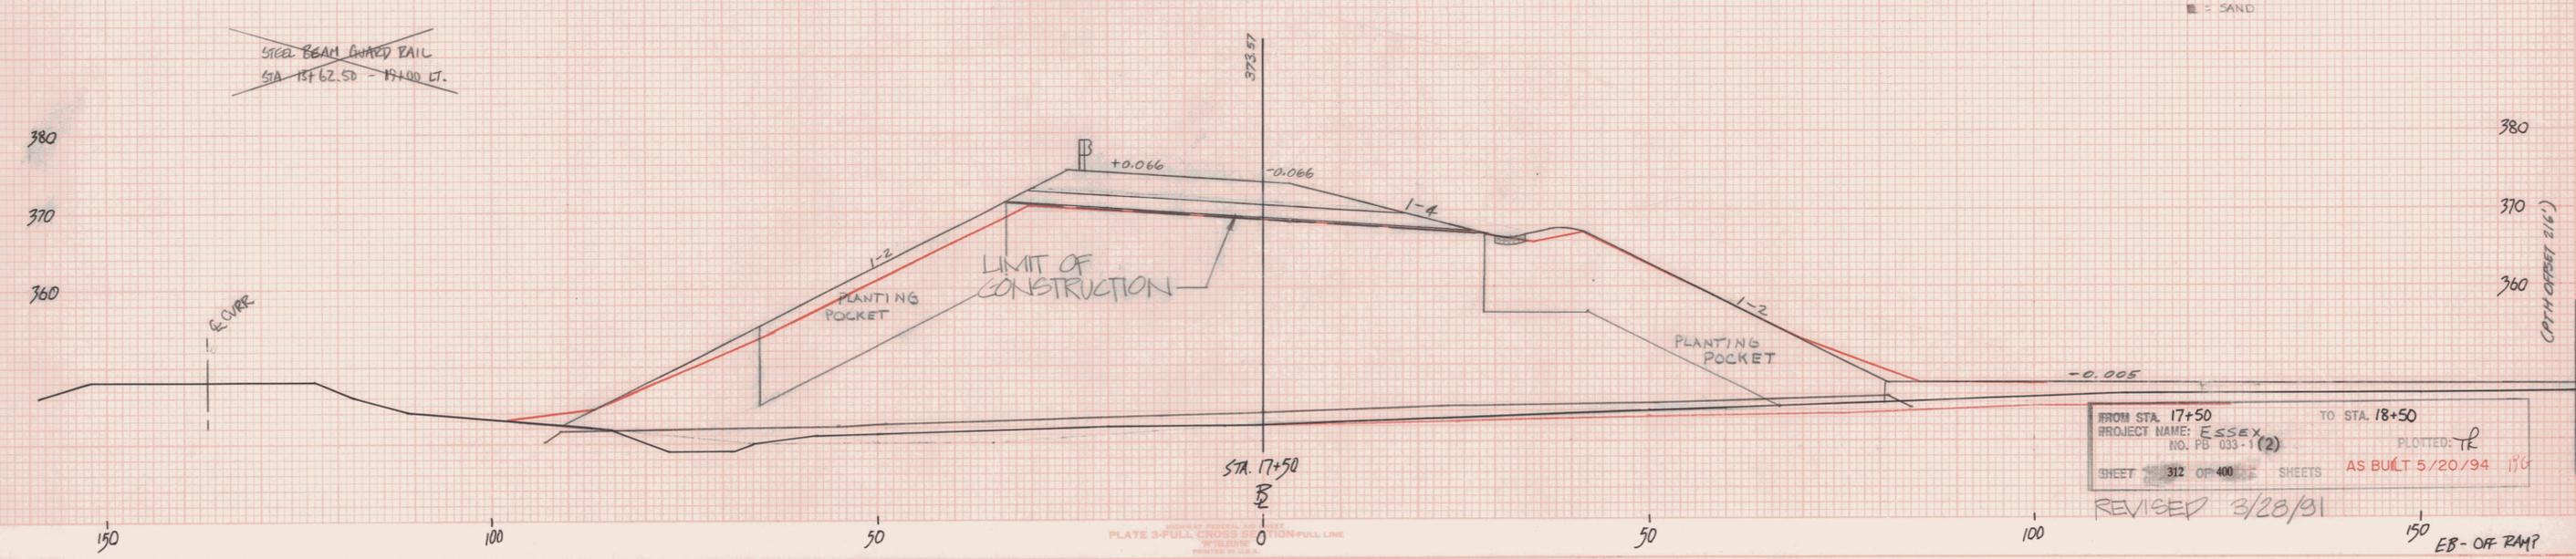
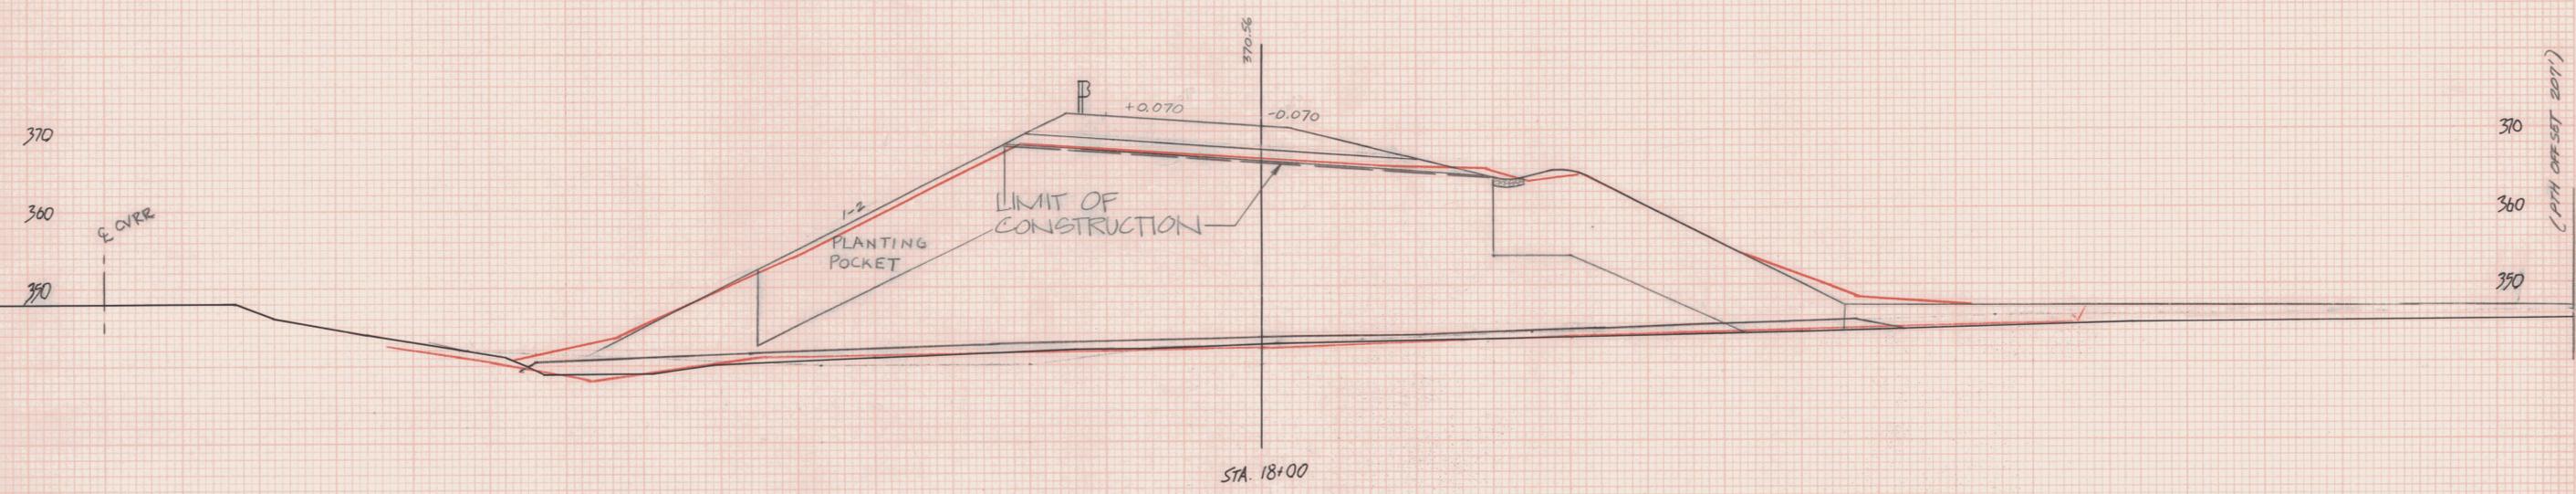


RAMP B
RTE 2A

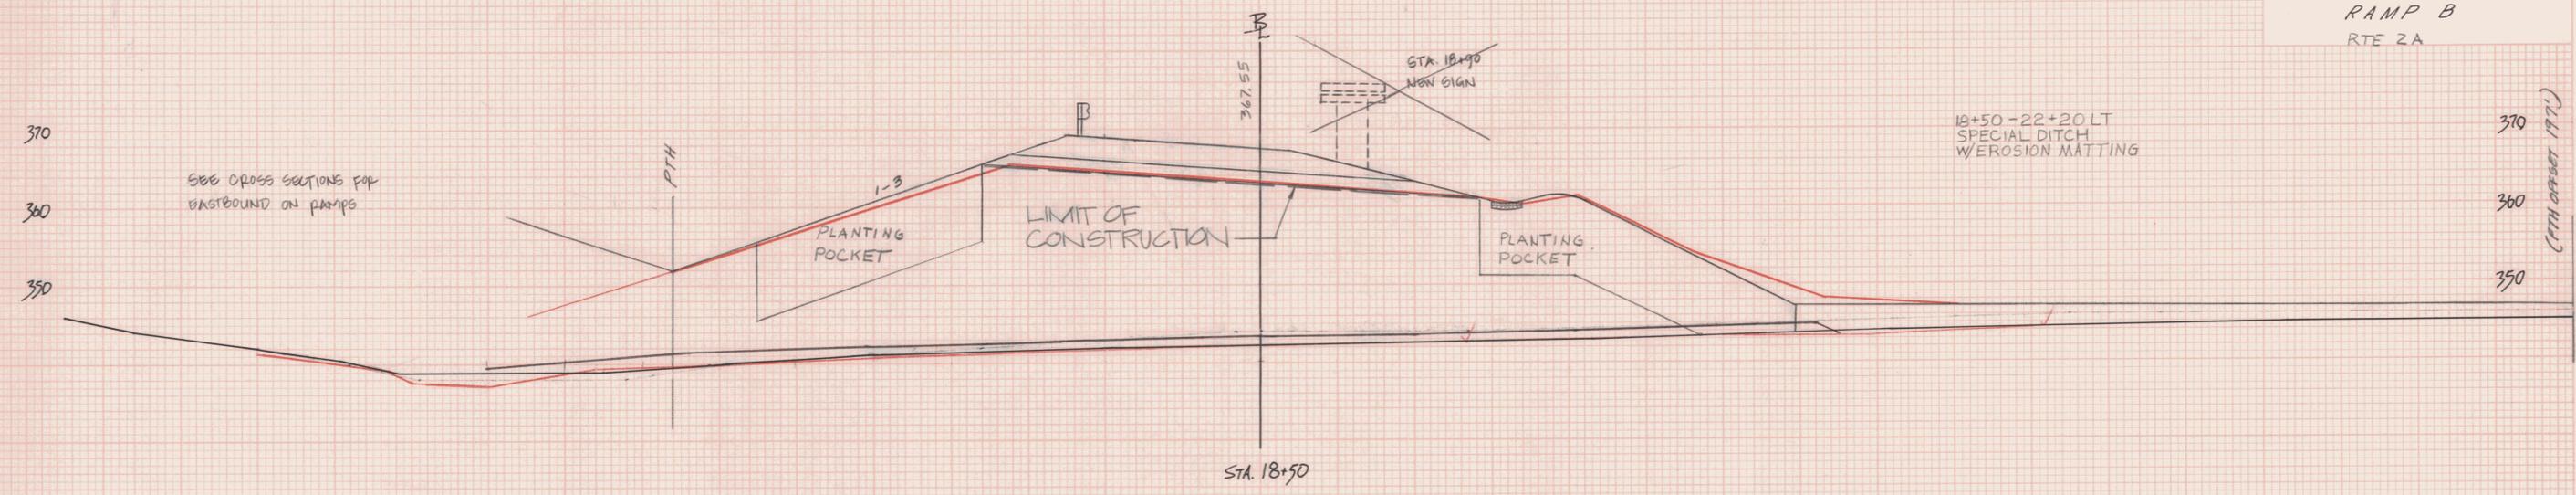

FROM STA. 17+50 TO STA. 18+50
 PROJECT NAME: ESSEX
 NO. FB 033-1 (2)
 SHEET 312 OF 400 SHEETS AS BUILT 5/20/94 176
 PLOTTED: TR
 REVISED 3/28/91
 EB - OFF RAMP?

FINAL SURVEY
 DATE: _____
 BY: _____
 CHECKED: _____
 APPROVED: _____

ORIGINAL SURVEY
 DATE: _____
 BY: _____
 CHECKED: _____
 APPROVED: _____