


RAMP B
RTE 2A
STA 20+17
PAVEMENT WIDTH BEGINS TO INCREASE
ON A 100' TAPER ALONG THE LEFT EDGE
FROM 10' TO 24' AT STA. 21+85

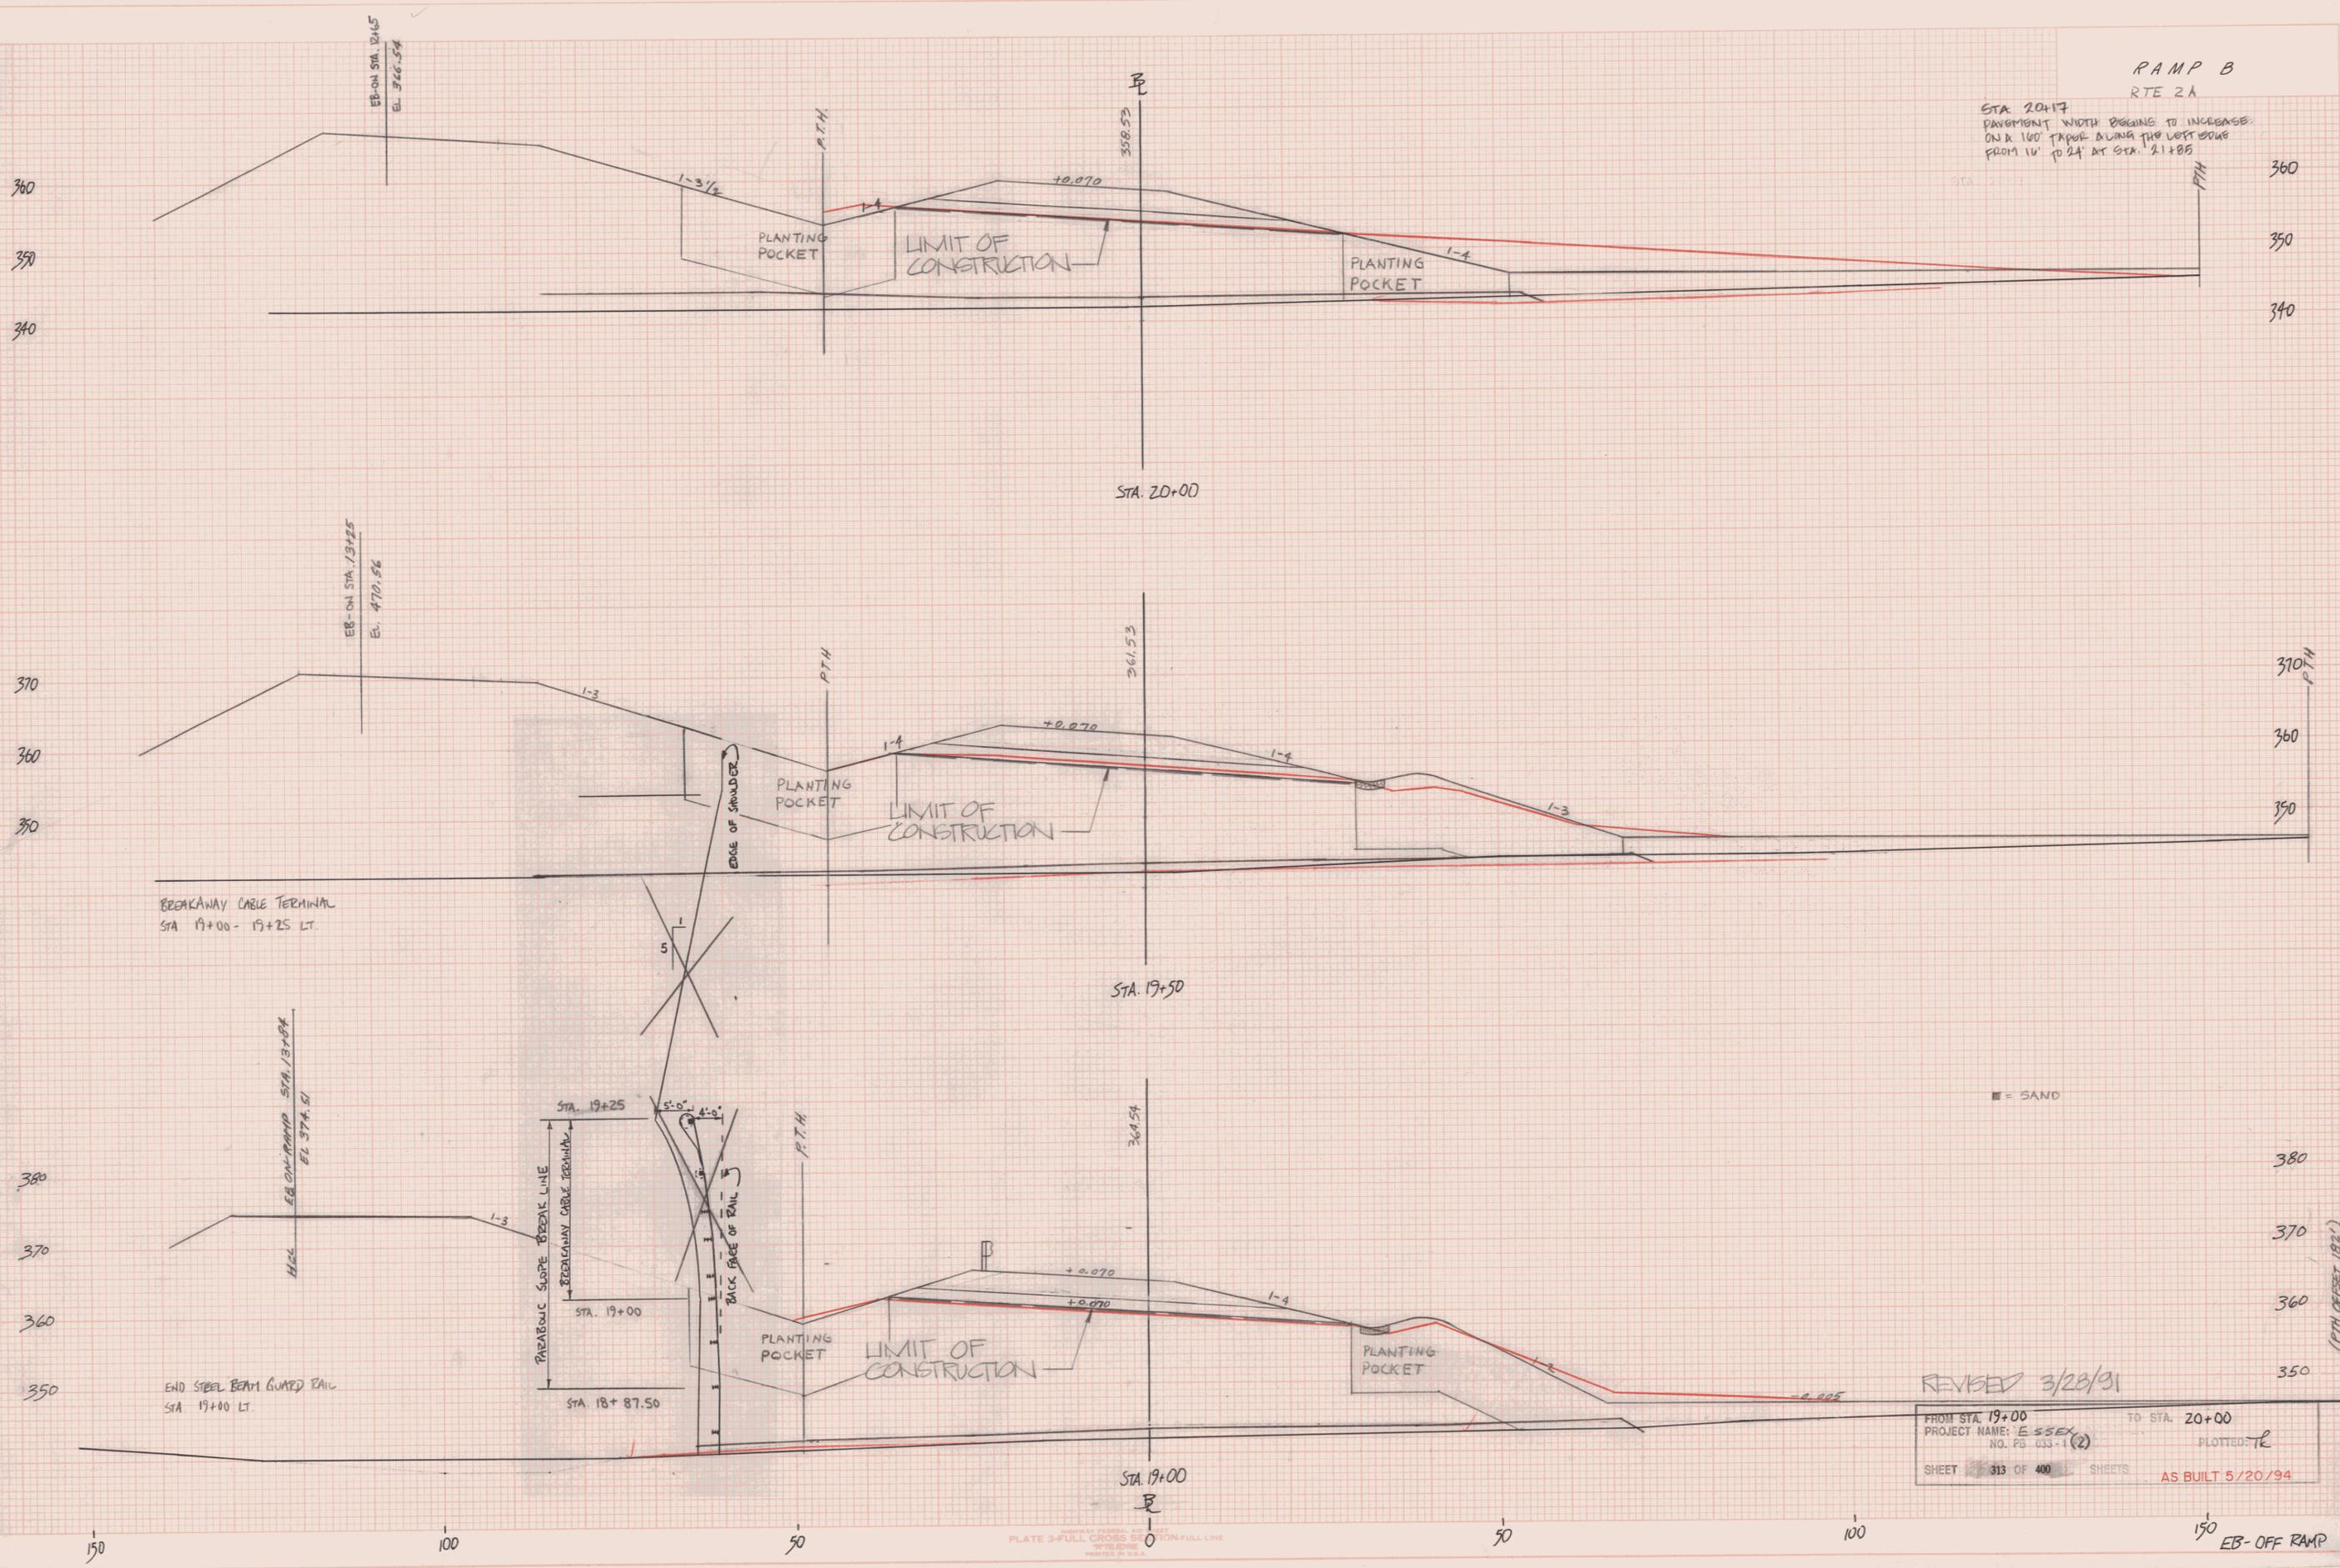

DATE
BY
REVISIONS
NO. DATE
BY
REVISIONS
NO. DATE
BY
REVISIONS
NO. DATE

DATE
BY
REVISIONS
NO. DATE
BY
REVISIONS
NO. DATE

REVISED 3/28/91
FROM STA 19+00 TO STA: 20+00
PROJECT NAME: ESSEX
NO. PB 033-1(2) PLOTTED: TR
SHEET 313 OF 400 SHEETS AS BUILT 5/20/94

360 04 465

FOLD

150 EB-OFF RAMP