


RAMP B
RTE 2A

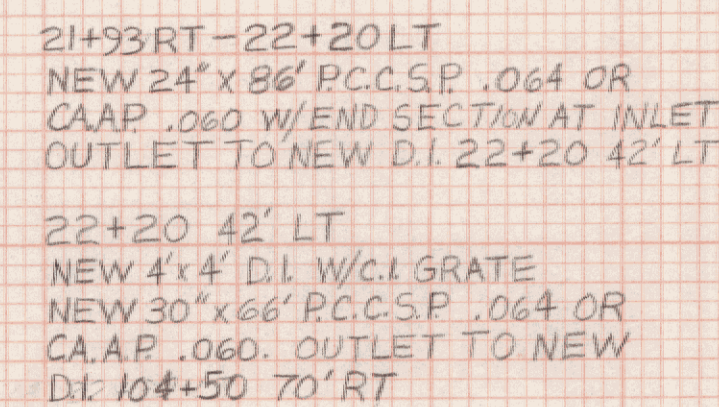

FROM STA. 22+00 TO STA. 22+50
PROJECT NAME: ESSEX
NO. PB 033-1 (2) PLOTTED: TK
SHEET 315 OF 400 SHEETS AS BUILT 5/20/94

362 of 465