



RAMP D
RTE 2A

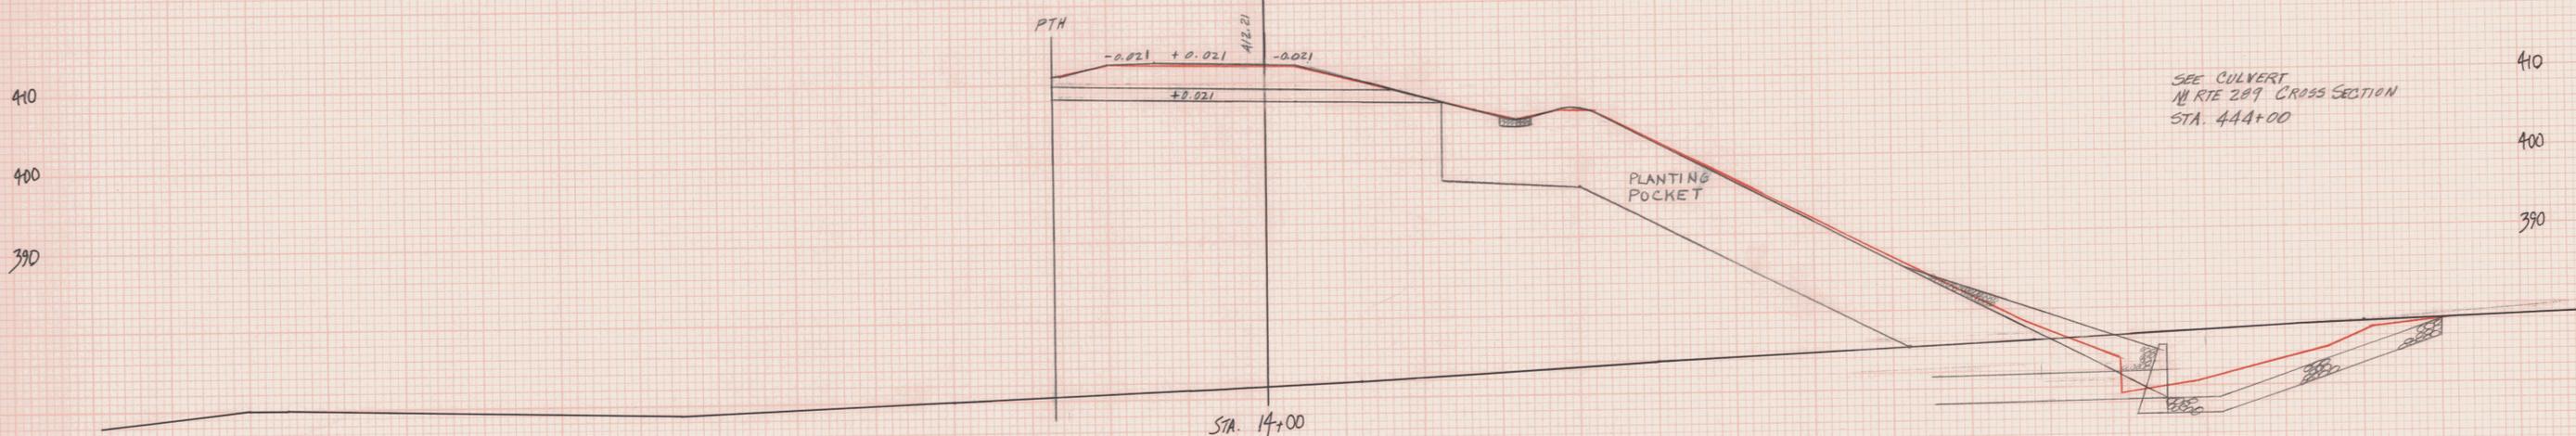

NOTE: SEE RTE 209 STA 444+50
RAMP D STA 13+40
NEW LIGHT POLE #7

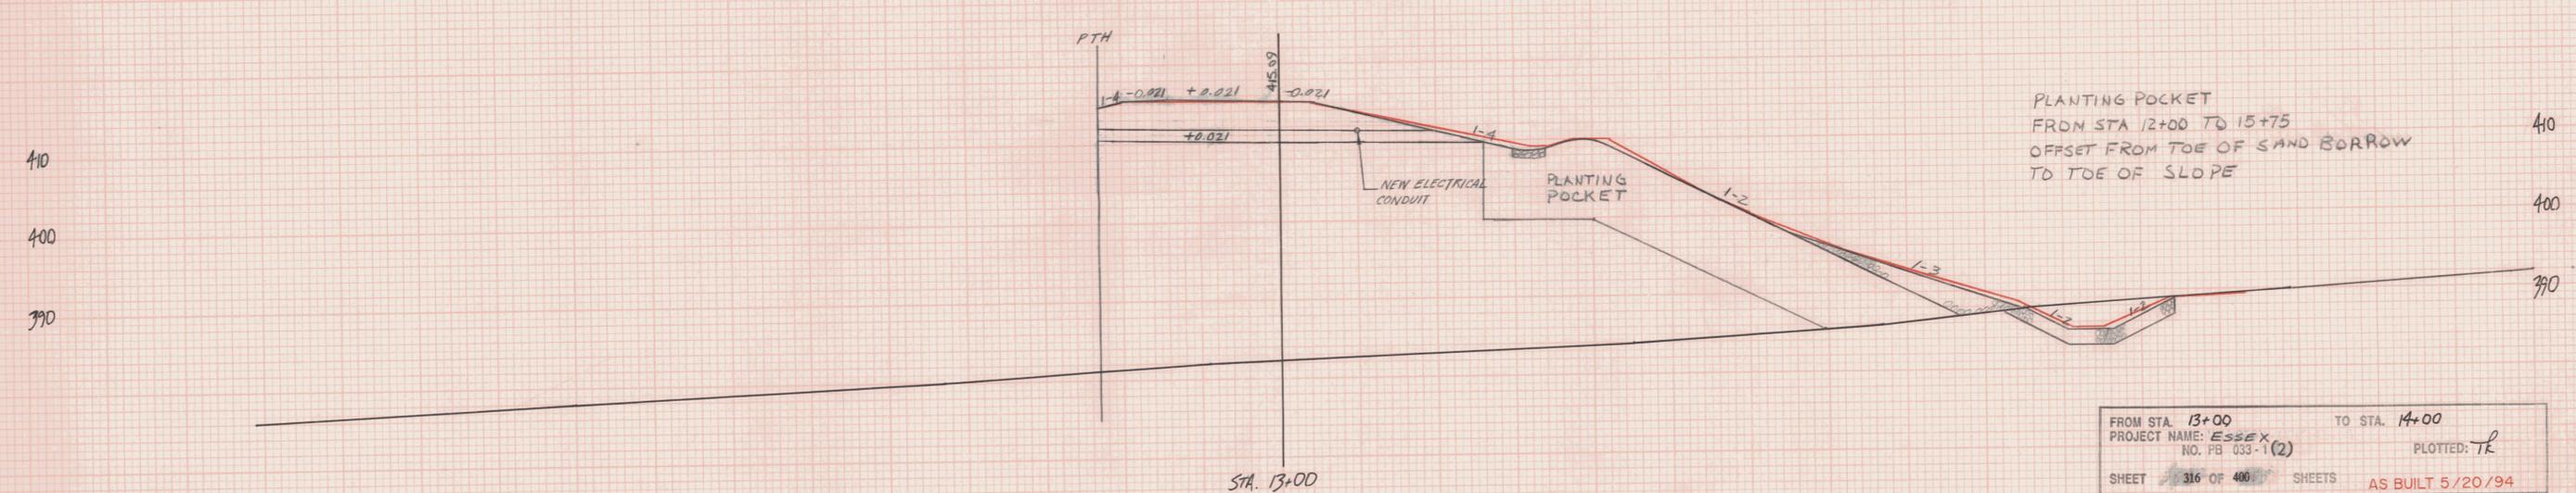

FROM STA. 13+00 TO STA. 14+00
PROJECT NAME: ESSEX
NO. PB 033-1(2)
SHEET 316 OF 400 SHEETS AS BUILT 5/20/94
PLOTTED: TR

FINAL SURVEY
DATE: _____
BY: _____
CHECKED: _____
DATE: _____

FINAL SURVEY
DATE: _____
BY: _____
CHECKED: _____
DATE: _____