
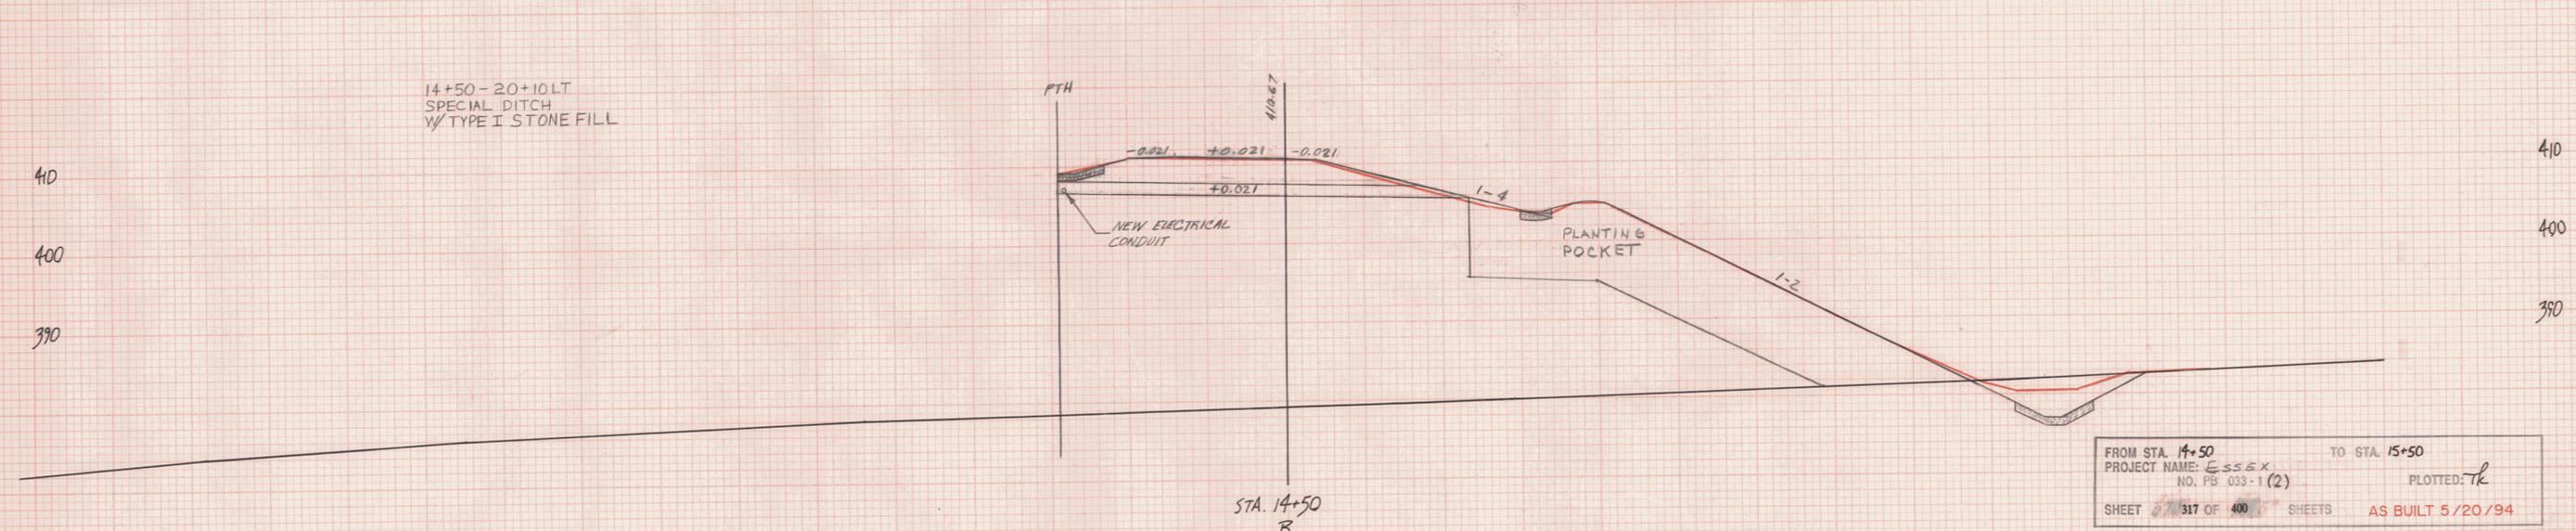
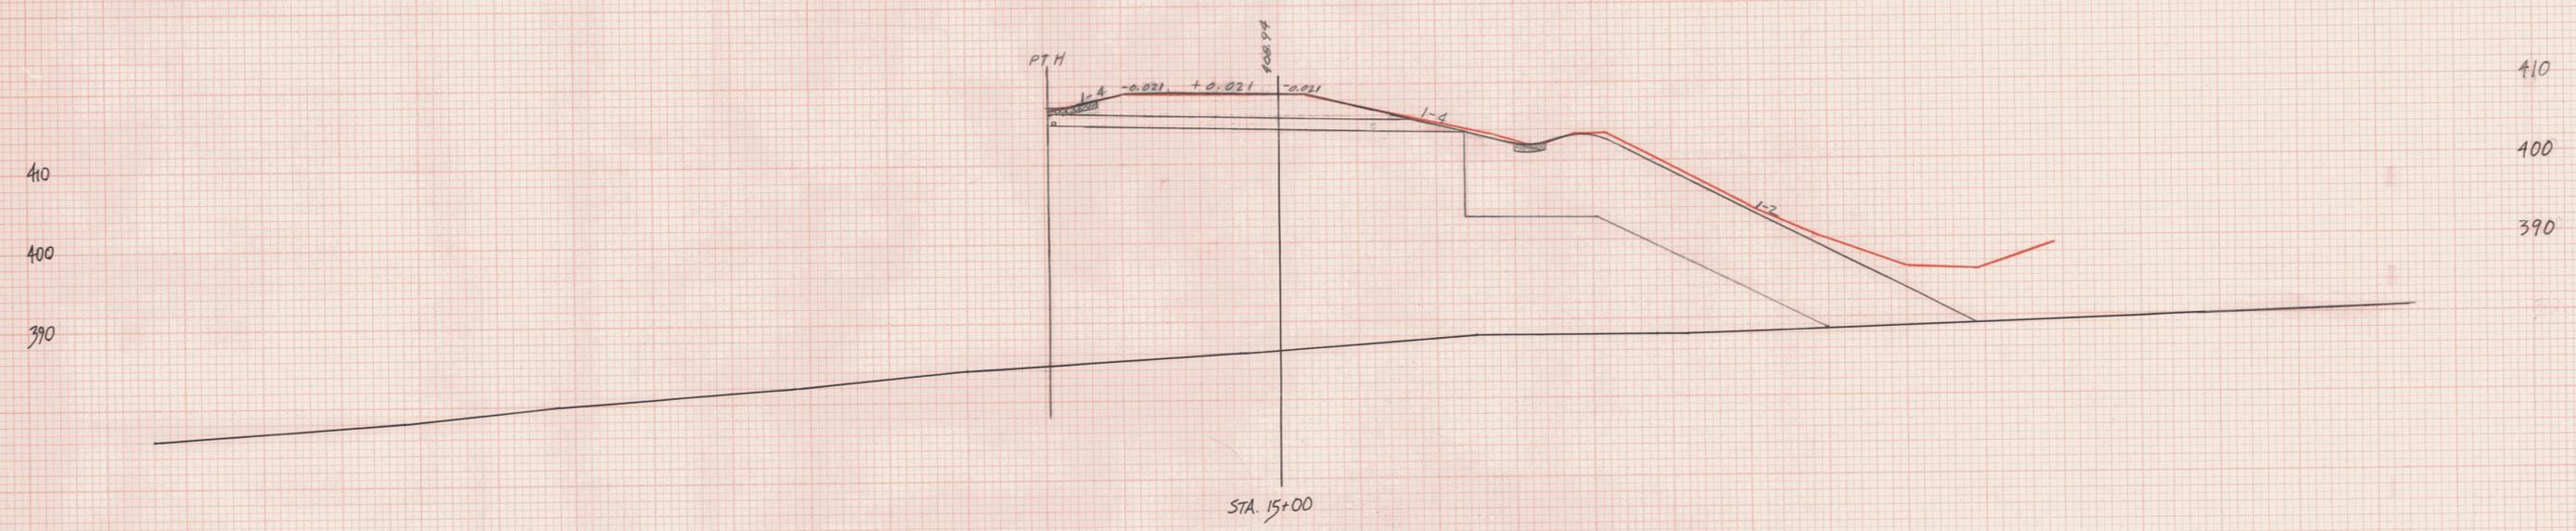


RAMP D  
RTE 2A

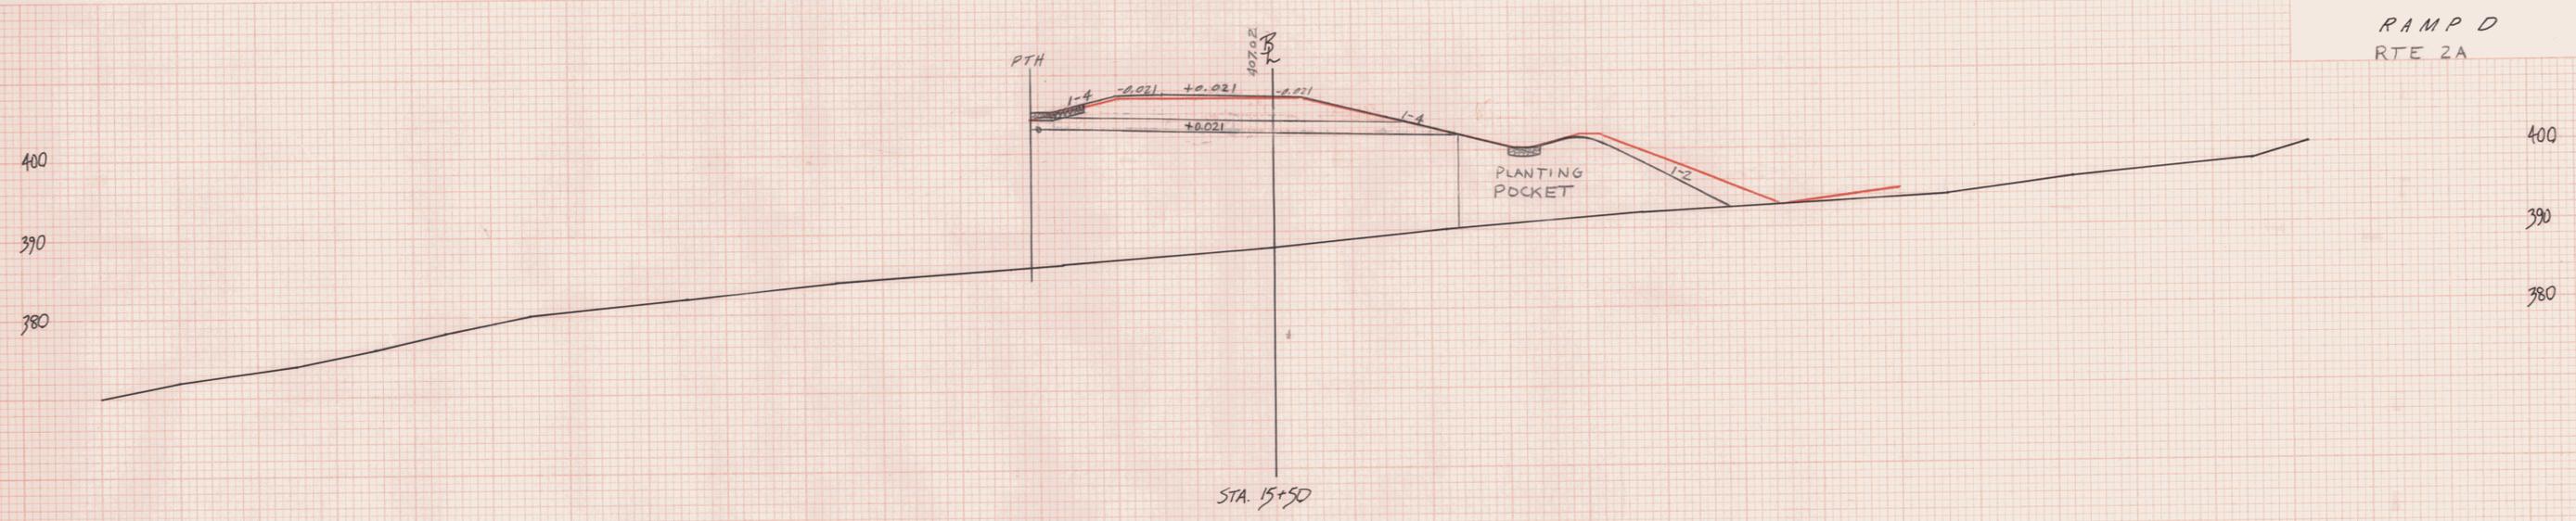

FROM STA. 14+50 TO STA. 15+50  
PROJECT NAME: Essex  
NO. PG 033-1 (2) PLOTTED: TR  
SHEET 317 OF 400 SHEETS AS BUILT 5/20/94

FINAL SURVEY BY DATE  
SURVEYED BY DATE  
DRAWN BY DATE  
CHECKED BY DATE  
NO. AREAS CHECKED

ORIGINAL SURVEY BY DATE  
SURVEYED BY DATE  
DRAWN BY DATE  
CHECKED BY DATE  
NO. AREAS CHECKED

PLATE 3-FULL CROSS SECTION FULL LINE  
VERTICAL CURVE

WB-OFFRAMP

370 04 465