
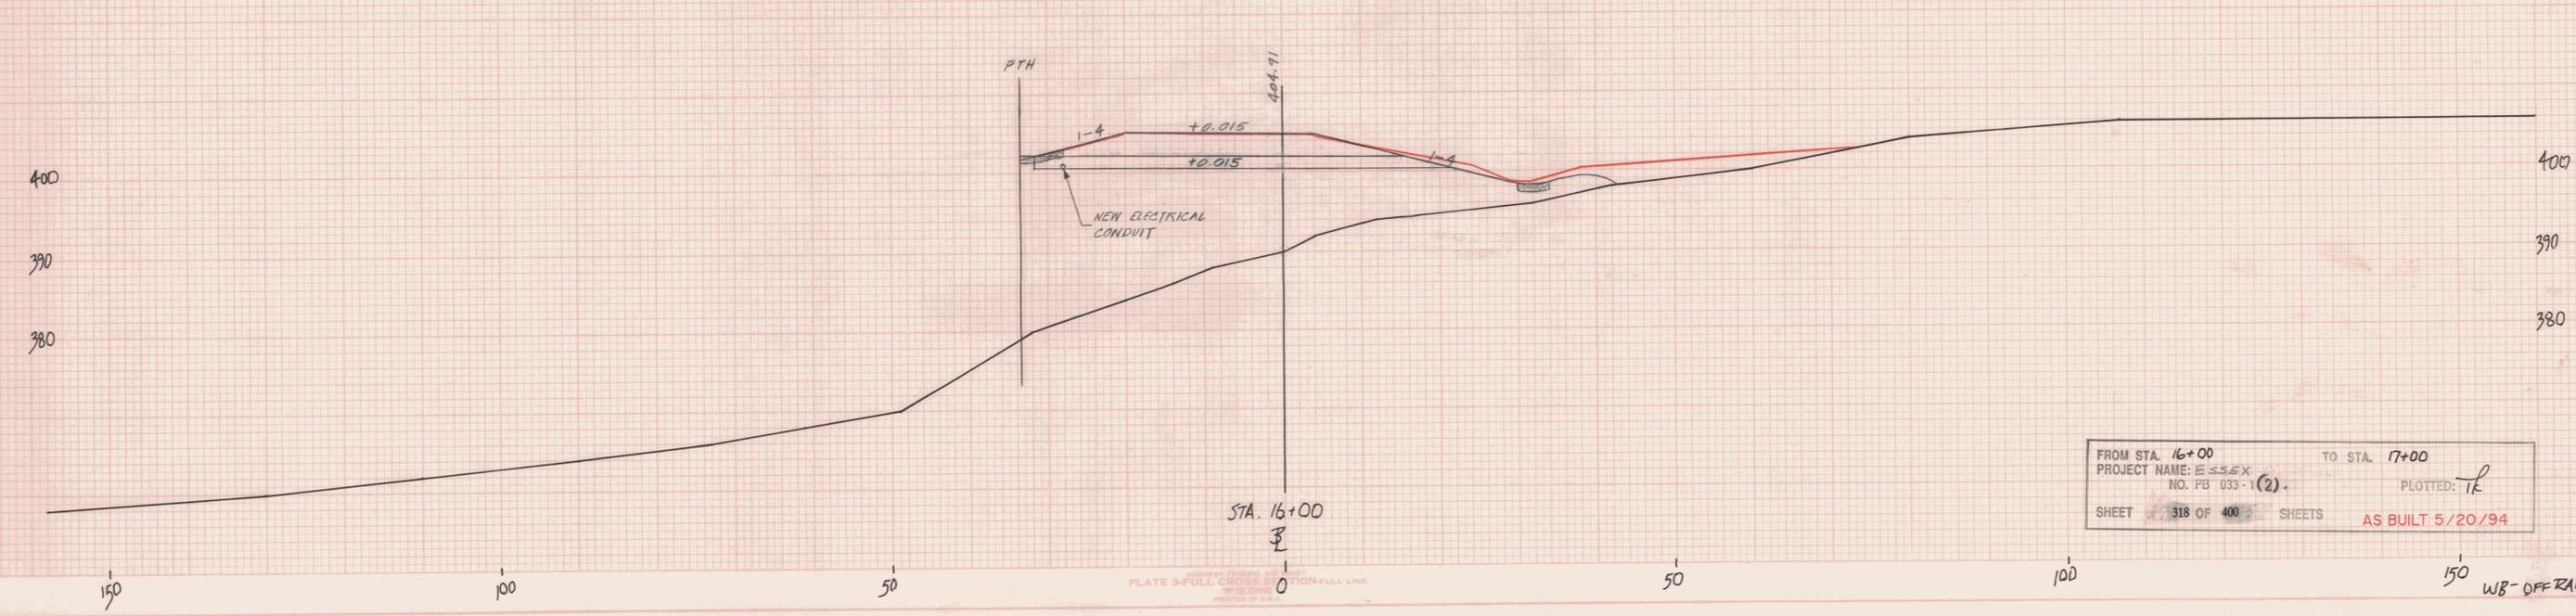
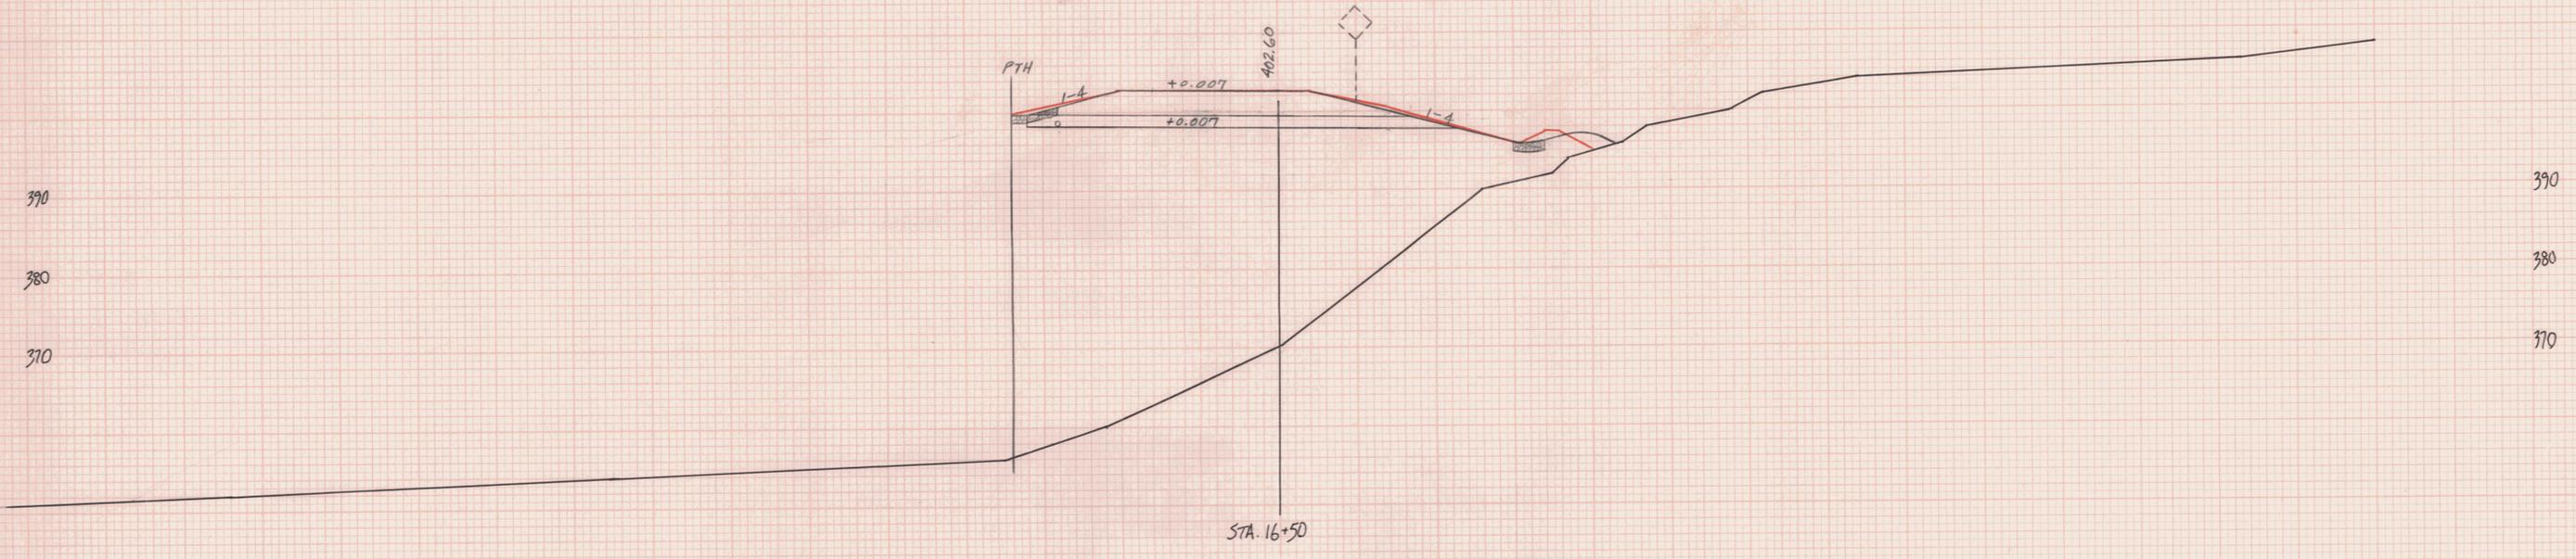


RAMP D
RTE 2A

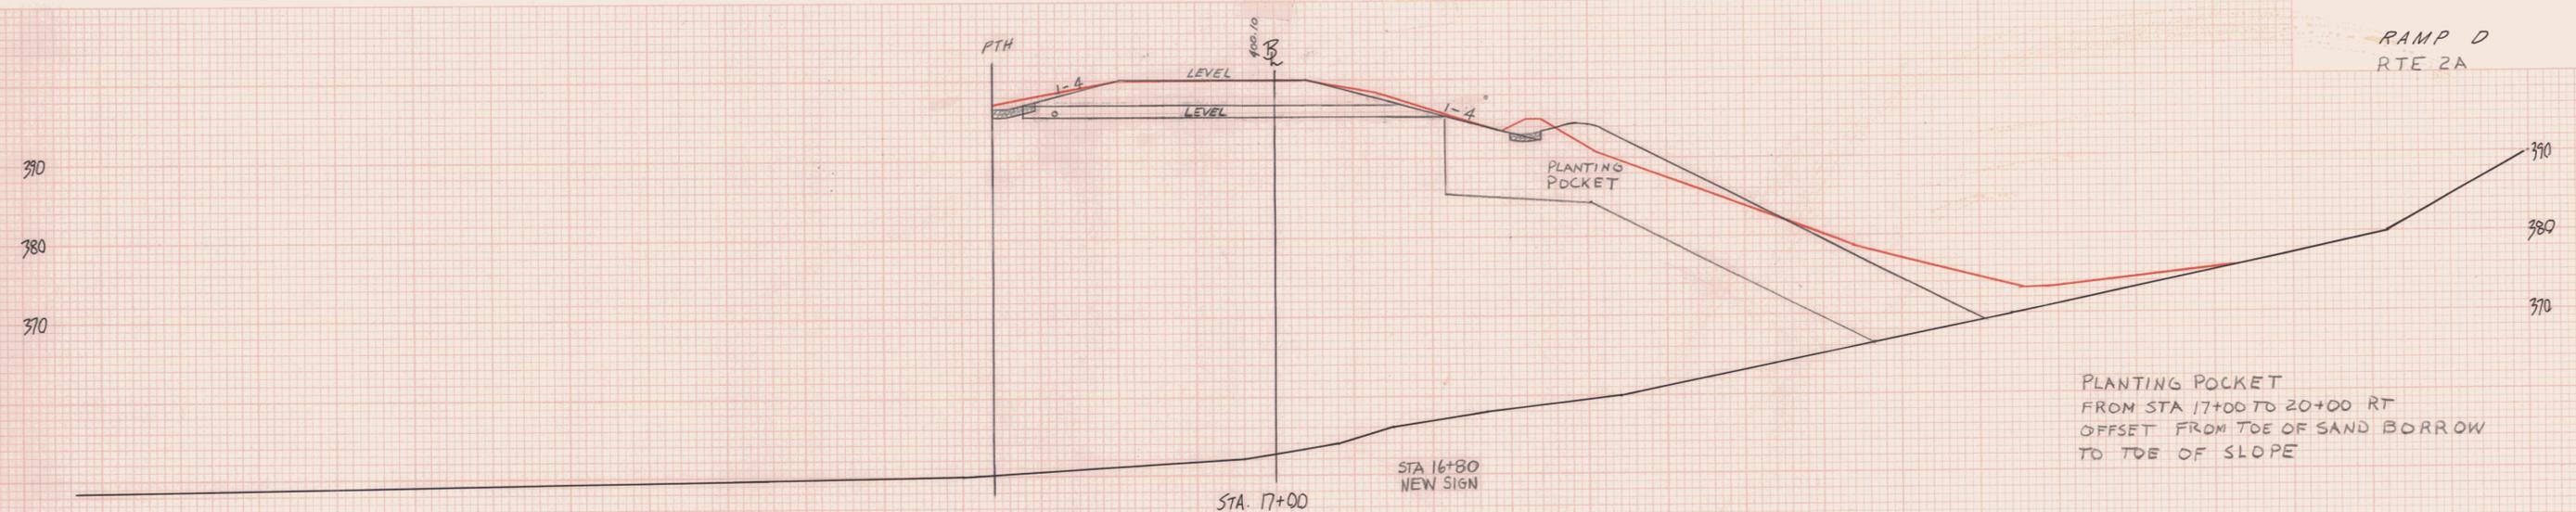

DATE
BY
CHECKED
DATE
BY
DATE
BY

DATE
BY
CHECKED
DATE
BY
DATE
BY

FROM STA. 16+00 TO STA. 17+00
PROJECT NAME: ESSEX
NO. PB 033-1(2)
SHEET 318 OF 400 SHEETS
AS BUILT 5/20/94
PLOTTED: TK

PLATE 3-FULL CROSS SECTION-FULL LINE
PRINTED IN U.S.A.

WB-OFFRAMP