


RAMP D
RTE 2A

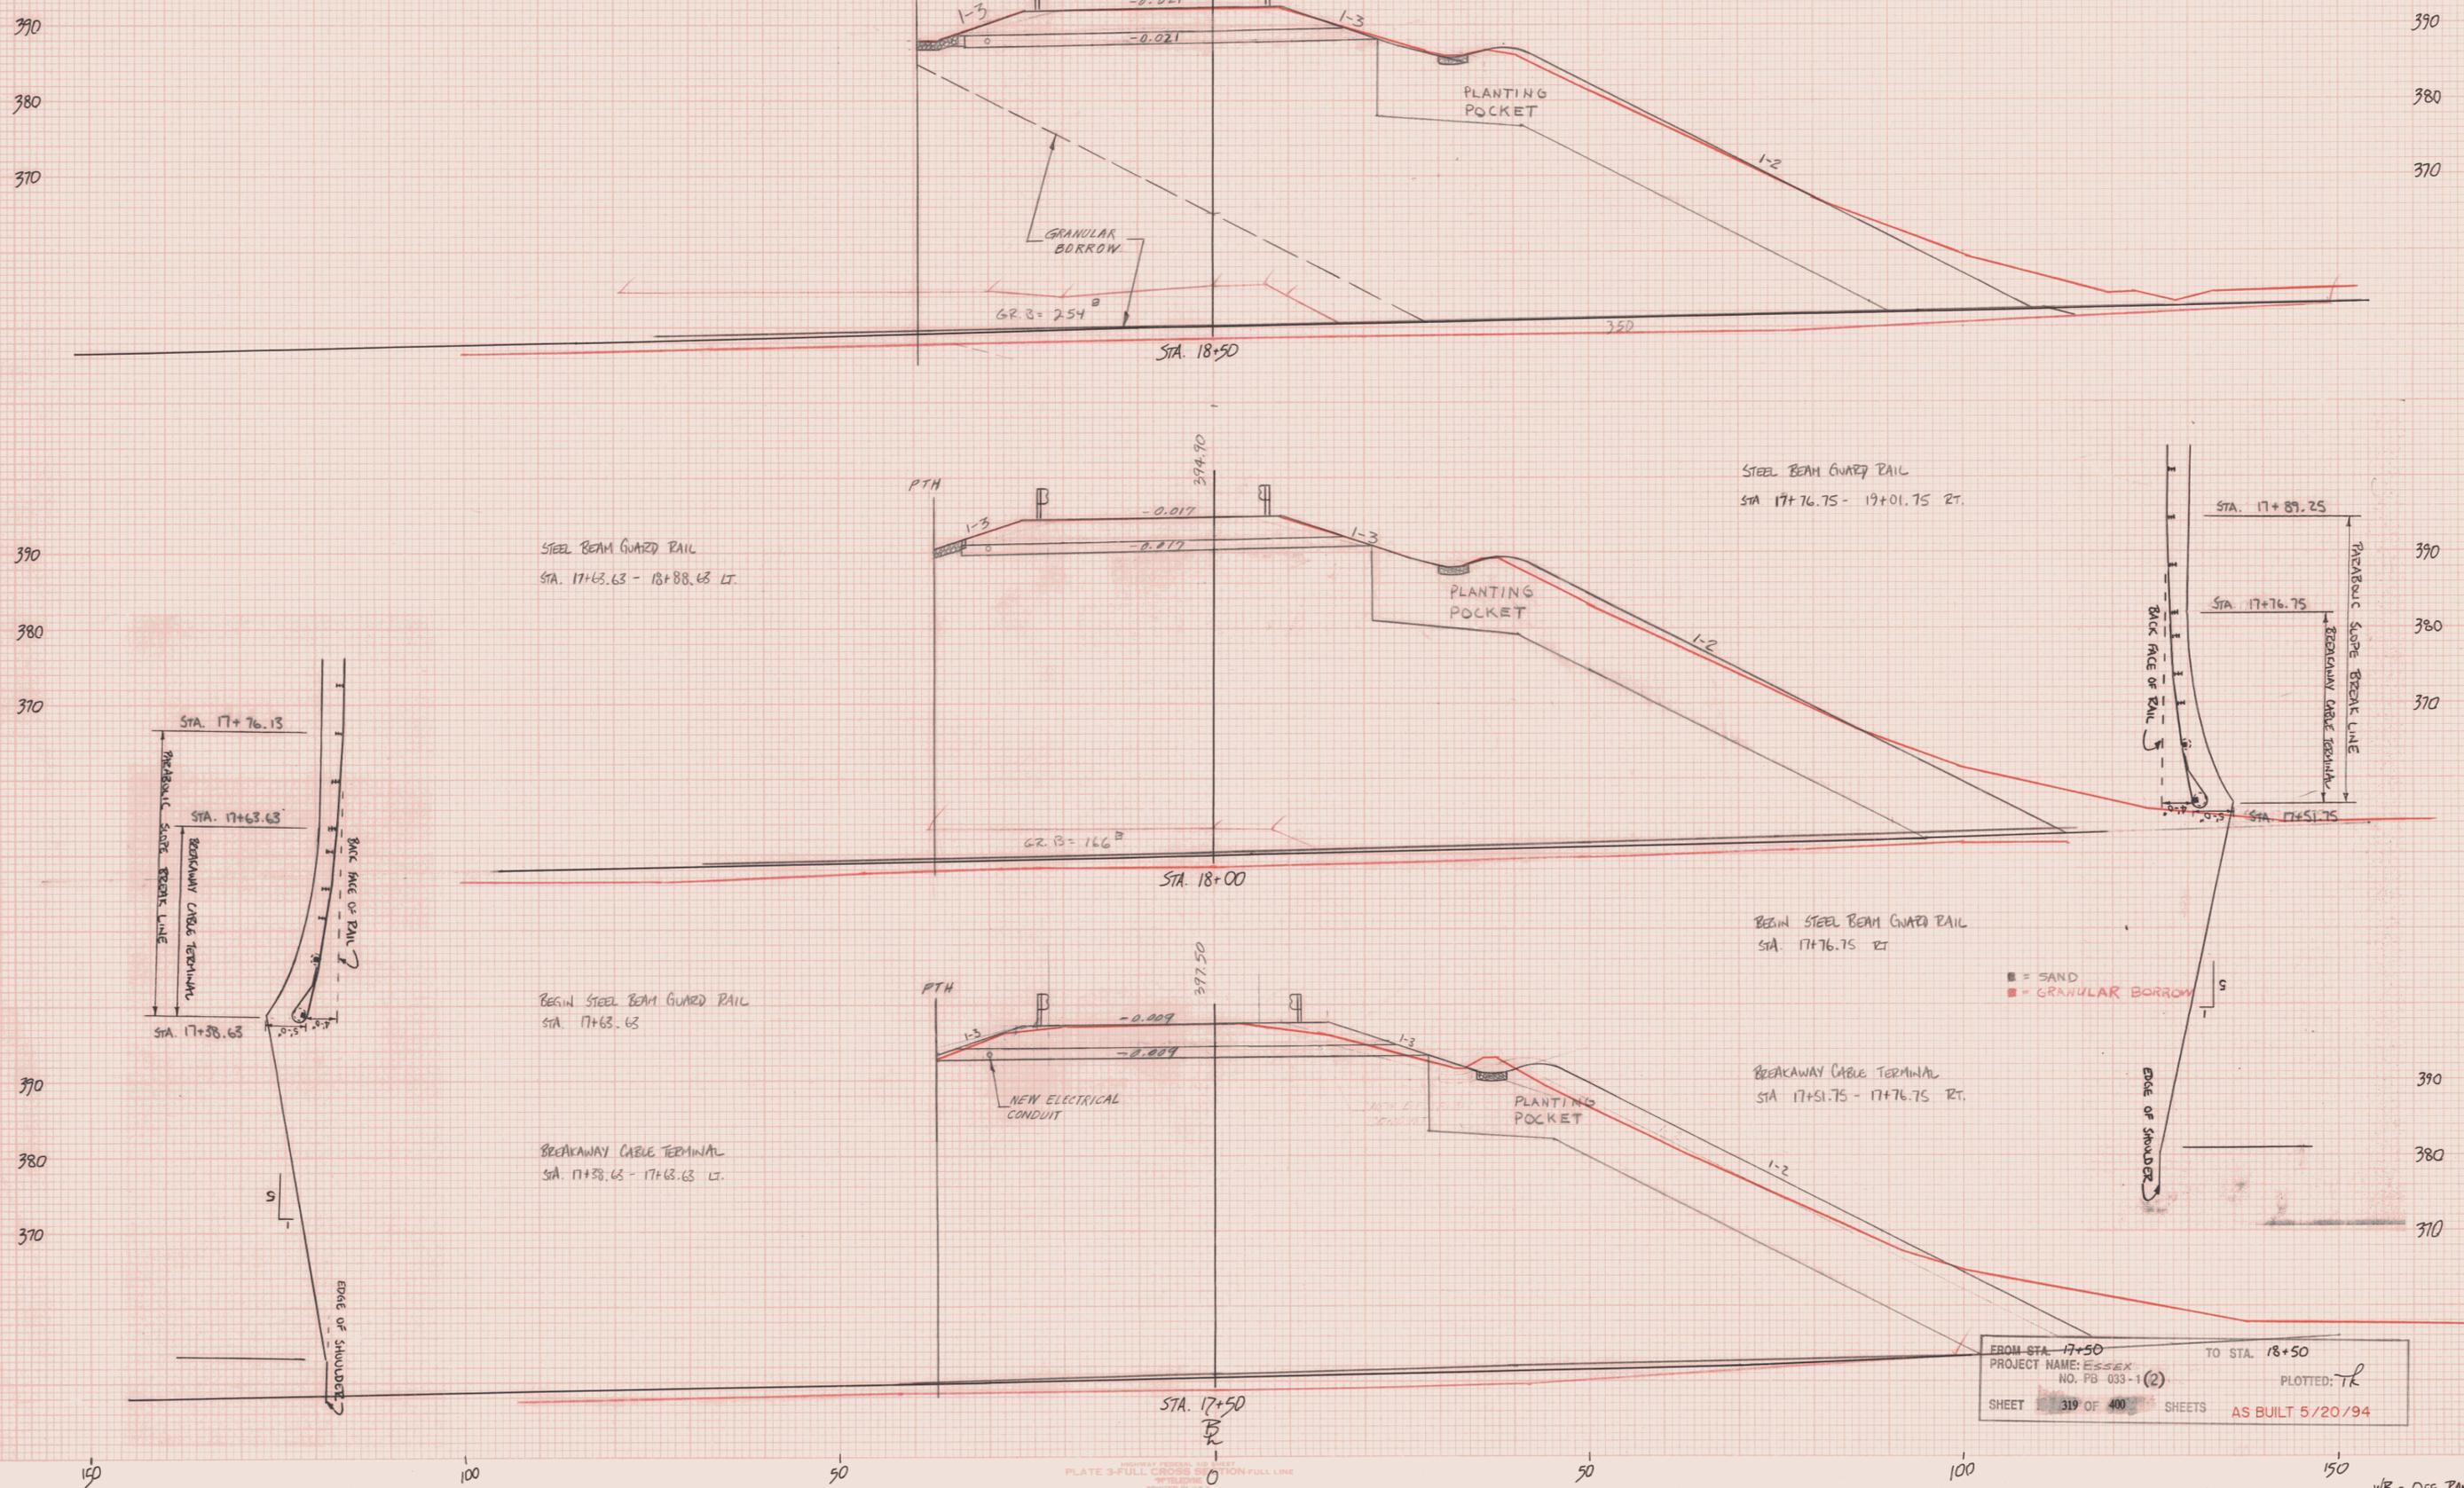

DATE: _____
BY: _____
REVISIONS:
NO. DATE DESCRIPTION
1. _____
2. _____
DATE: _____
BY: _____
REVISIONS:
NO. DATE DESCRIPTION
1. _____
2. _____
3. _____
FROM STA. 17+50 TO STA. 18+50
PROJECT NAME: ESSEX
NO. PB 033-1 (2) PLOTTED: TR
SHEET 319 OF 400 SHEETS AS BUILT 5/20/94