


RAMP D  
RTE 2A

DATE: \_\_\_\_\_  
BY: \_\_\_\_\_  
REVISIONS:  
PLOTTED: \_\_\_\_\_  
NOTE BOOK: \_\_\_\_\_  
PAGE: \_\_\_\_\_  
NO.: \_\_\_\_\_

DATE: \_\_\_\_\_  
BY: \_\_\_\_\_  
REVISIONS:  
PLOTTED: \_\_\_\_\_  
NOTE BOOK: \_\_\_\_\_  
PAGE: \_\_\_\_\_  
NO.: \_\_\_\_\_

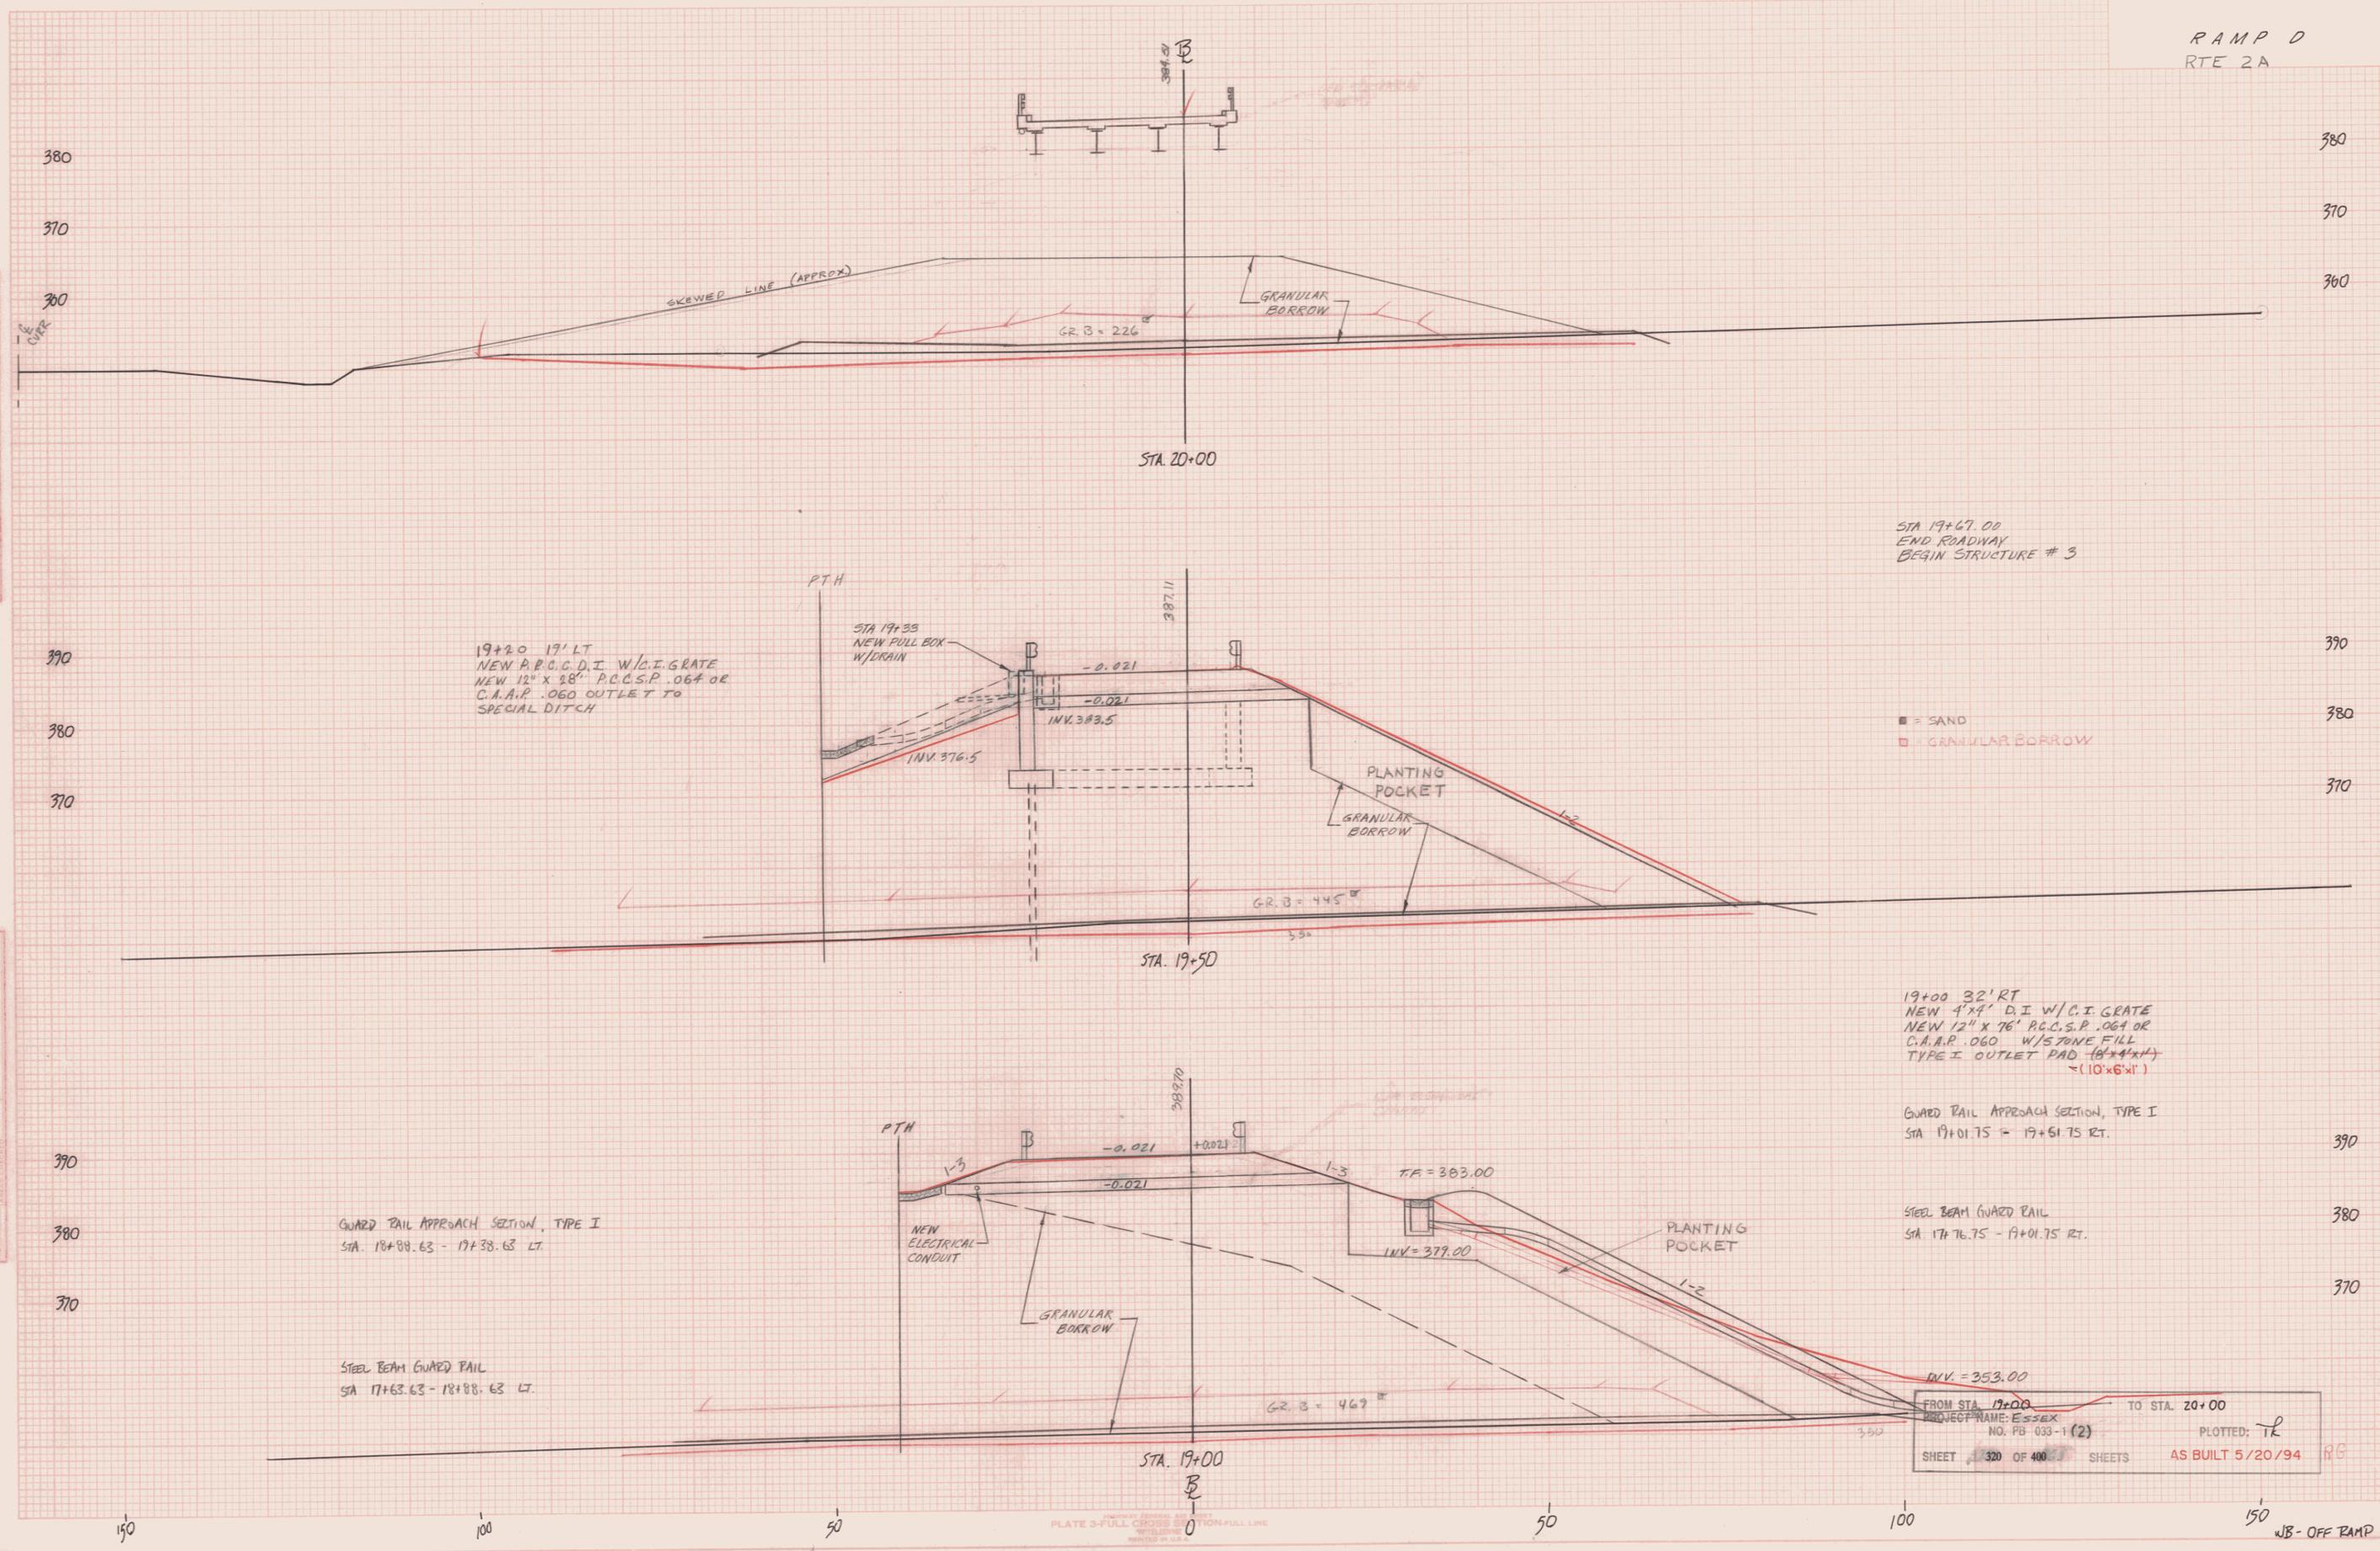

STA 19+67.00  
END ROADWAY  
BEGIN STRUCTURE # 3

19+20 19' LT  
NEW P.R.C.C.D.I W/C.I. GRATE  
NEW 12" X 28" P.C.C.S.P. .064 OR  
C.A.A.P. .060 OUTLET TO  
SPECIAL DITCH

■ = SAND  
□ = GRANULAR BORROW

19+00 32' RT  
NEW 4' X 4' D.I W/C.I. GRATE  
NEW 12" X 76" P.C.C.S.P. .064 OR  
C.A.A.P. .060 W/STONE FILL  
TYPE I OUTLET PAD (18' X 4' X 1")  
(10' X 6' X 1")

GUARD RAIL APPROACH SECTION, TYPE I  
STA. 18+88.63 - 19+38.63 LT.

GUARD RAIL APPROACH SECTION, TYPE I  
STA. 19+01.75 - 19+51.75 RT.

STEEL BEAM GUARD RAIL  
STA. 17+63.63 - 18+88.63 LT.

STEEL BEAM GUARD RAIL  
STA. 17+76.75 - 19+01.75 RT.

FROM STA. 17+00	TO STA. 20+00
PROJECT NAME: ESSEX	
NO. PB-033-1 (2)	
SHEET 320 OF 400 SHEETS	AS BUILT 5/20/94

PLOTTED: TR