


RAMP D  
RTE 2A

21+60 19' LT  
NEW RR.C.C.D.I. W/C.I. GRATE  
NEW 12" X 14" P.C.C.S.P. .064 OF  
C.A.A.B. 1060 OUTLET TO  
SPECIAL DITCH

STEEL BEAM GUARD RAIL  
STA 21+50.28 - 22+25.28

GUARD RAIL APPROACH SECTION, TYPE II  
STA 21+37.78 - 21+50.28 LT

21+46 LT - 113+ RT  
SPECIAL DITCH  
W/TYPE I STONE

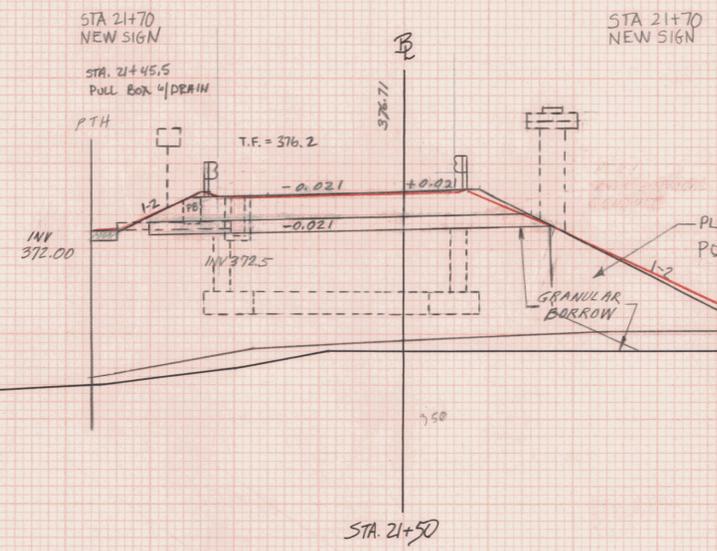


GUARD RAIL APPROACH SECTION, TYPE II  
STA 21+49.63 - 21+62.13 RT.

STEEL BEAM GUARD RAIL  
STA 21+62.13 - 22+24.63 RT


STA 21+32.37  
END STRUCTURE # 3  
RESUME ROADWAY

PLANTING POCKET  
FROM STA 21+25 TO 23+75 RT  
OFFSET FROM TOE OF SAND BORROW  
TO TOE OF SLOPE

21+20 RT - 117+80 RT  
SPECIAL DITCH  
W/TYPE I STONE FILL

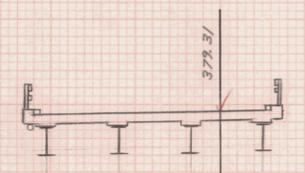

STA. 21+00

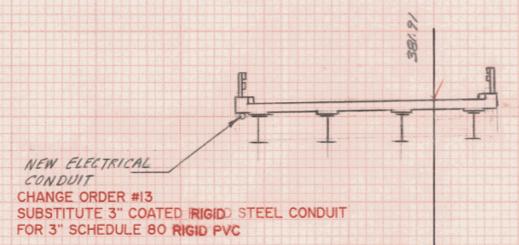

STA. 20+50

FROM STA. 20+50 TO STA. 21+50  
PROJECT NAME: ESSEX  
NO. PB 033-1 (2)  
SHEET 321 OF 400 SHEETS AS BUILT 5/20/94  
PLOTTED: TR

DATE: \_\_\_\_\_ BY: \_\_\_\_\_  
FINAL SURVEY PLOTTED: \_\_\_\_\_  
NOTE BOOK AREA: \_\_\_\_\_  
NO. \_\_\_\_\_ AREA CHECKED: \_\_\_\_\_

DATE: \_\_\_\_\_ BY: \_\_\_\_\_  
ORIGINAL SURVEY PLOTTED: \_\_\_\_\_  
NOTE BOOK AREA: \_\_\_\_\_  
NO. \_\_\_\_\_ AREA CHECKED: \_\_\_\_\_

PLATE 3-FULL CROSS SECTION-FULL LINE  
W/ TIE LINE  
PRINTED IN U.S.A.

WB-OFF RAMP