


RAMP D
RTE 2A

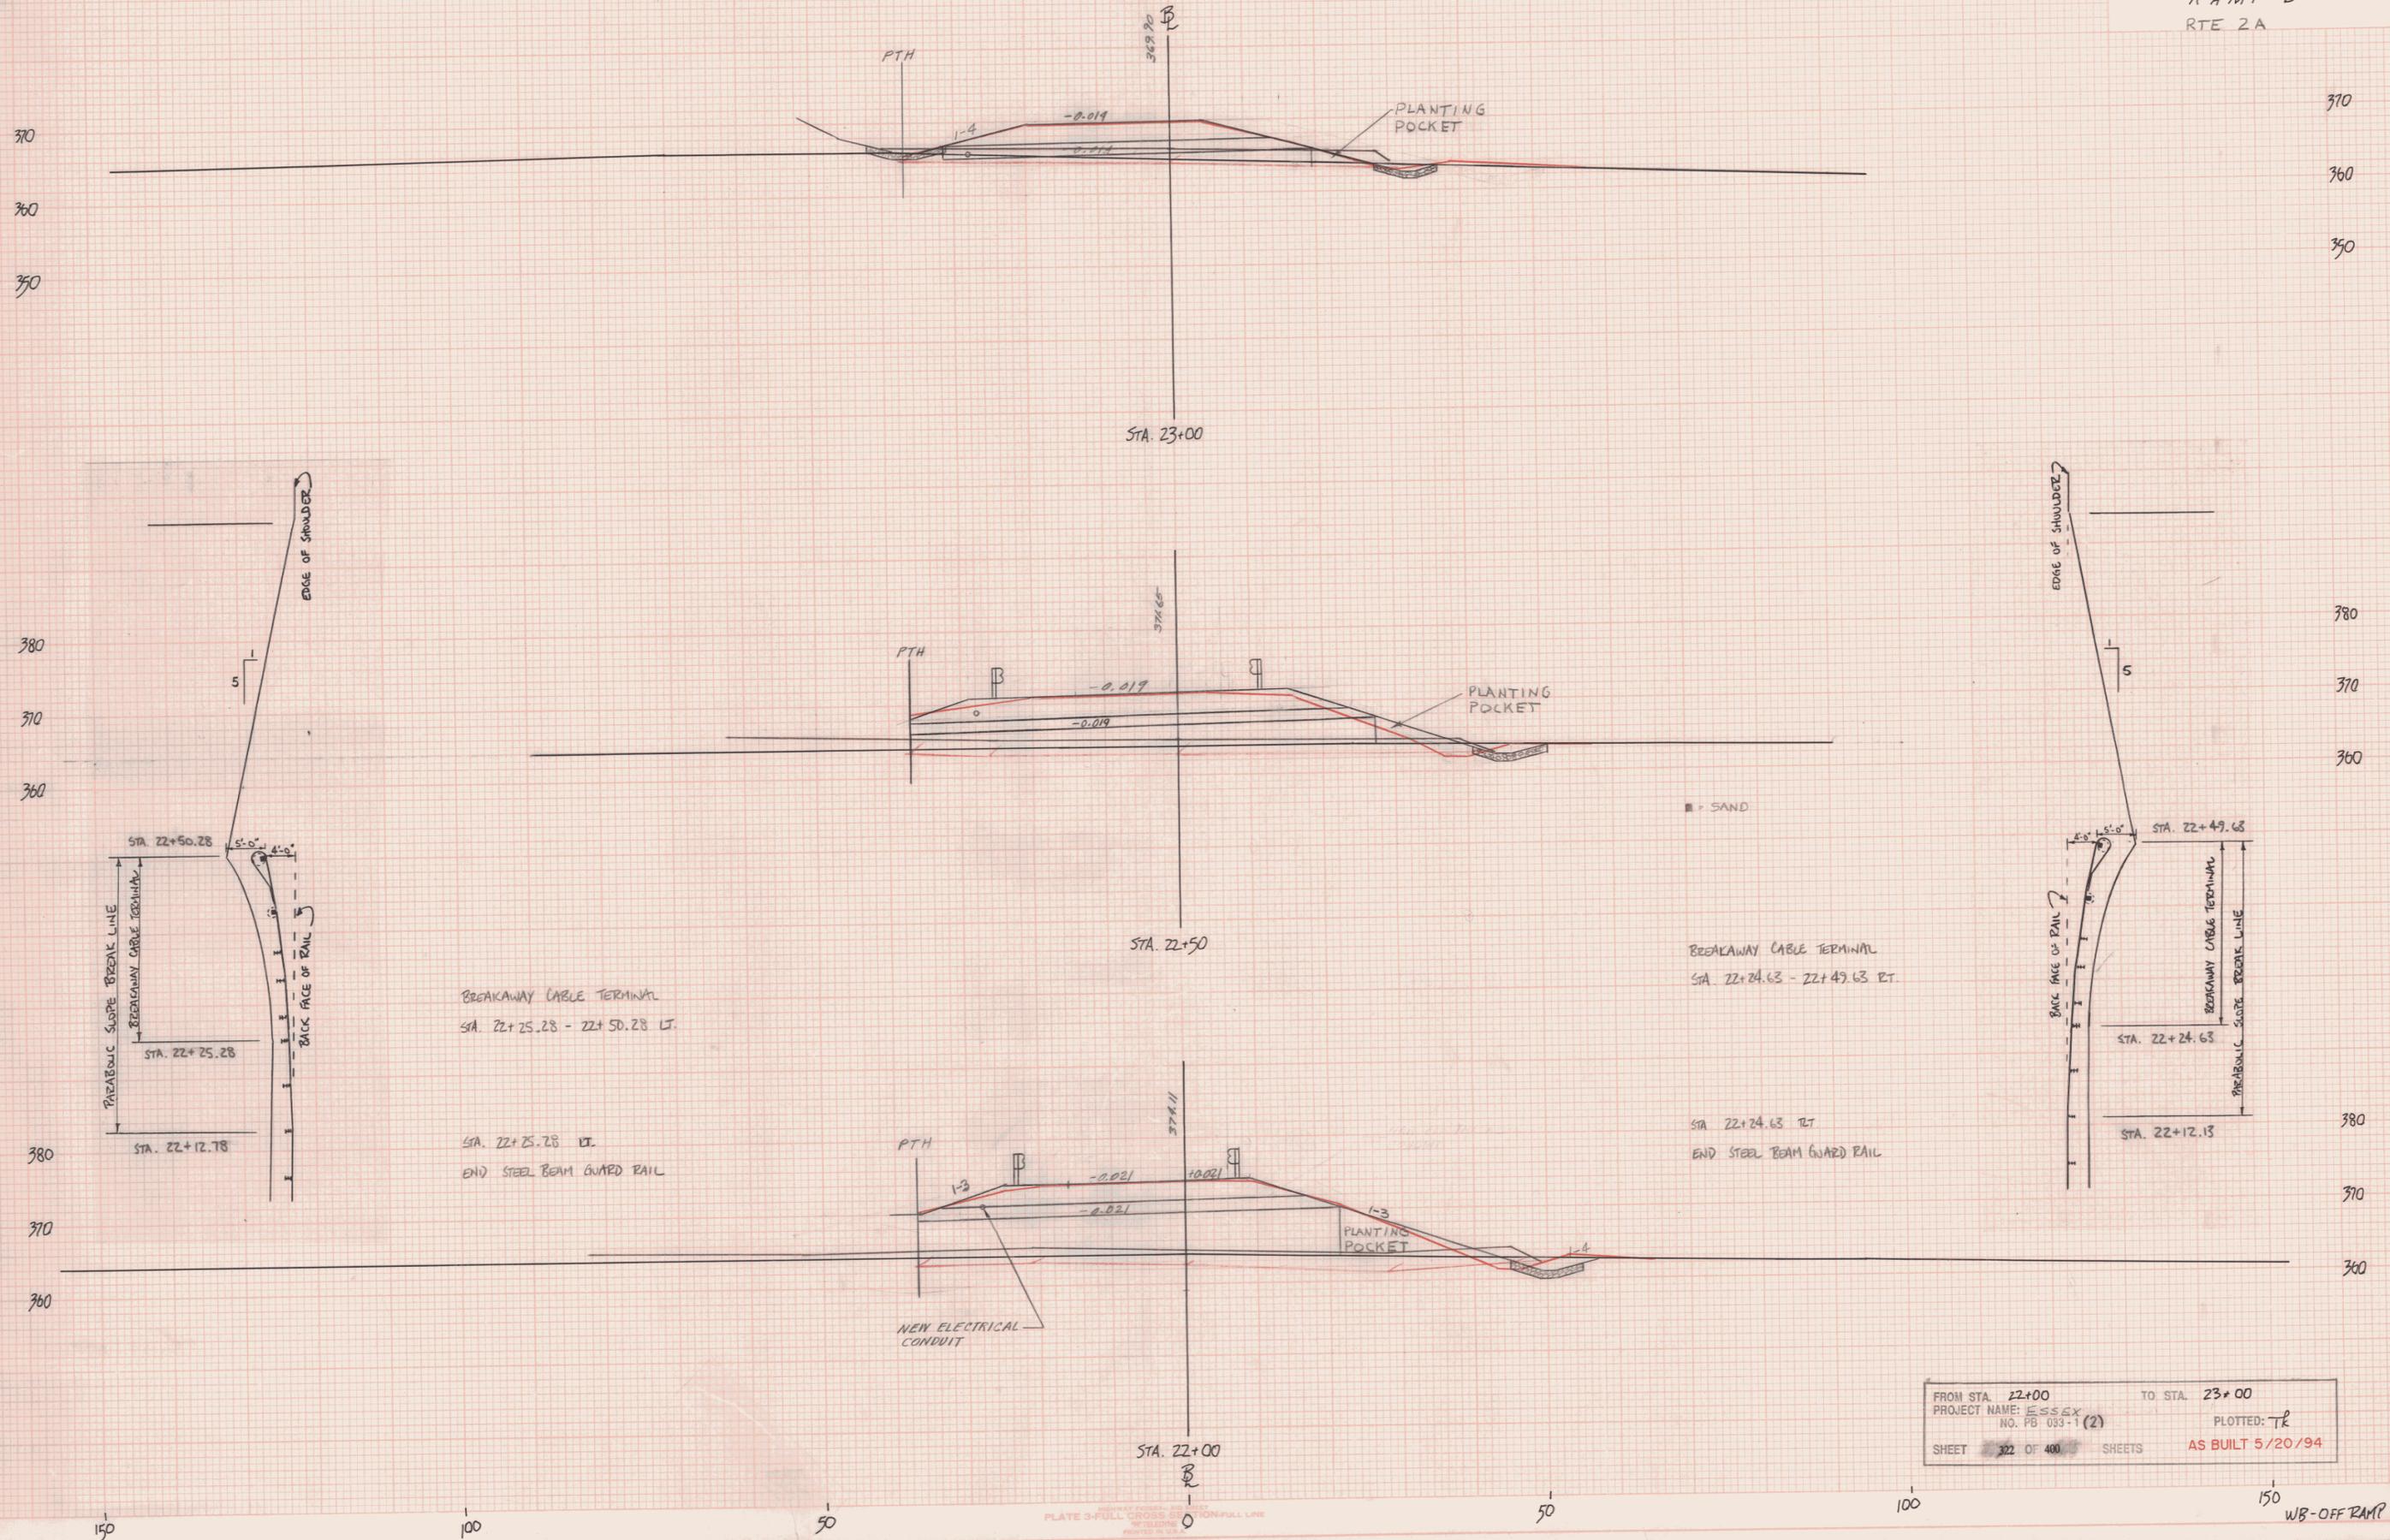

FINAL SURVEY PLOTTED
DATE: _____
BY: _____
NO. _____
DATE: _____
BY: _____
NO. _____

ORIGINAL SURVEY PLOTTED
DATE: _____
BY: _____
NO. _____
DATE: _____
BY: _____
NO. _____

FROM STA. 22+00 TO STA. 23+00
PROJECT NAME: ESSEX
NO. PB 033-1 (2) PLOTTED: TR
SHEET 322 OF 400 SHEETS AS BUILT 5/20/94

PLATE 3-FULL CROSS SECTION FULL LINE
OF FIELDING
PROVIDE TO V.A.

315 OF 465

WB-OFF RAMP