
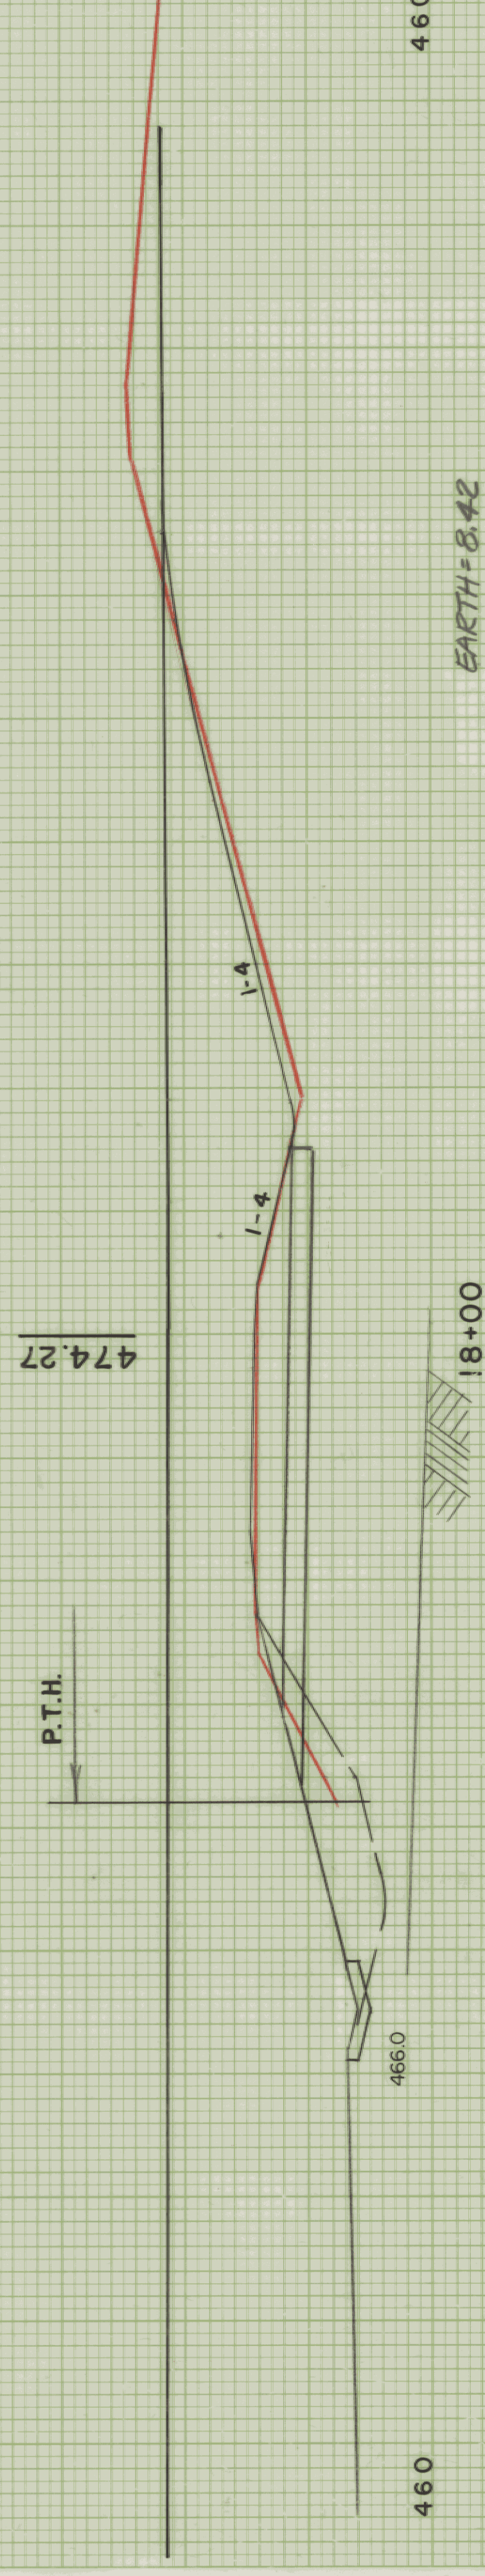
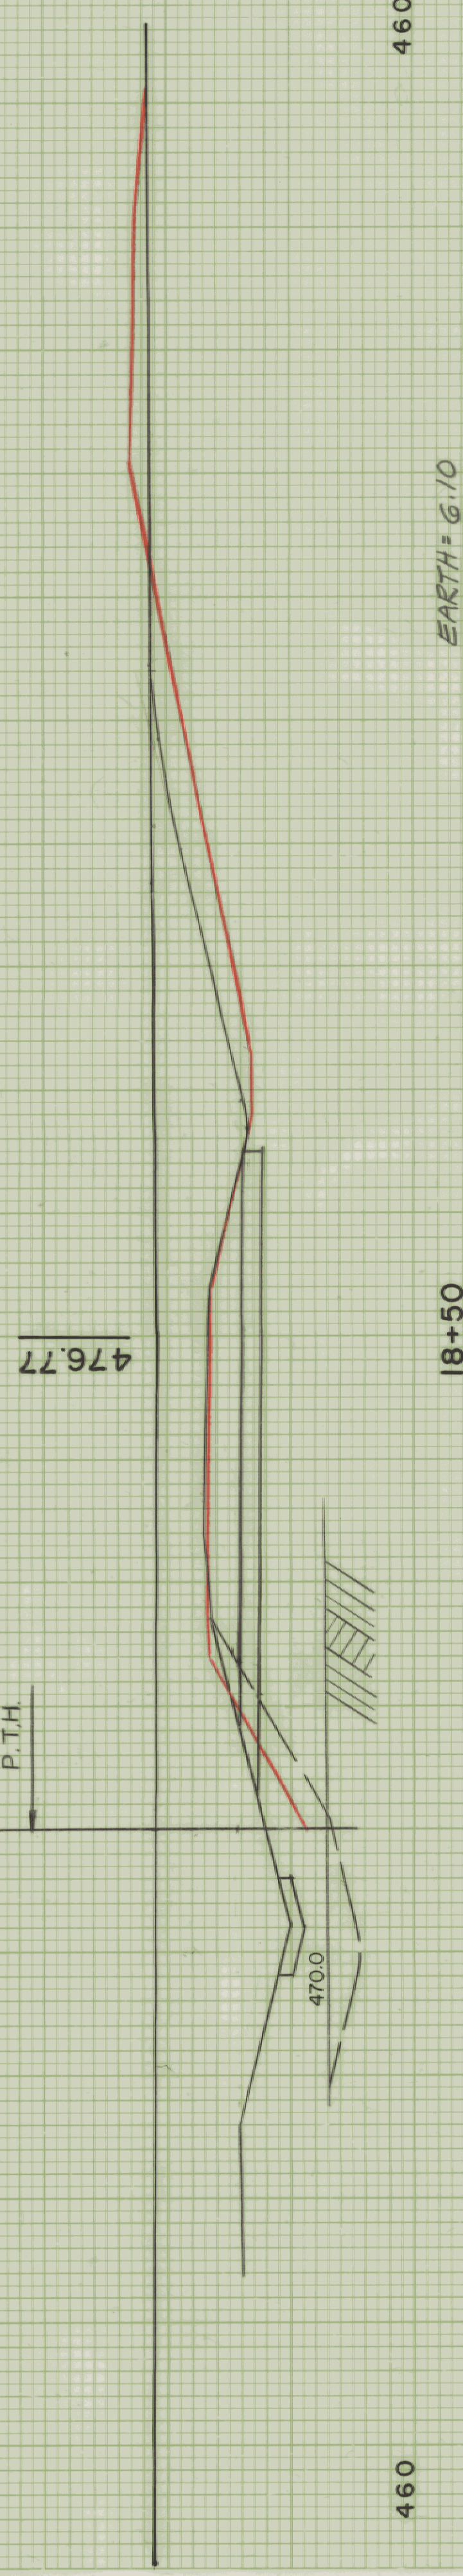
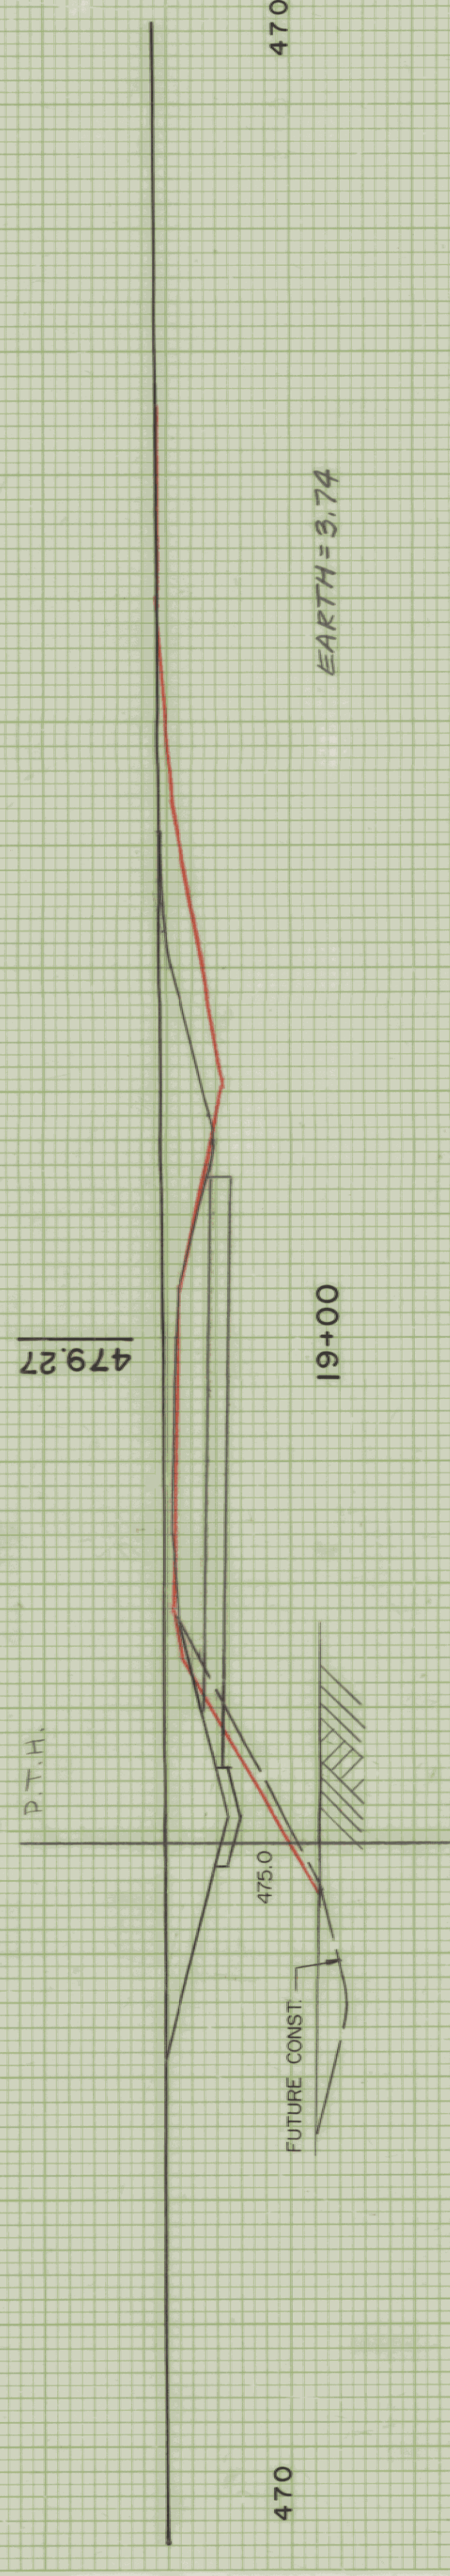
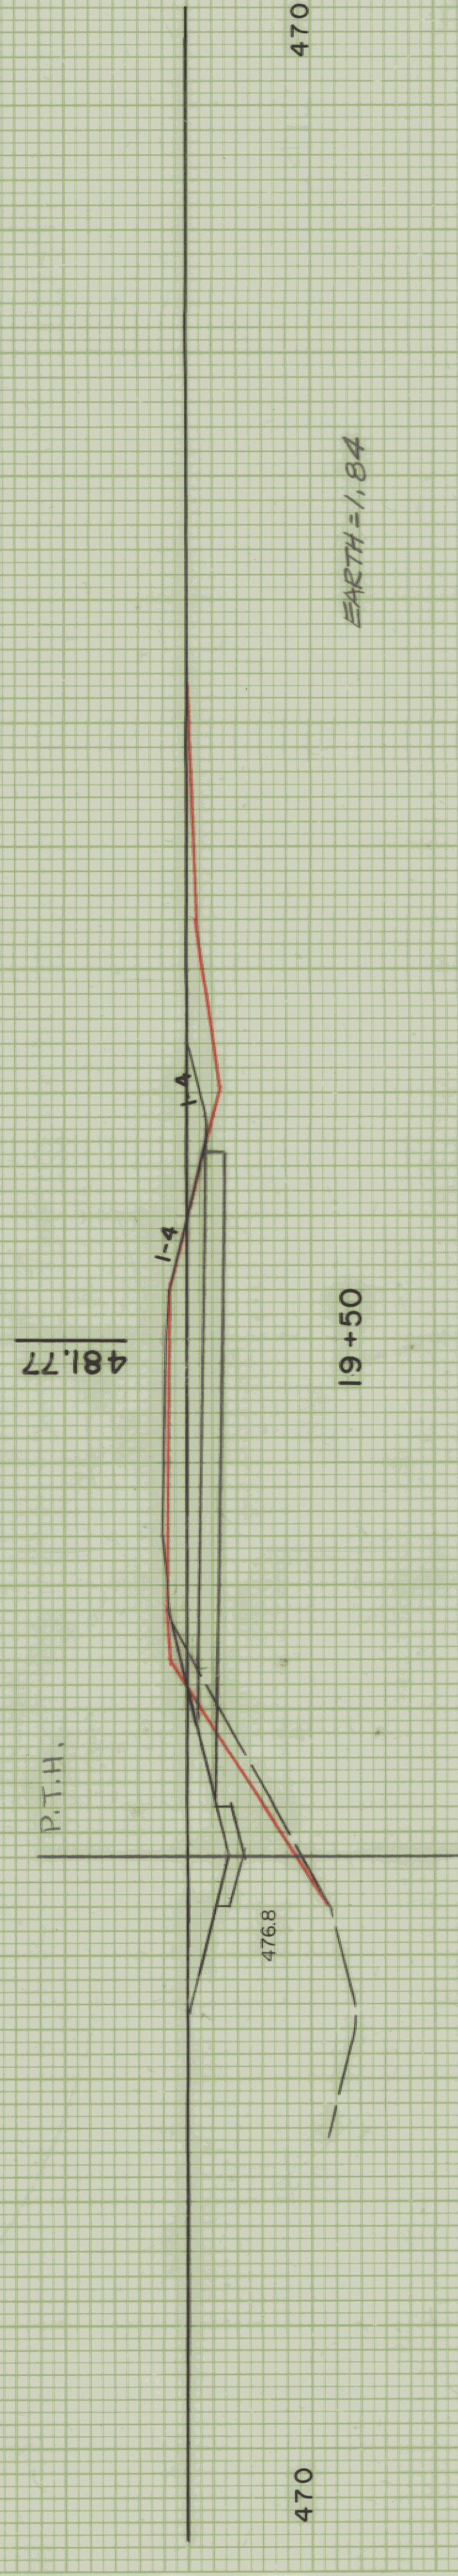
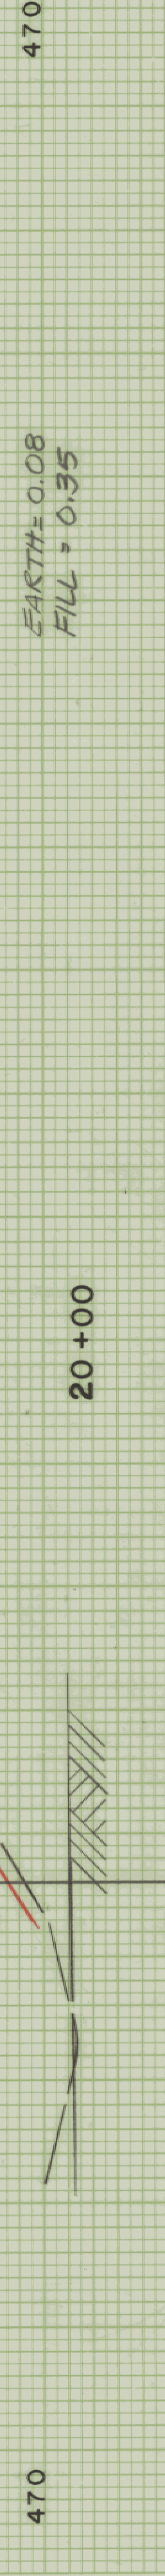


M3-1 (L)
 M3-2 (R)
 M3-3 (L)
 M3-4 (R)
 M3-5 (L)
 M3-6 (R)
 M3-7 (L)
 M3-8 (R)
 M3-9 (L)
 M3-10 (R)

P.T.H.

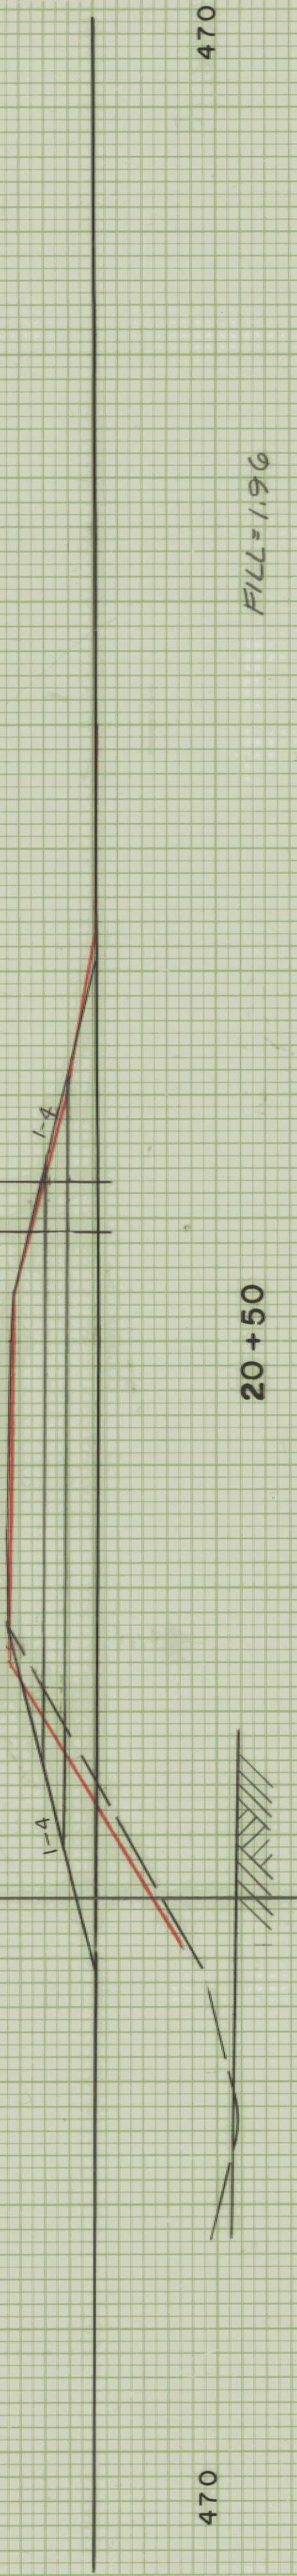

AS BUILT 5/23/94
 REVISED 12/28/90

FROM STA. 7 + 50 TO STA. 10 + 50
 VERMONT ROUTE 299 P.A.P.
 WILLISTON-COLCHESTER, VT. PROJ. NO. PB 033-1 (2)
 SURVEYED BY PINKHAM ENGINEERING
 SHEET 324 OF 400