


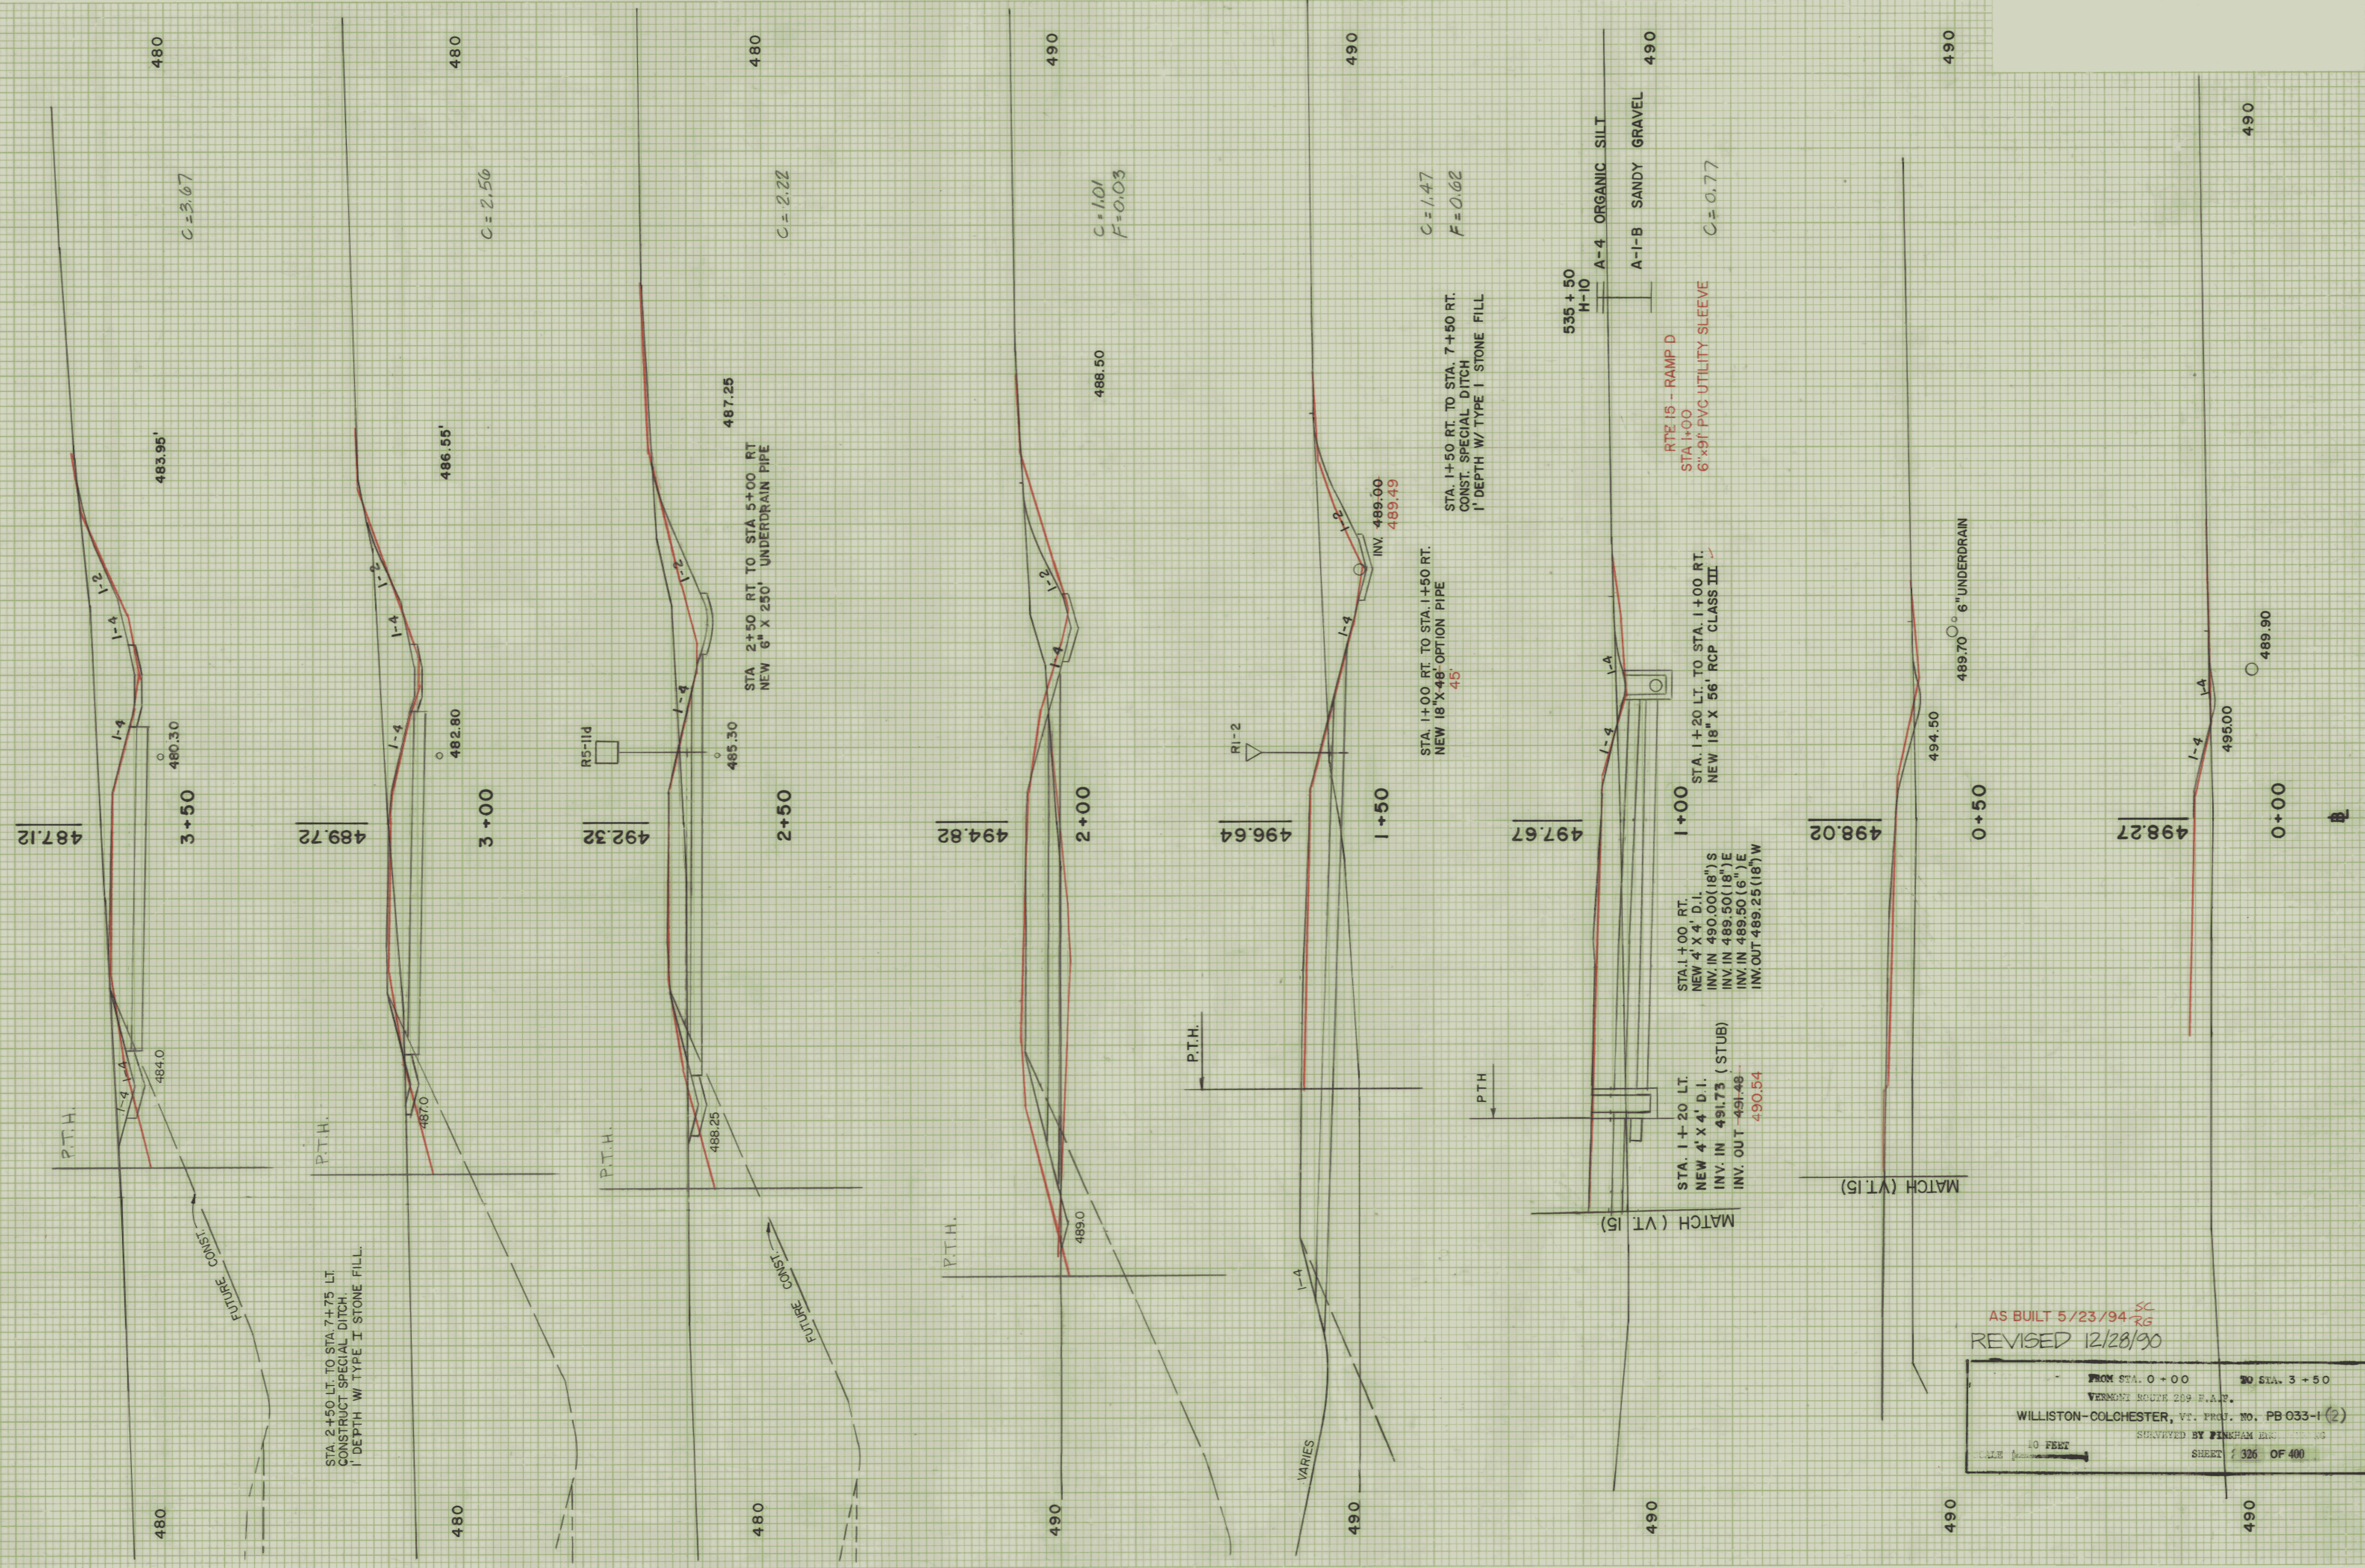

AS BUILT 5/23/94 SC
REVISED 12/28/90 RG

FROM STA. 0+00	TO STA. 3+50
VERMONT ROUTE 209 E.A.P.	
WILLISTON-COLCHESTER, VT. PROJ. NO. PB 033-1 (2)	
DESIGNED BY WINGRAM INC.	
SCALE 1" = 40 FEET	SHEET 326 OF 400

RTE 15 RAMP "D"