


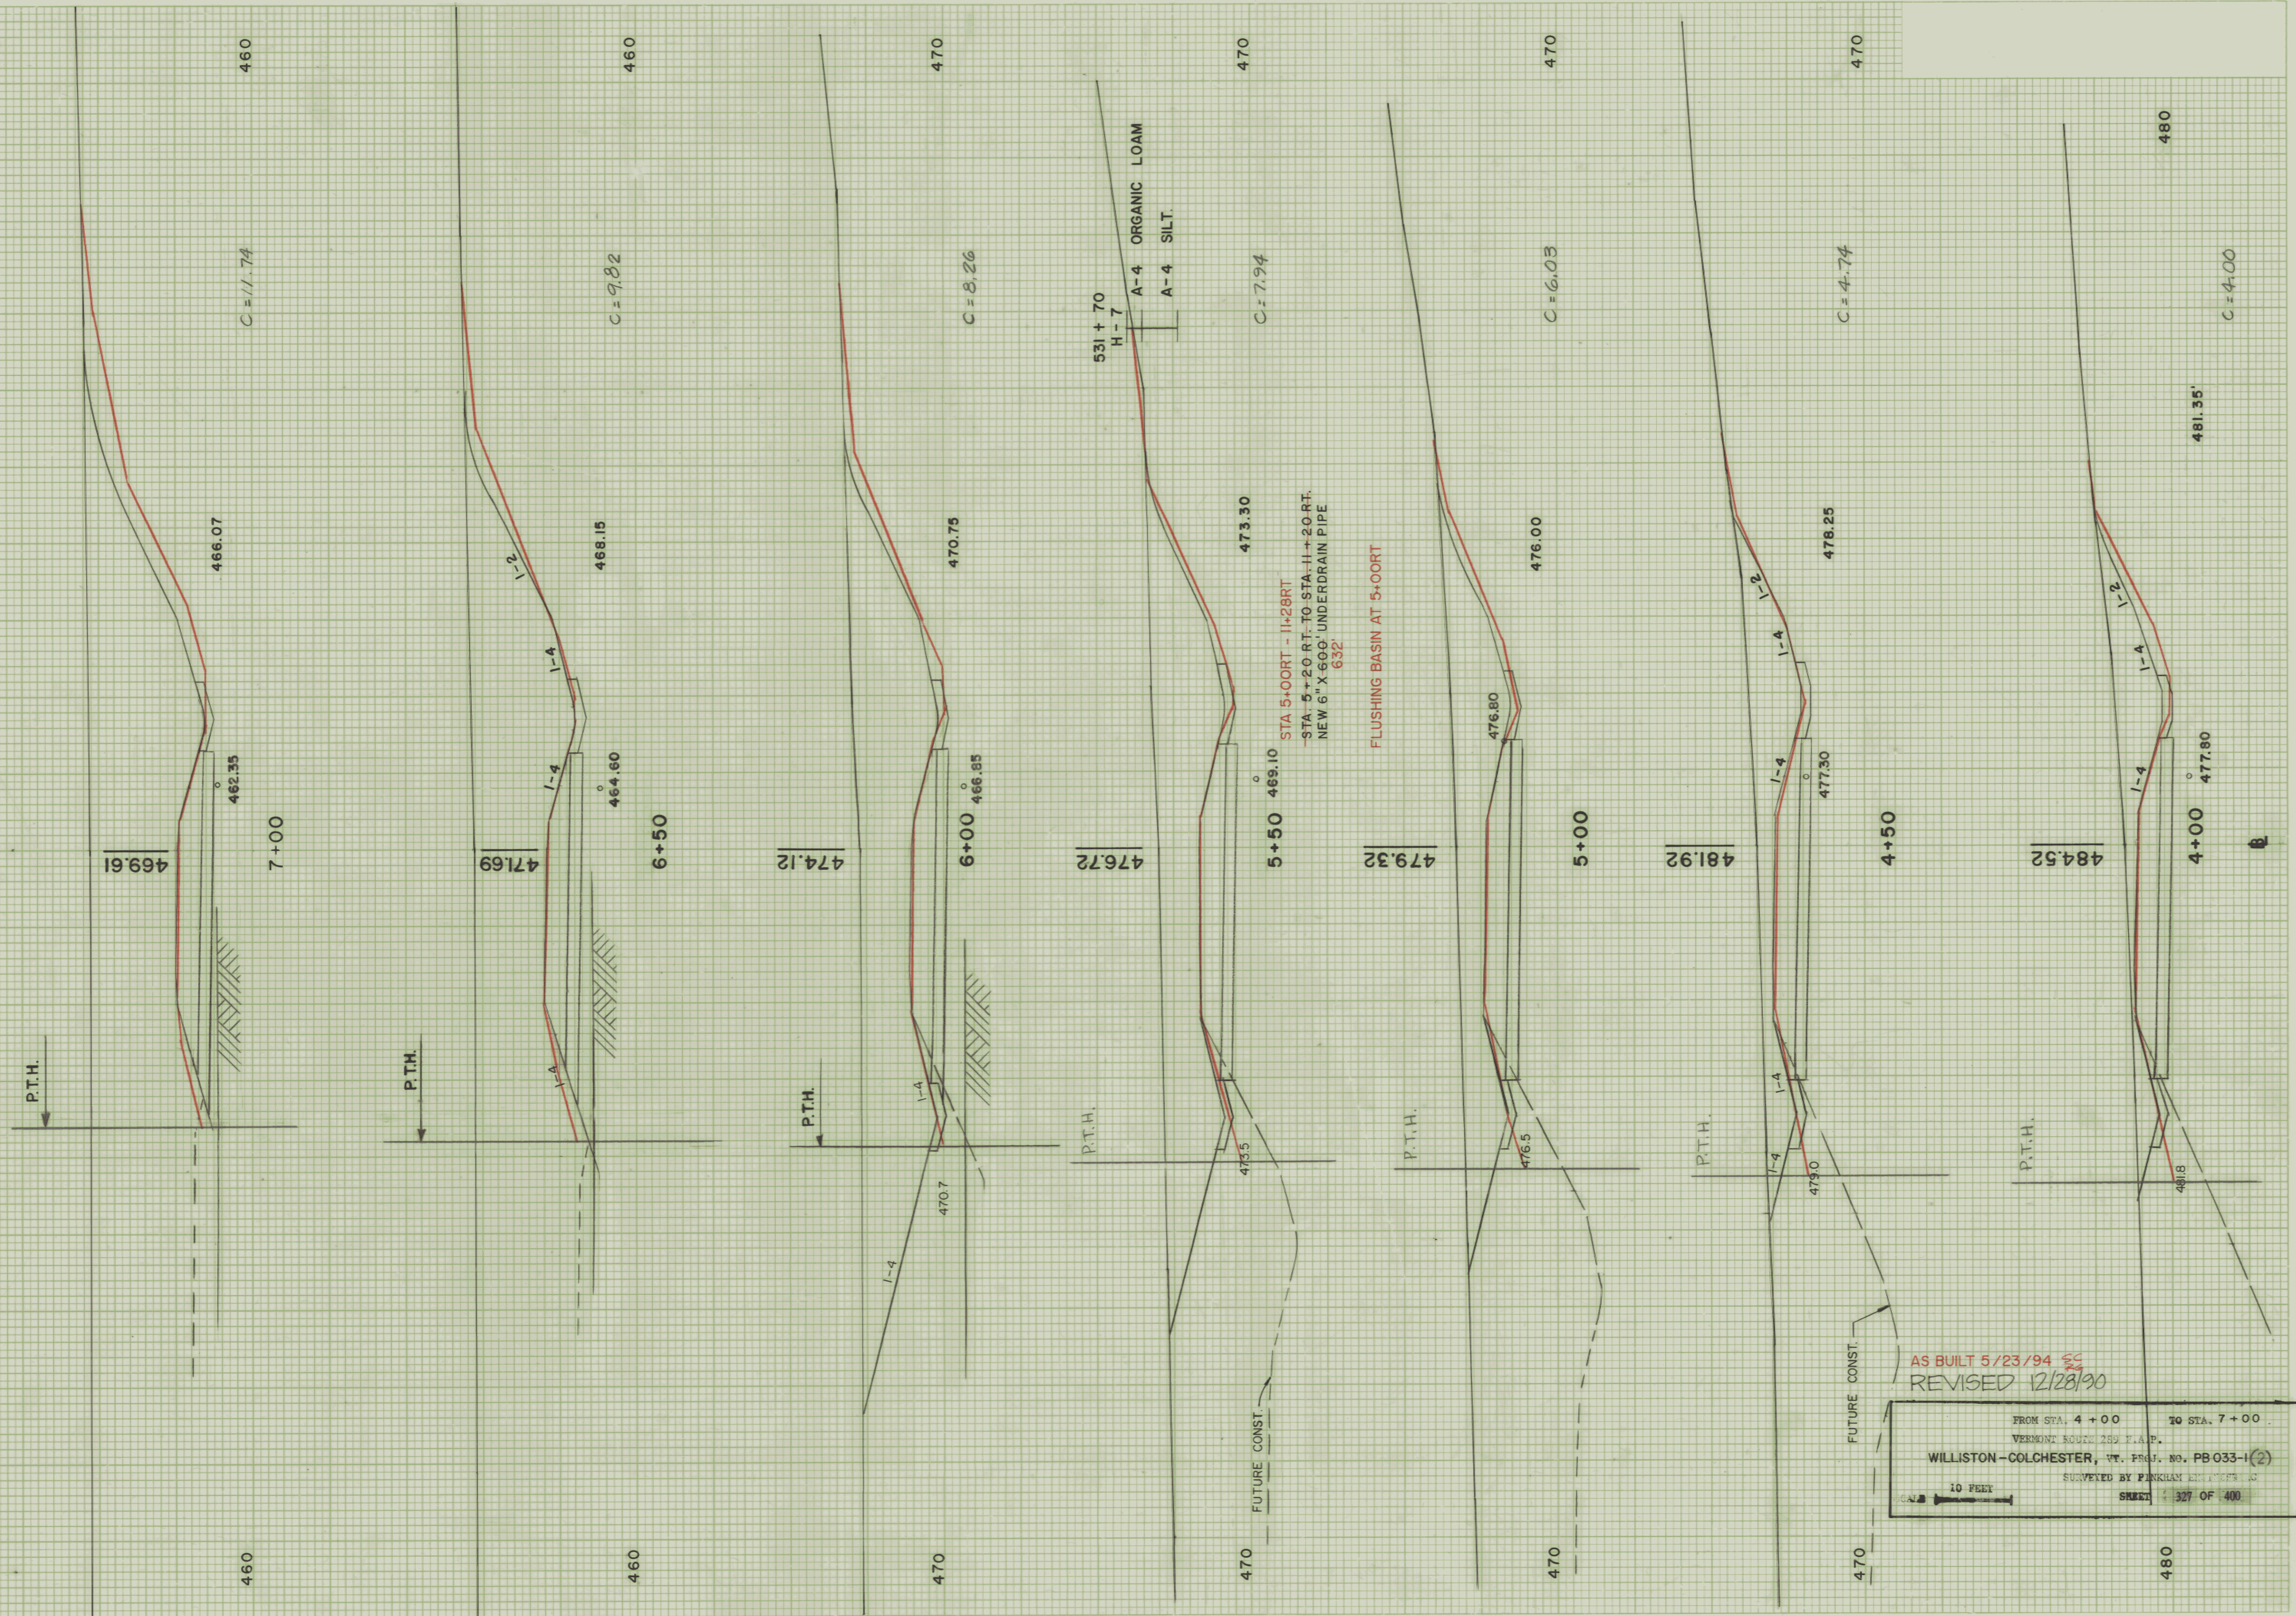

AS BUILT 5/23/94 SS
 REVISED 12/28/90

FROM STA. 4+00 TO STA. 7+00
 VERMONT SOUTH 289 RAMP
 WILLISTON-COLCHESTER, VT. PROJ. NO. PB033-1(2)
 SURVEYED BY PARKMAN ENGINEERS
 SHEET 327 OF 400

10 FEET

RTE 15 RAMP "D"