


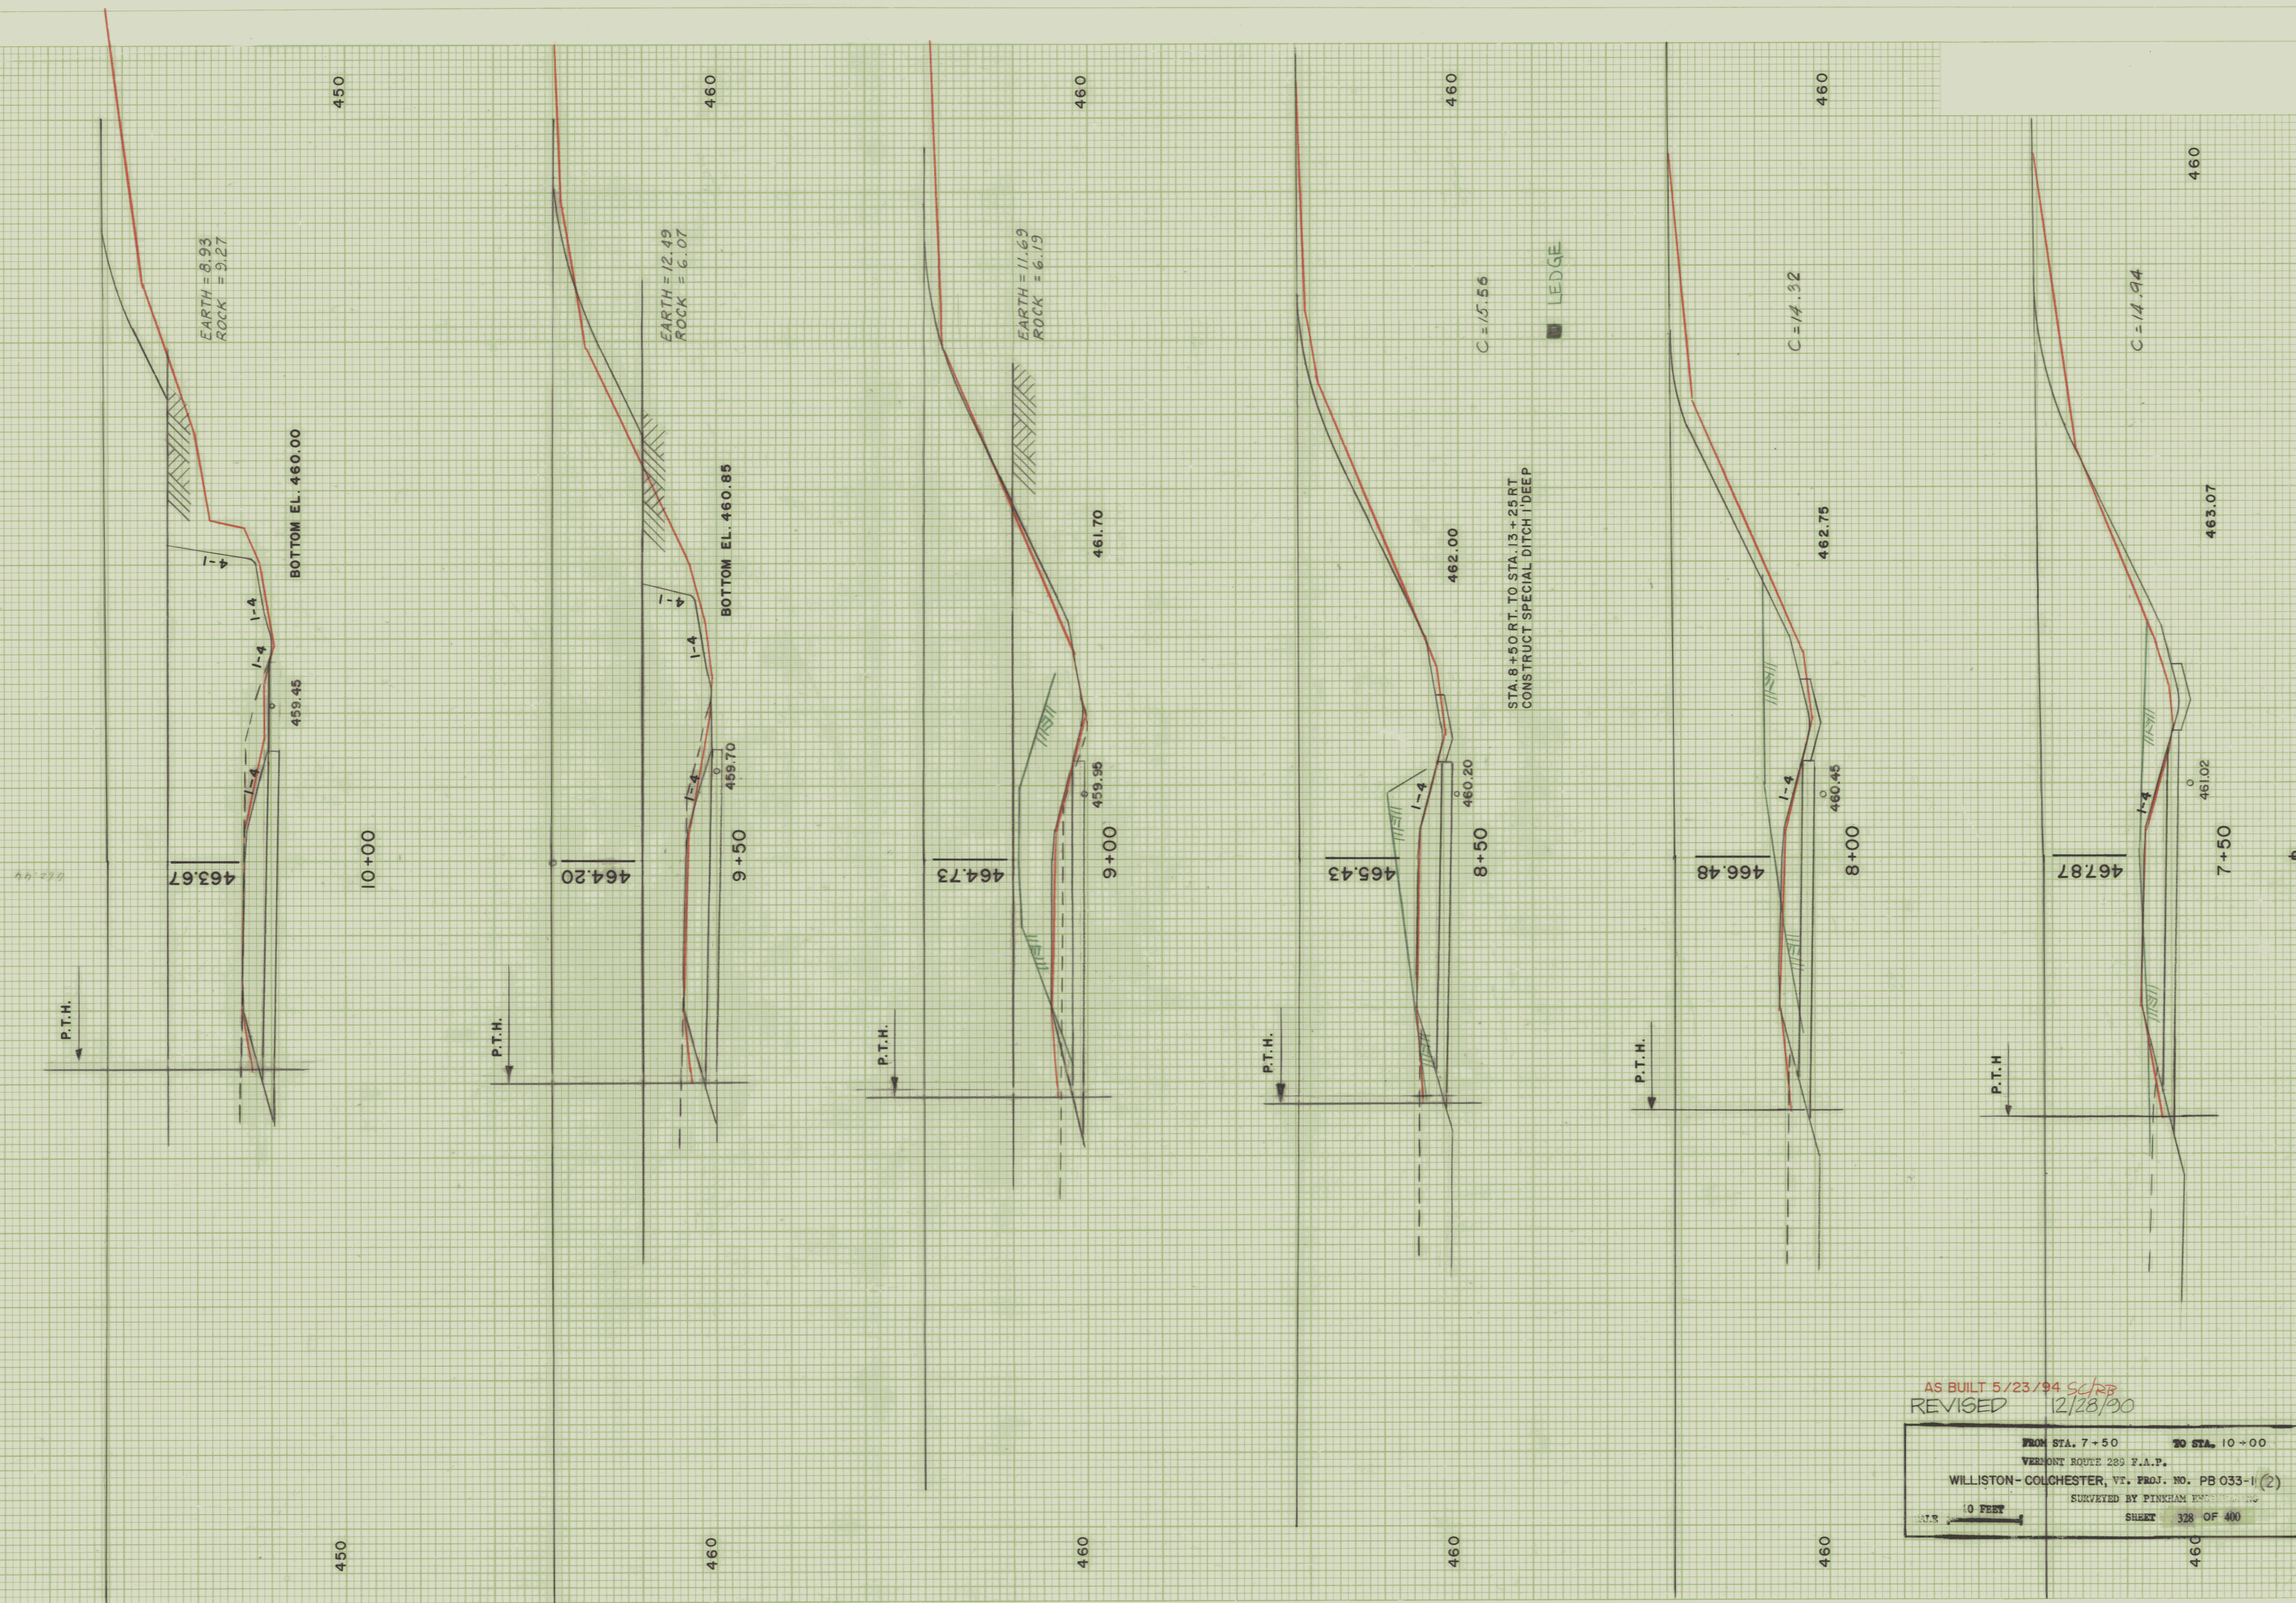

AS BUILT 5/23/94 SC/BB
 REVISED 12/28/90

FROM STA. 7+50	TO STA. 10+00
VERMONT ROUTE 289 P.A.P.	
WILLISTON-COLCHESTER, VT. PROJ. NO. PB 033-1(2)	
SURVEYED BY PINKHAM ENGINEERING	
DATE 10 FEB 90	SHEET 328 OF 400