


STA. 16+78 RT. NEW P.R.C.D.I. INV. IN 477.98 INV. OUT 481.49  
 STA. 16+80 LT. TO STA. 16+25 RT. INV. IN 494.06 INV. OUT 494.06  
 STA. 16+88 P.C.C.S.P. INV. IN 482.66 INV. OUT 481.49  
 STA. 16+77 RT. - 16+02 RT. 18"x9" P.C.C.S.P. INV. IN 480.76 INV. OUT 475.55

EXISTING 18"x150" RCP (TO BE PLUGGED)  
 STA. 16+55 LT. - 16+00 RT. 18"x232" RCP CLASS III INV. IN 476.95 INV. OUT 475.19

M3-3 MI-5 (15)

GMP #58 +70

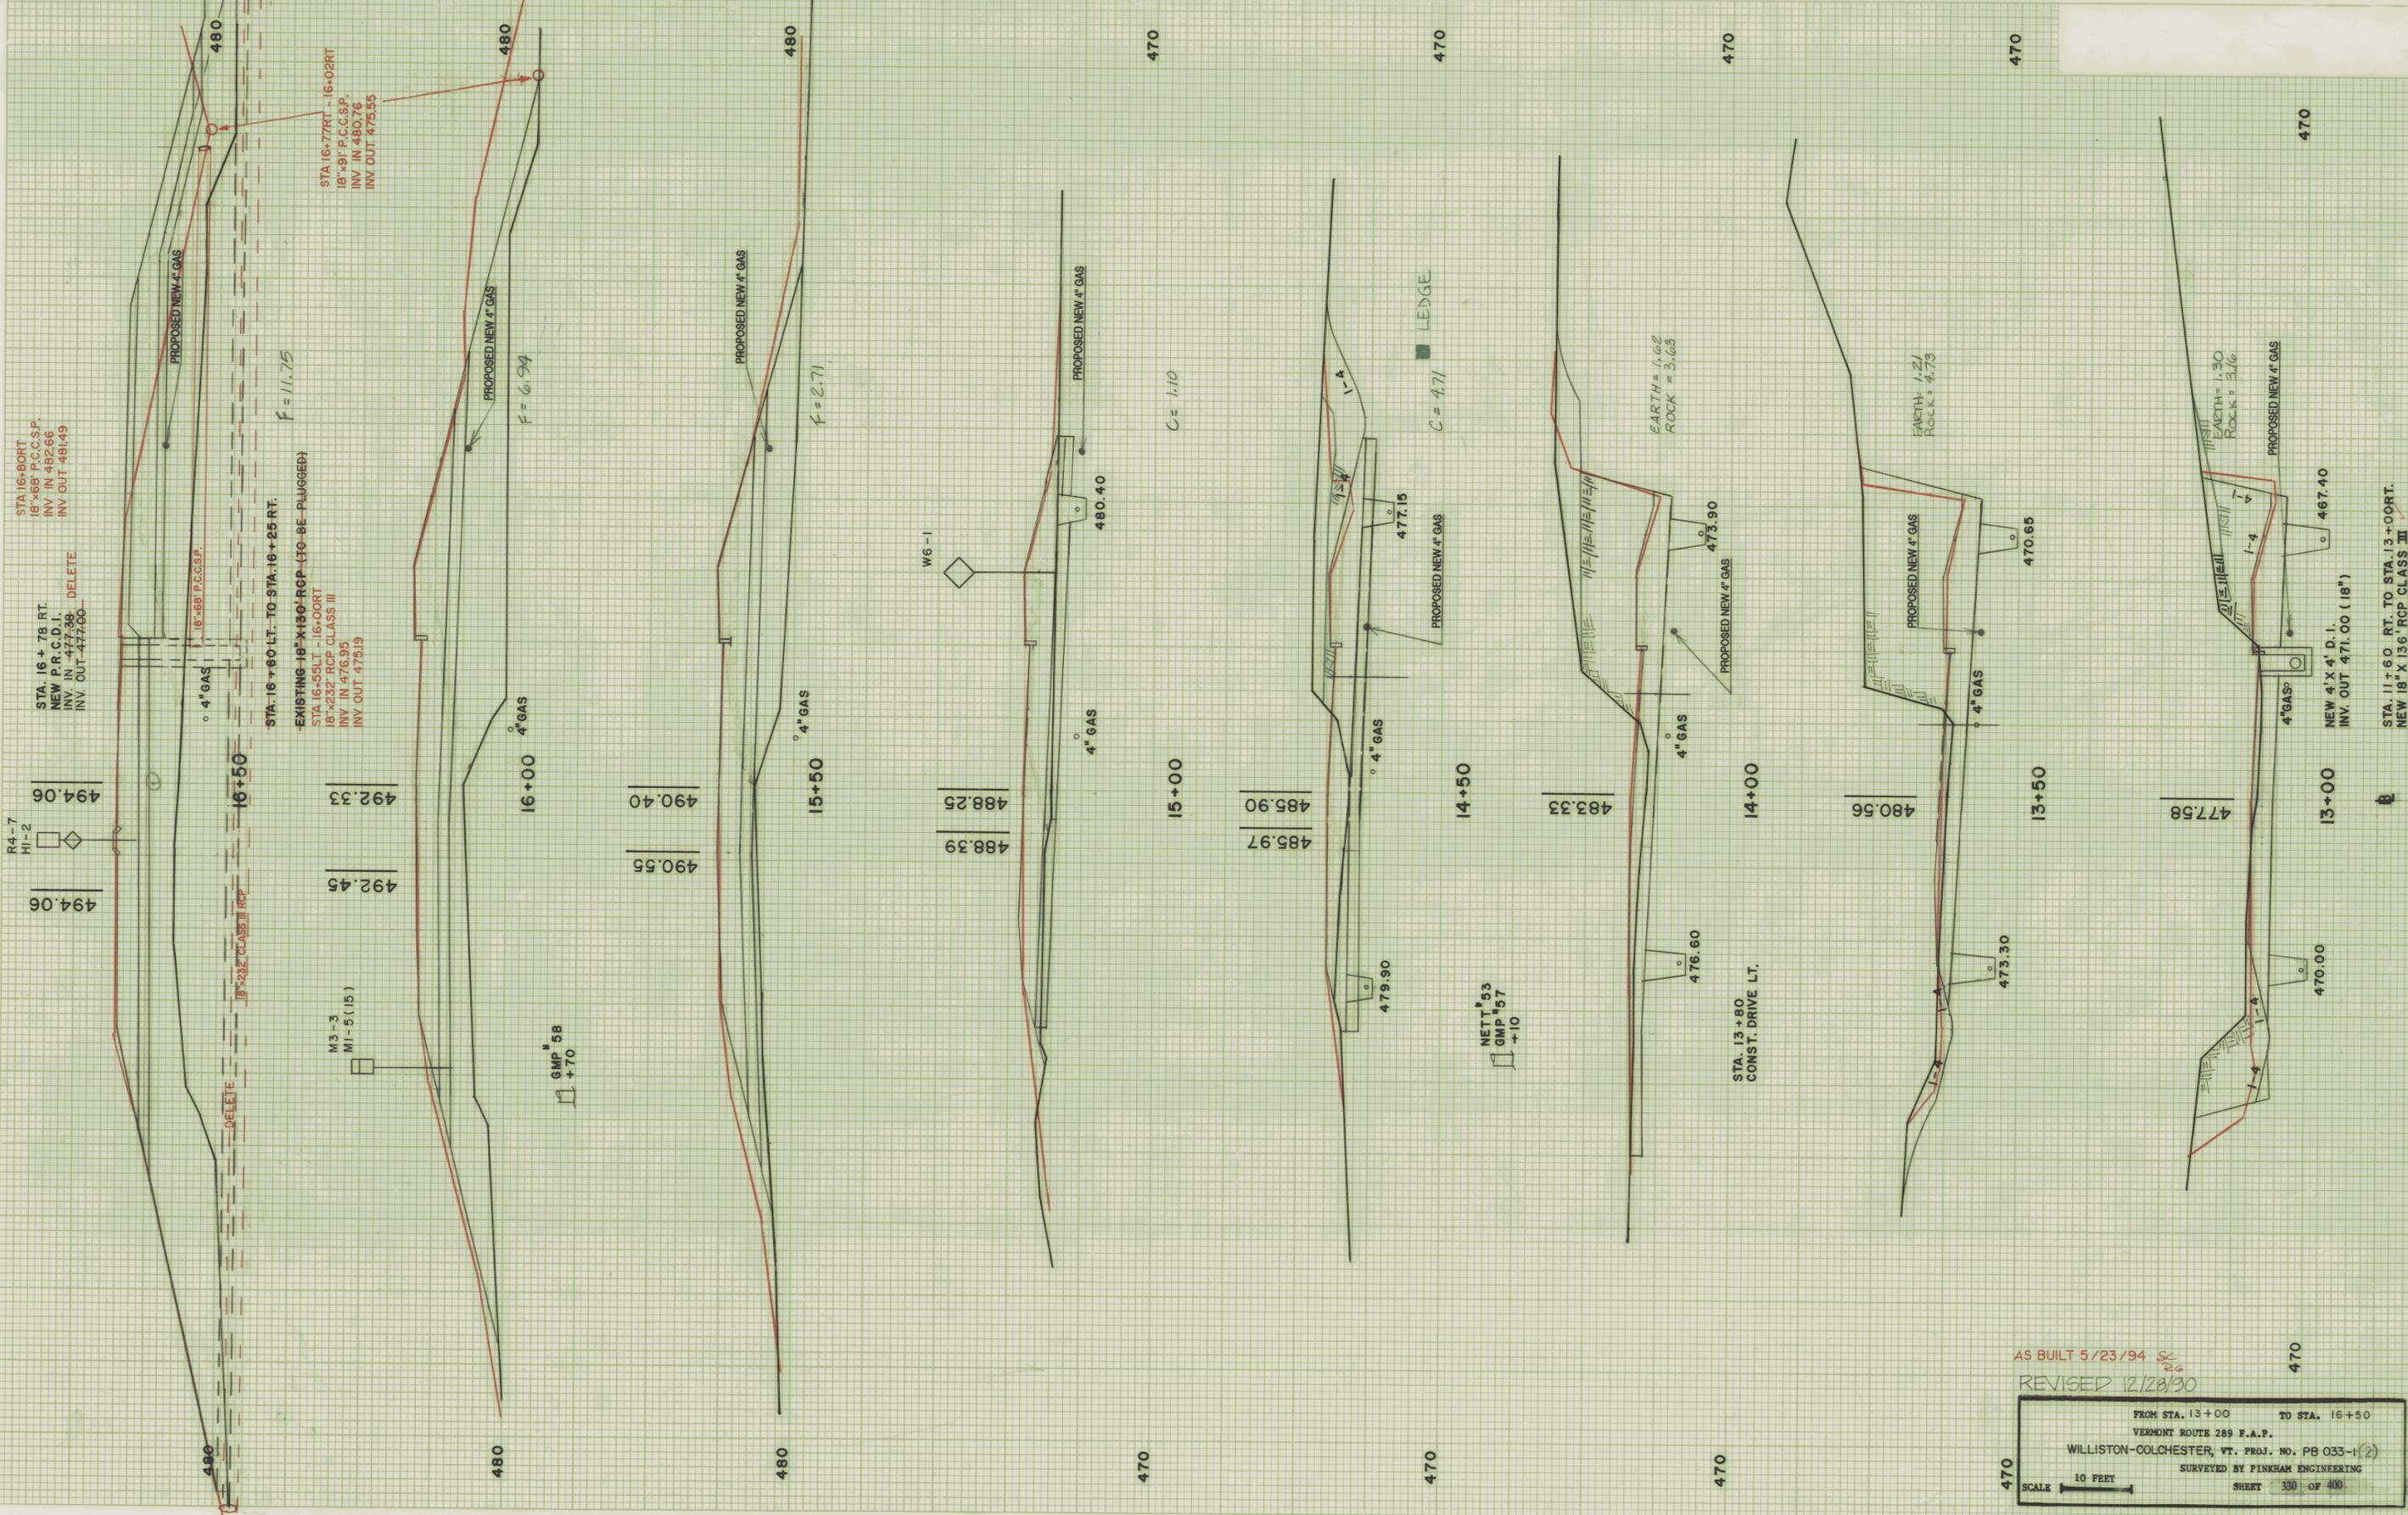

AS BUILT 5/23/94  
 REVISED 12/28/90

FROM STA. 13+00 TO STA. 16+50  
 VERMONT ROUTE 289 F.A.P.  
 WILLISTON-COLCHESTER, VT. PROJ. NO. PB 033-1(2)  
 SURVEYED BY PINKHAM ENGINEERING  
 SCALE 1" = 10 FEET  
 SHEET 330 OF 400