


NETT # 349/57
+52

NETT # 575
+52

499.64

500.40

P=7.2

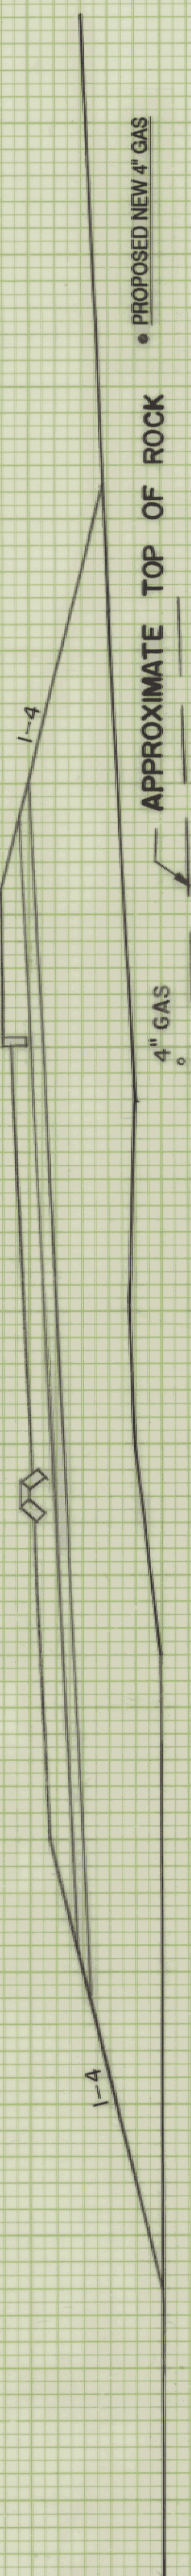

460

20+50


460

CONC. MON.
+33

499.57

500.33

F=9.17

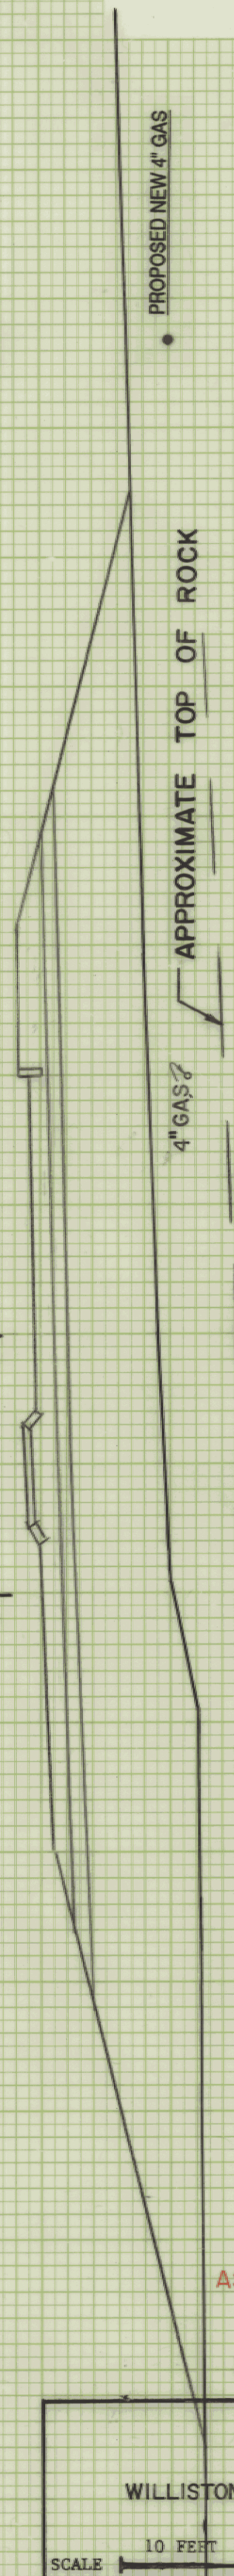

20+00

460

AS BUILT 5/23/94 SC 26

REVISED 12/28/90

FROM STA. 20+00 TO STA. 20+50	
VERMONT ROUTE 289 F.A.P.	
WILLISTON-COLCHESTER VT. PROJ. NO. PB 033-1 (2)	
SURVEYED BY PINKHAM ENGINEERING	
SHEET 332 OF 400	

SCALE 10 FEET

RTE 15