


ORIGINAL SURVEY	DATE
SURVEYED	
PLOTTED	
TEMPLATE	
AREAS CHECKED	
NO.	

FINAL SURVEY	DATE
SURVEYED	
PLOTTED	
TEMPLATE	
AREAS CHECKED	
NO.	

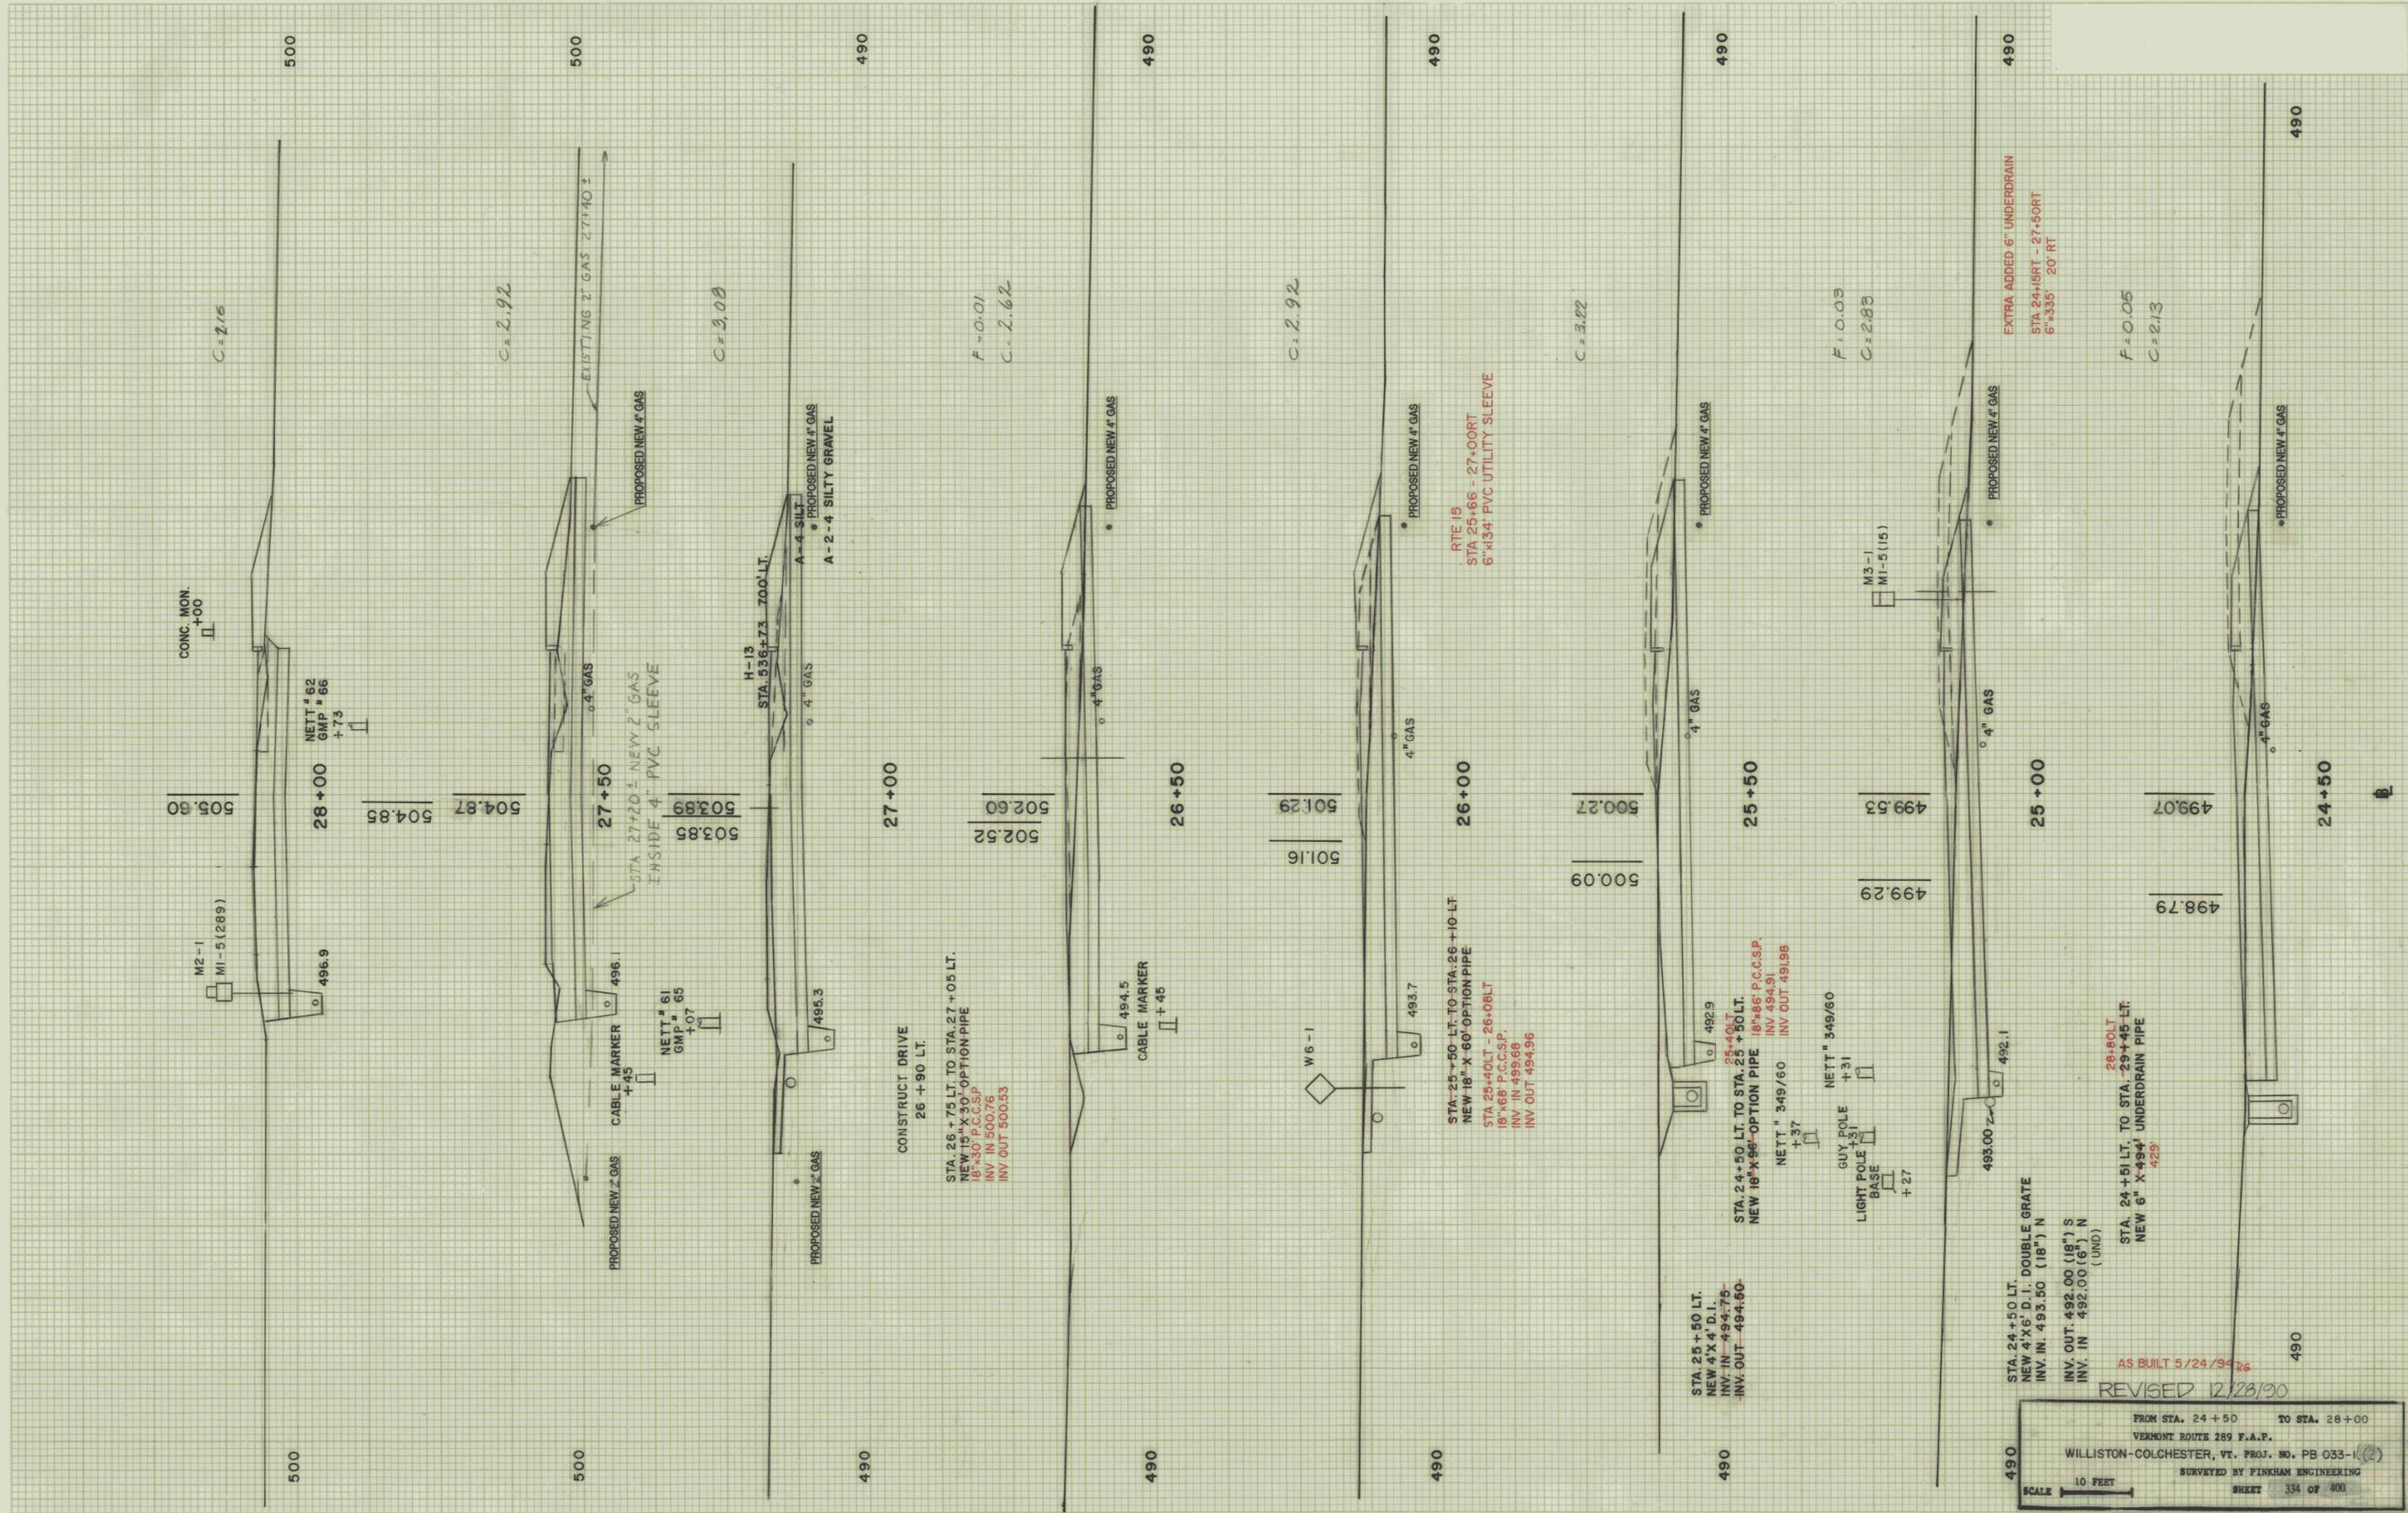

FROM STA. 24 + 50 TO STA. 28 + 00
 WILLISTON-COLCHESTER, VT. PROJ. NO. PB 033-1(2)
 SURVEYED BY PINGHAM ENGINEERING
 SHEET 334 OF 400

SCALE 10 FEET

REVISED 12/28/90

AS BUILT 5/24/94