


DATE: \_\_\_\_\_ BY: \_\_\_\_\_  
 ORIGINAL SURVEY: \_\_\_\_\_  
 SURVEY: \_\_\_\_\_  
 NOTE BOOK: \_\_\_\_\_  
 NO. \_\_\_\_\_

DATE: \_\_\_\_\_ BY: \_\_\_\_\_  
 ORIGINAL SURVEY: \_\_\_\_\_  
 SURVEY: \_\_\_\_\_  
 NOTE BOOK: \_\_\_\_\_  
 NO. \_\_\_\_\_

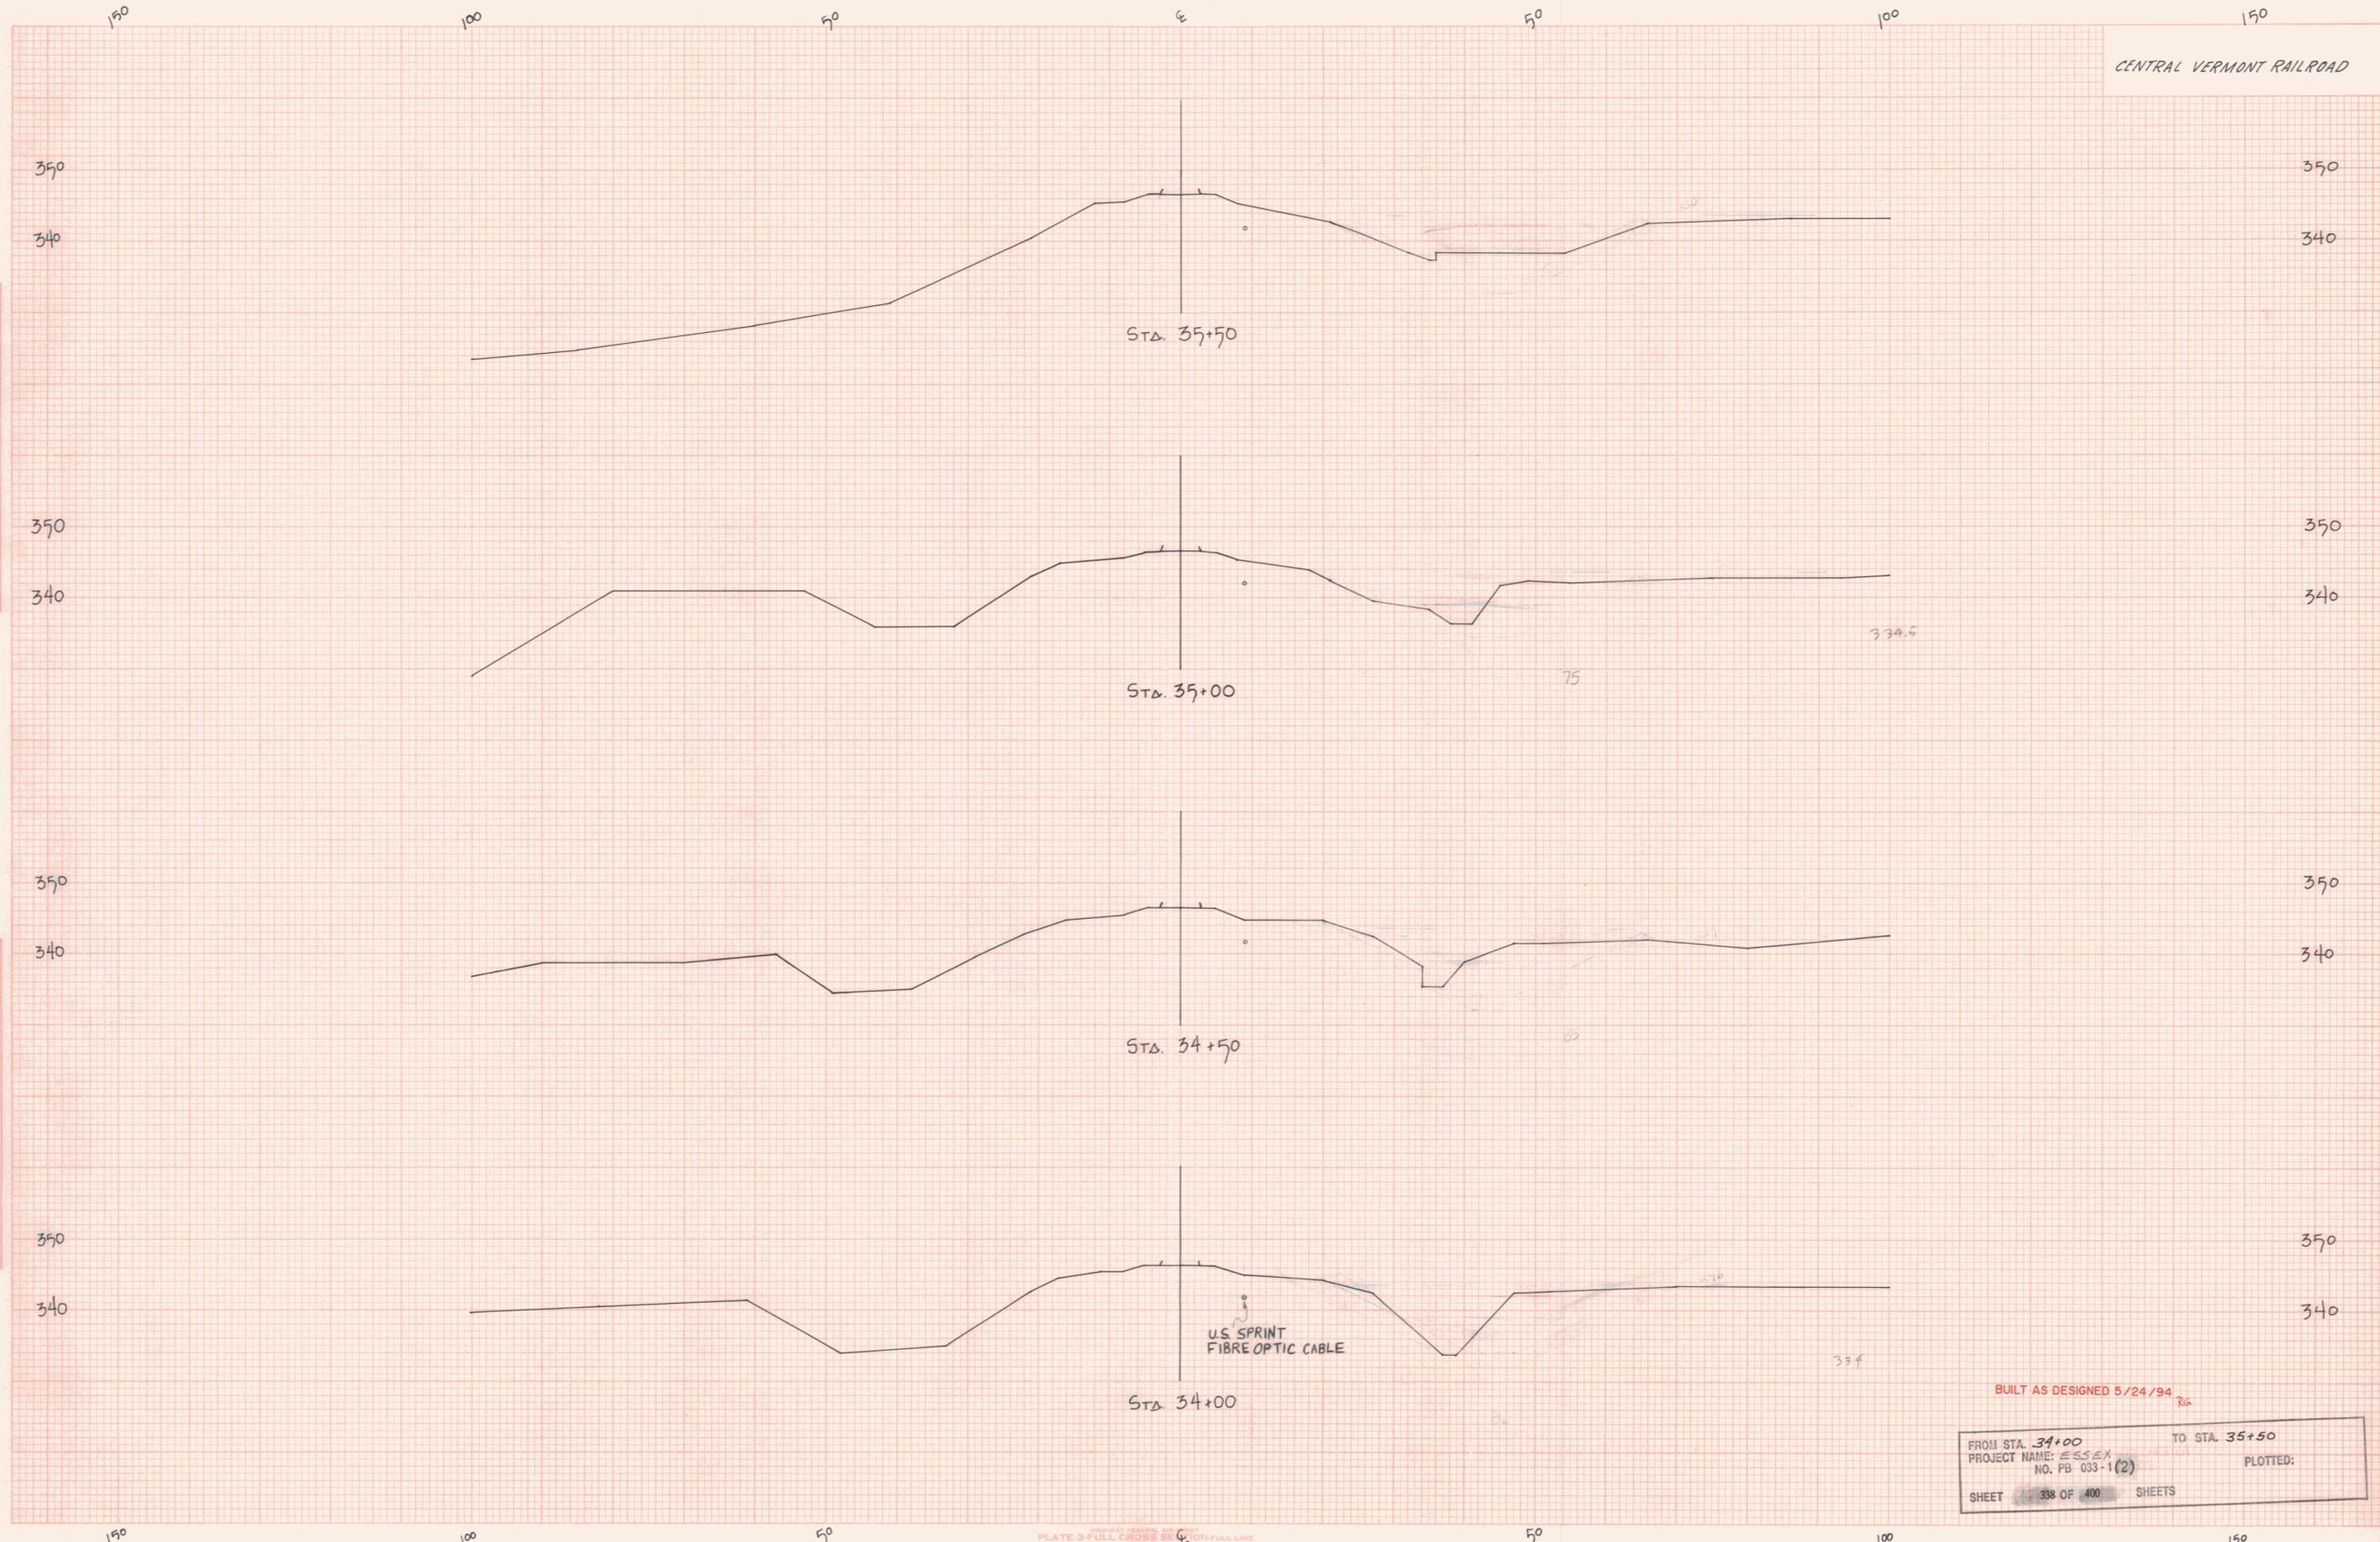

BUILT AS DESIGNED 5/24/94 RGA

FROM STA. 34+00 TO STA. 35+50  
 PROJECT NAME: ESSEX  
 NO. PB 033-1(2) PLOTTED:  
 SHEET 338 OF 400 SHEETS