


FINAL SURVEY  
 DATE: \_\_\_\_\_ BY: \_\_\_\_\_  
 ORIGINAL SURVEY  
 DATE: \_\_\_\_\_ BY: \_\_\_\_\_  
 NOTE BOOK TEMP. ATT. NO. \_\_\_\_\_  
 NO. \_\_\_\_\_

ORIGINAL SURVEY  
 DATE: \_\_\_\_\_ BY: \_\_\_\_\_  
 ORIGINAL SURVEY  
 DATE: \_\_\_\_\_ BY: \_\_\_\_\_  
 NOTE BOOK TEMP. ATT. NO. \_\_\_\_\_  
 NO. \_\_\_\_\_

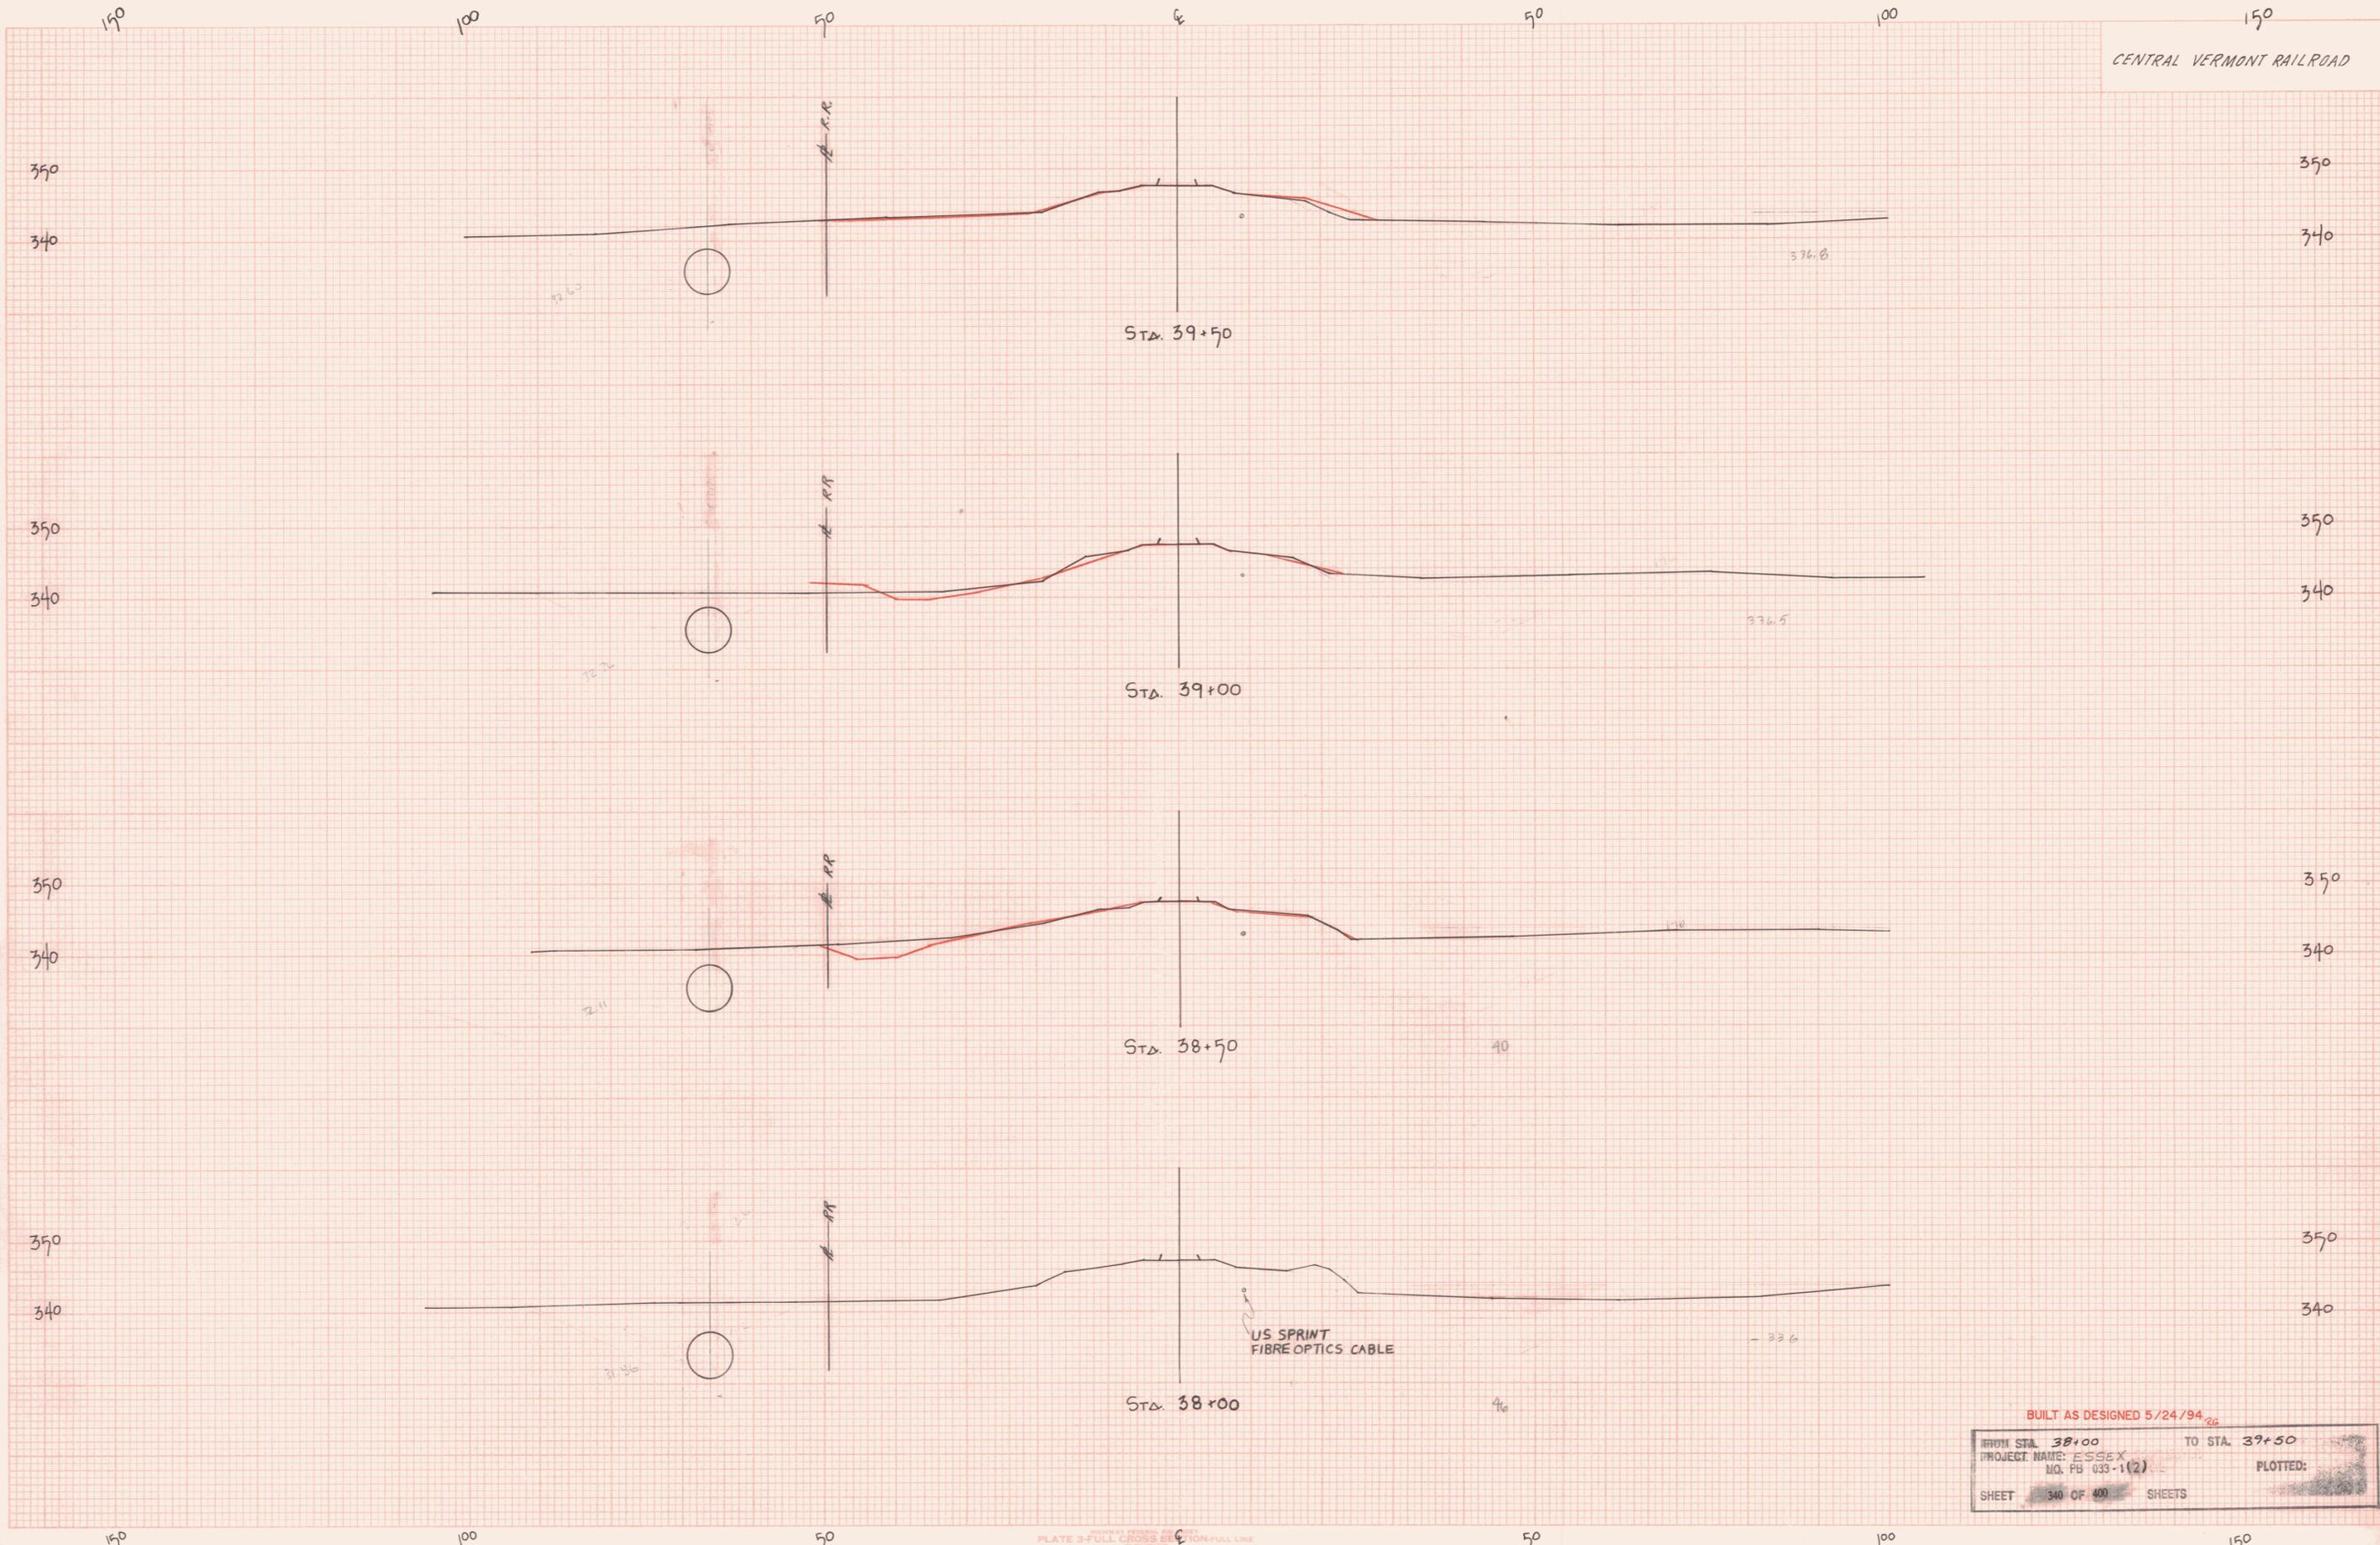

BUILT AS DESIGNED 5/24/94<sub>26</sub>  
 FROM STA. 38+00 TO STA. 39+50  
 PROJECT NAME: ESSEX  
 NO. PB 033-1(2) PLOTTED: \_\_\_\_\_  
 SHEET 340 OF 400 SHEETS