



STA 41+50 LT-RT.  
(STRUCTURE NO. 11)  
NEW 5'-0" DIA. GALV. STR. ST. LINER PLATE PIPE X 59'  
W/ CONG. HEADWALLS AT INLET AND OUTLET  
REFER TO SHEETS BR 10 & 103

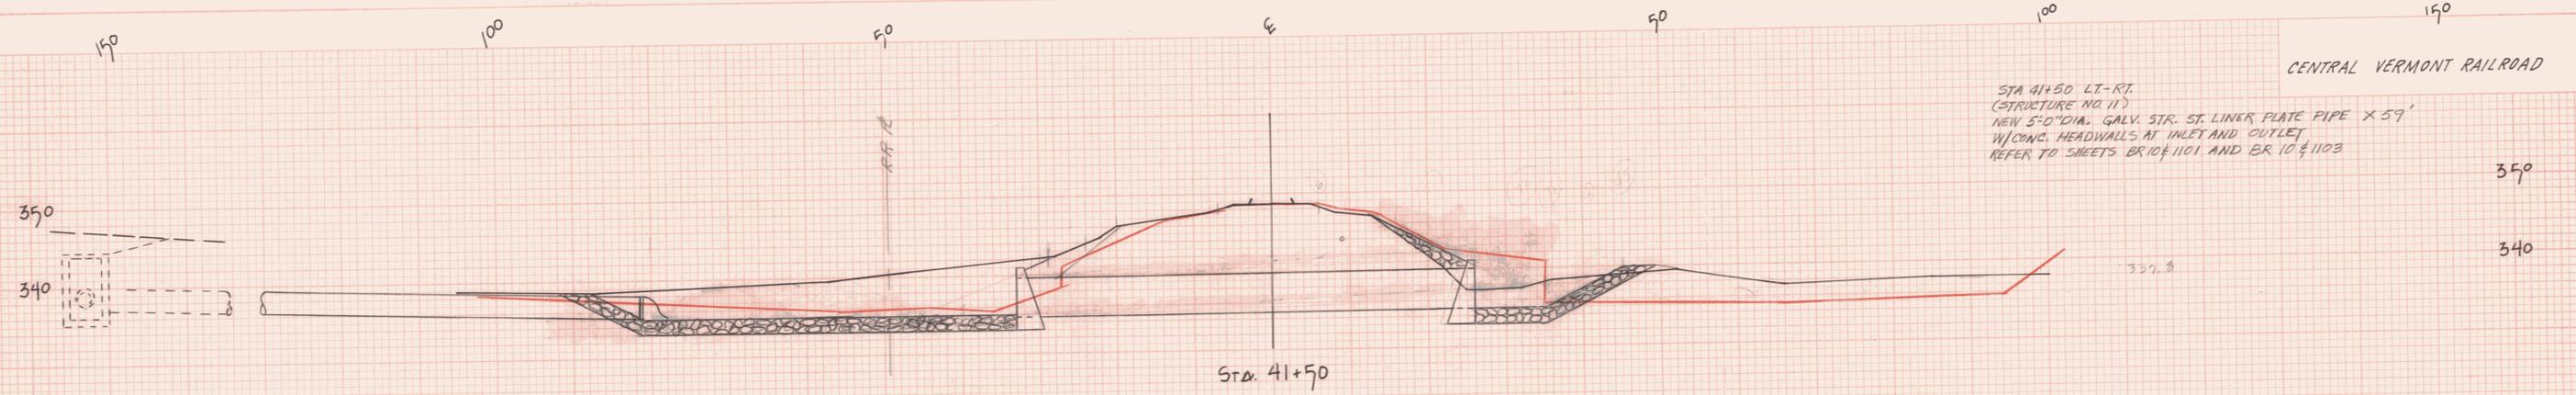

STA. 41+50

ST. 41+05  
STA 41+05 LT-RT  
EXISTING BOX CULVERT  
TO BE CLEANED  
FILLED IN AND ABANDONED

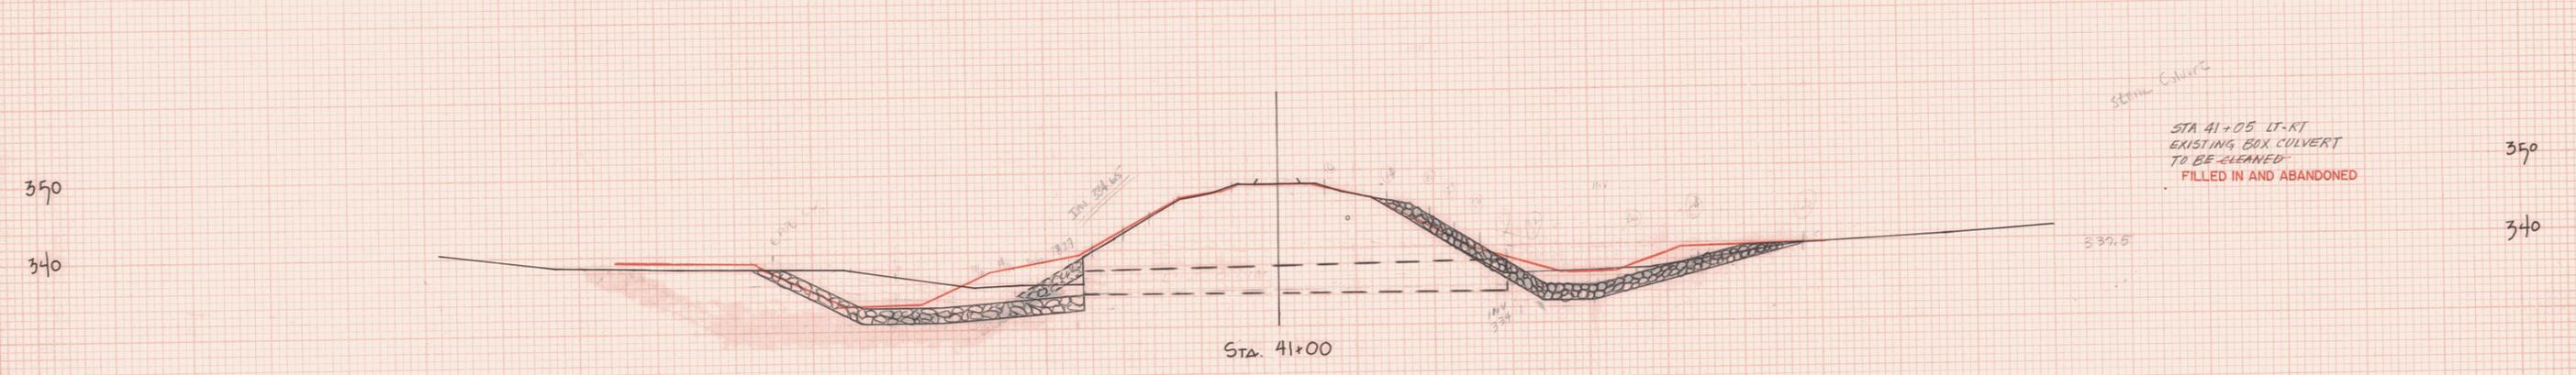

STA. 41+00



STA. 40+50

STA 40+00 - 43+30 LT.  
SPECIAL DITCH W/ STONE  
FILL TYPE II



STA. 40+00

STA 39+75 - 44+50 RT  
SPECIAL DITCH W/ STONE  
FILL TYPE II

AS BUILT 5/24/94

FROM STA. 40+00	TO STA. 41+50
PROJECT NAME: ESSEX	PLOTTED:
NO. FB 033-1 (2)	
SHEET 341 OF 400 SHEETS	