


FINAL SURVEY BY DATE
 SURVEYED BY
 PLOTTED BY
 CHECKED BY
 DATE

ORIGINAL SURVEY BY DATE
 SURVEYED BY
 PLOTTED BY
 CHECKED BY
 DATE

STA 43+17-44+47 LT
 NEW 24" X 130" RCC SP. 064
 OR C.A.P. 060
 W/ CONC. HEADWALLS AT INLET
 AND OUTLET
 INV IN 339.00
 INV OUT 337.50

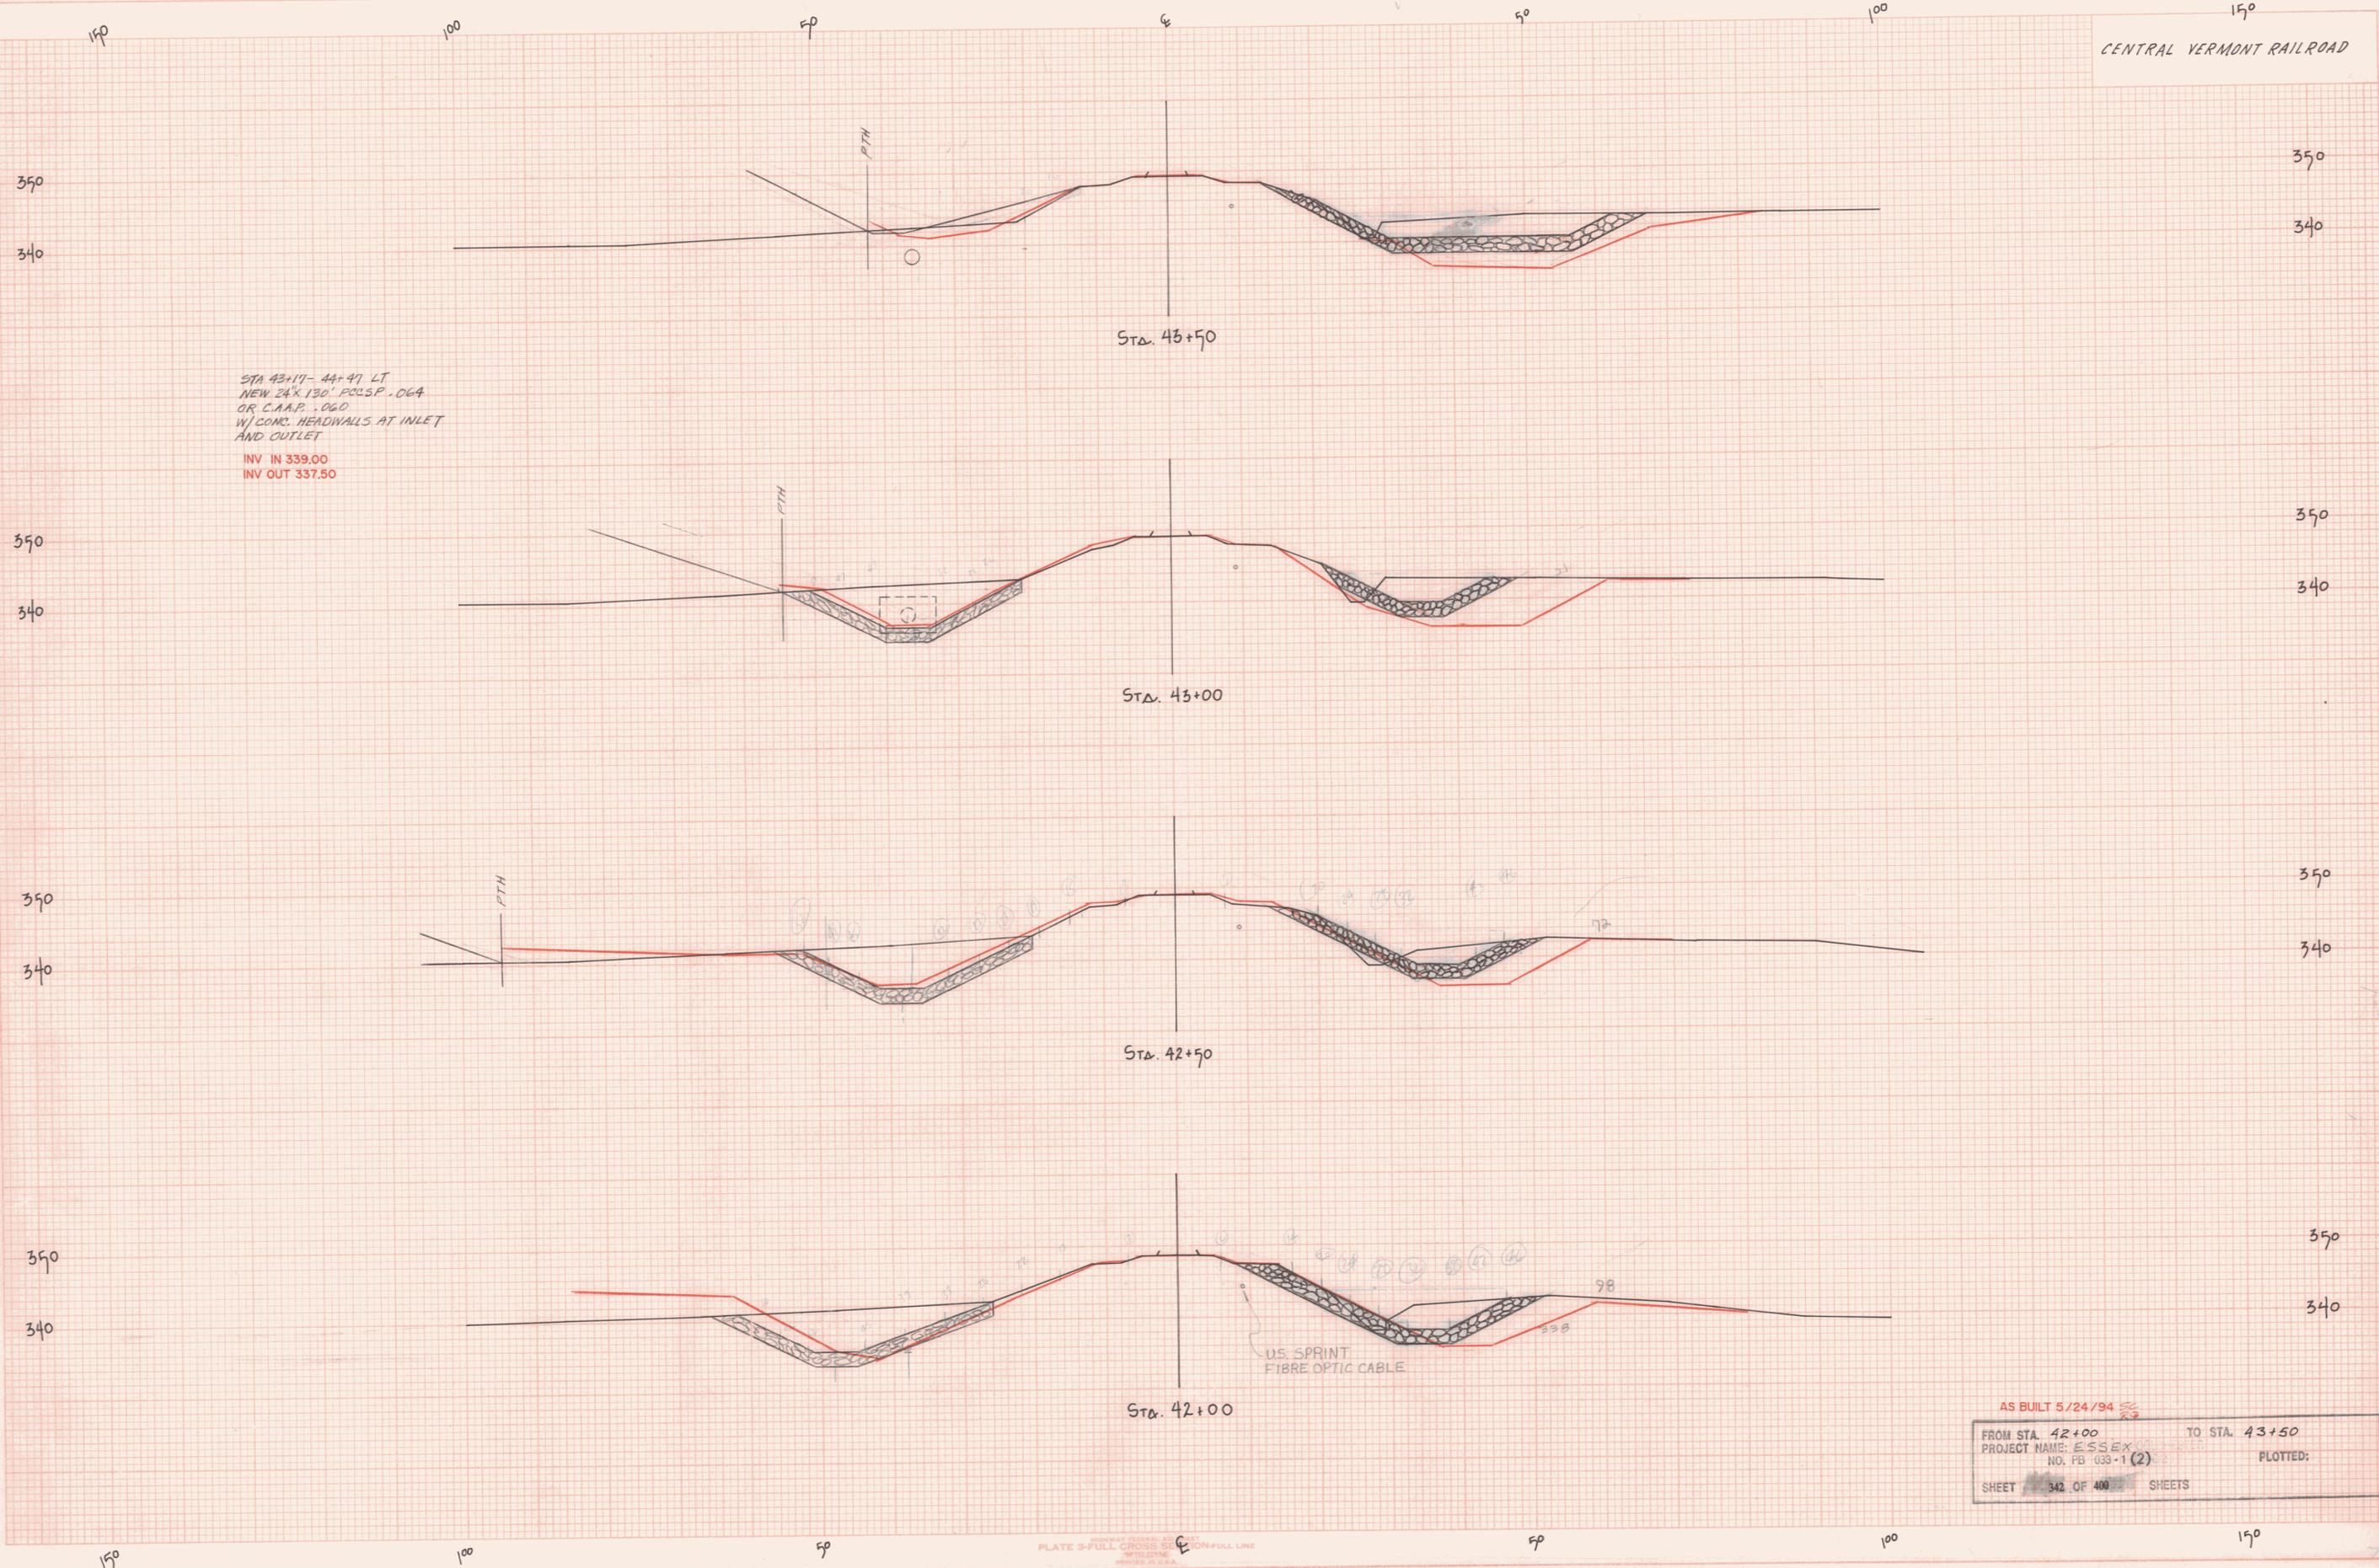

AS BUILT 5/24/94
 FROM STA. 42+00 TO STA. 43+50
 PROJECT NAME: ESSEX
 NO. FB 033-1(2) PLOTTED:
 SHEET 342 OF 400 SHEETS