

150

50



100

50

E

50

100

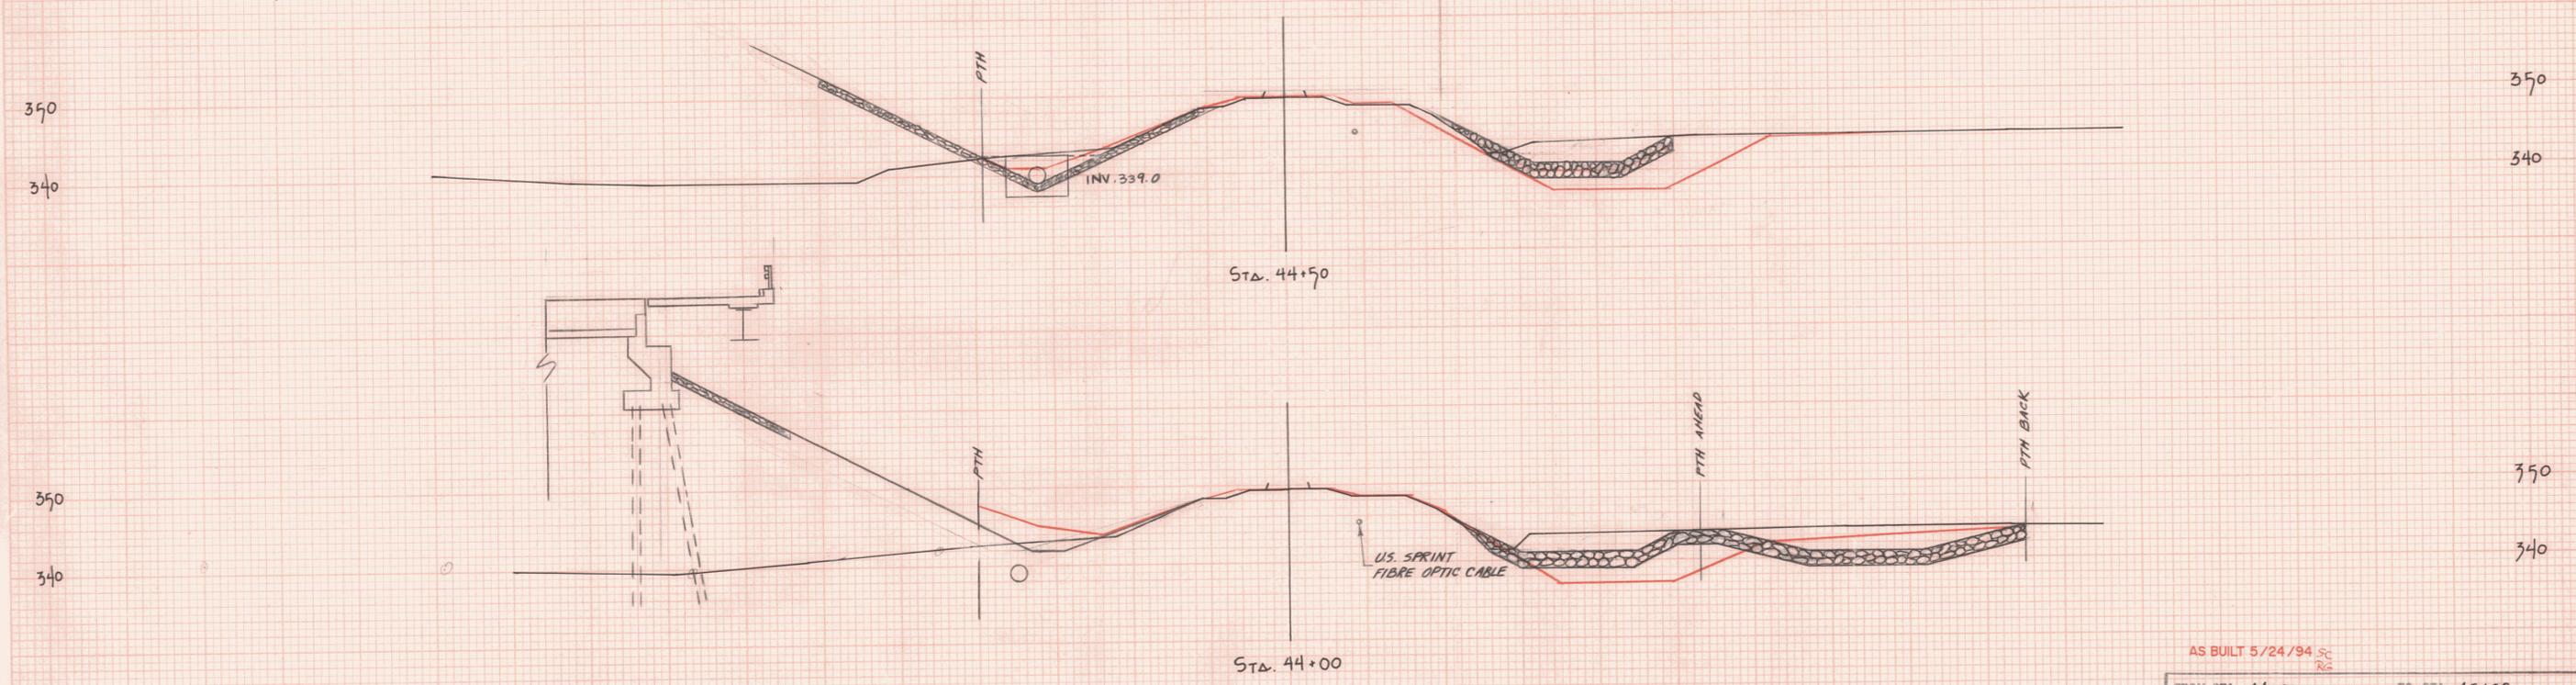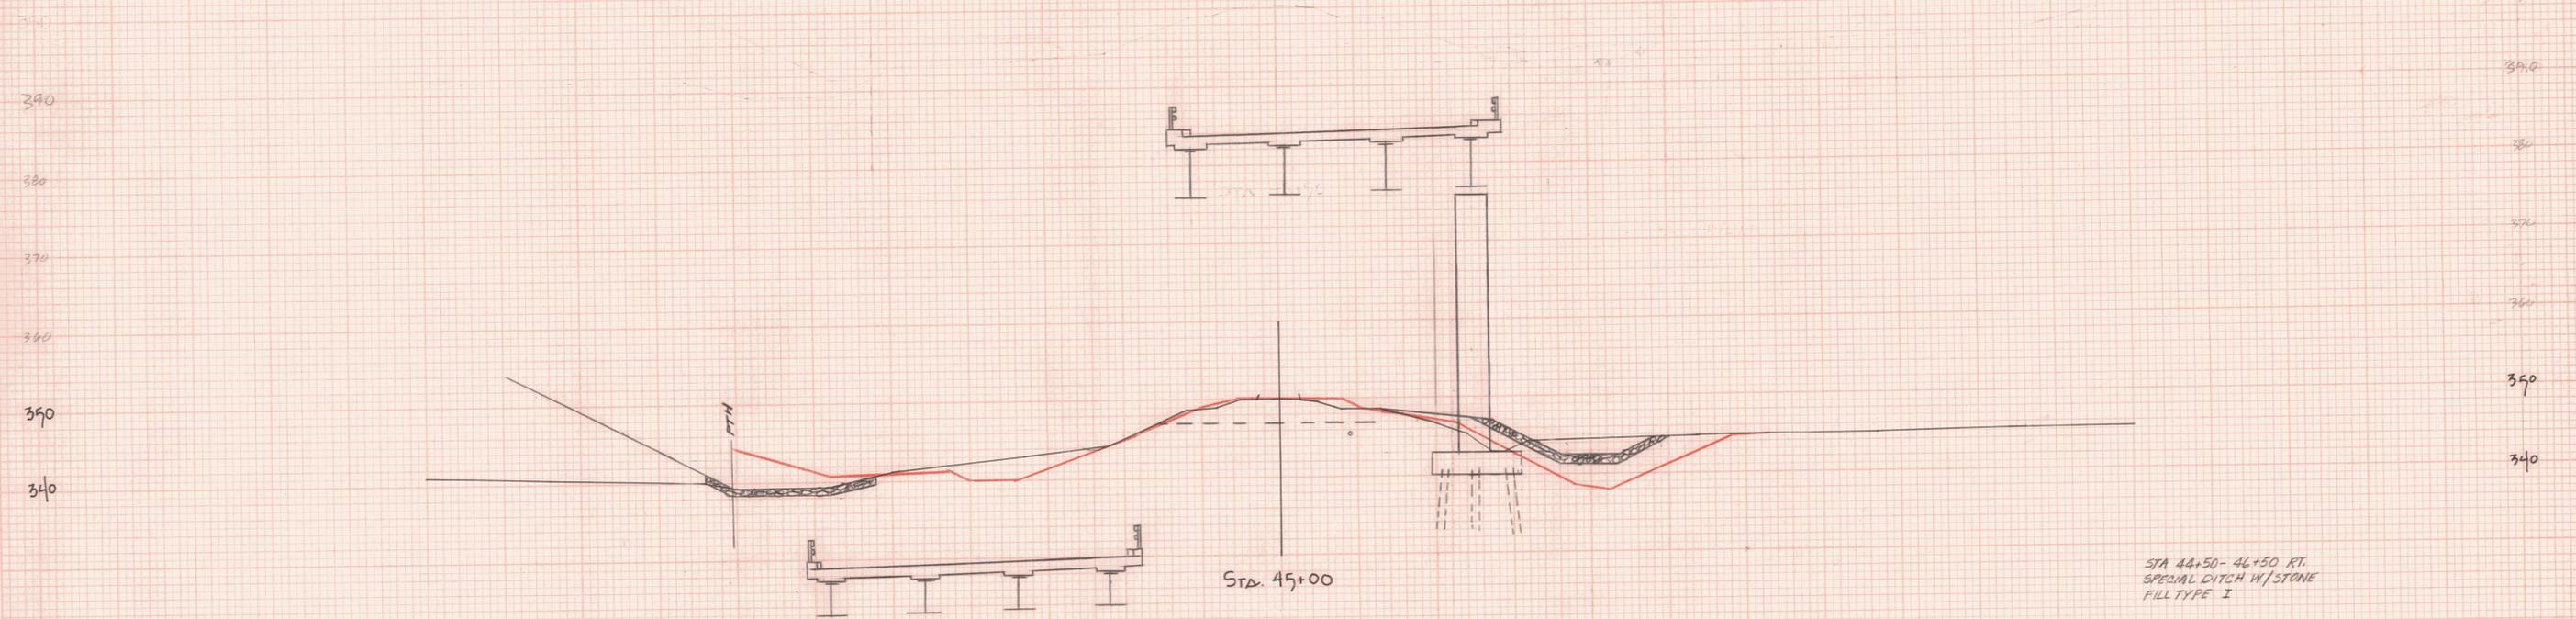

AS BUILT 5/24/94 SC
RC

FROM STA. 44+00	TO STA. 45+00
PROJECT NAME: ESSEX	
NO. FB 033-1 (2)	
SHEET 343 OF 400 SHEETS	PLOTTED:

PLATE 3-FULL CROSS SECTION FULL LINE
PRINTED IN U.S.A.