


DATE \_\_\_\_\_  
 BY \_\_\_\_\_  
 RECEIVED \_\_\_\_\_  
 SURVEY \_\_\_\_\_  
 PLOTTED \_\_\_\_\_  
 NOTE BOOK \_\_\_\_\_  
 NO. \_\_\_\_\_  
 AREA STUDIED \_\_\_\_\_

DATE \_\_\_\_\_  
 BY \_\_\_\_\_  
 RECEIVED \_\_\_\_\_  
 SURVEY \_\_\_\_\_  
 PLOTTED \_\_\_\_\_  
 NOTE BOOK \_\_\_\_\_  
 NO. \_\_\_\_\_  
 AREA STUDIED \_\_\_\_\_

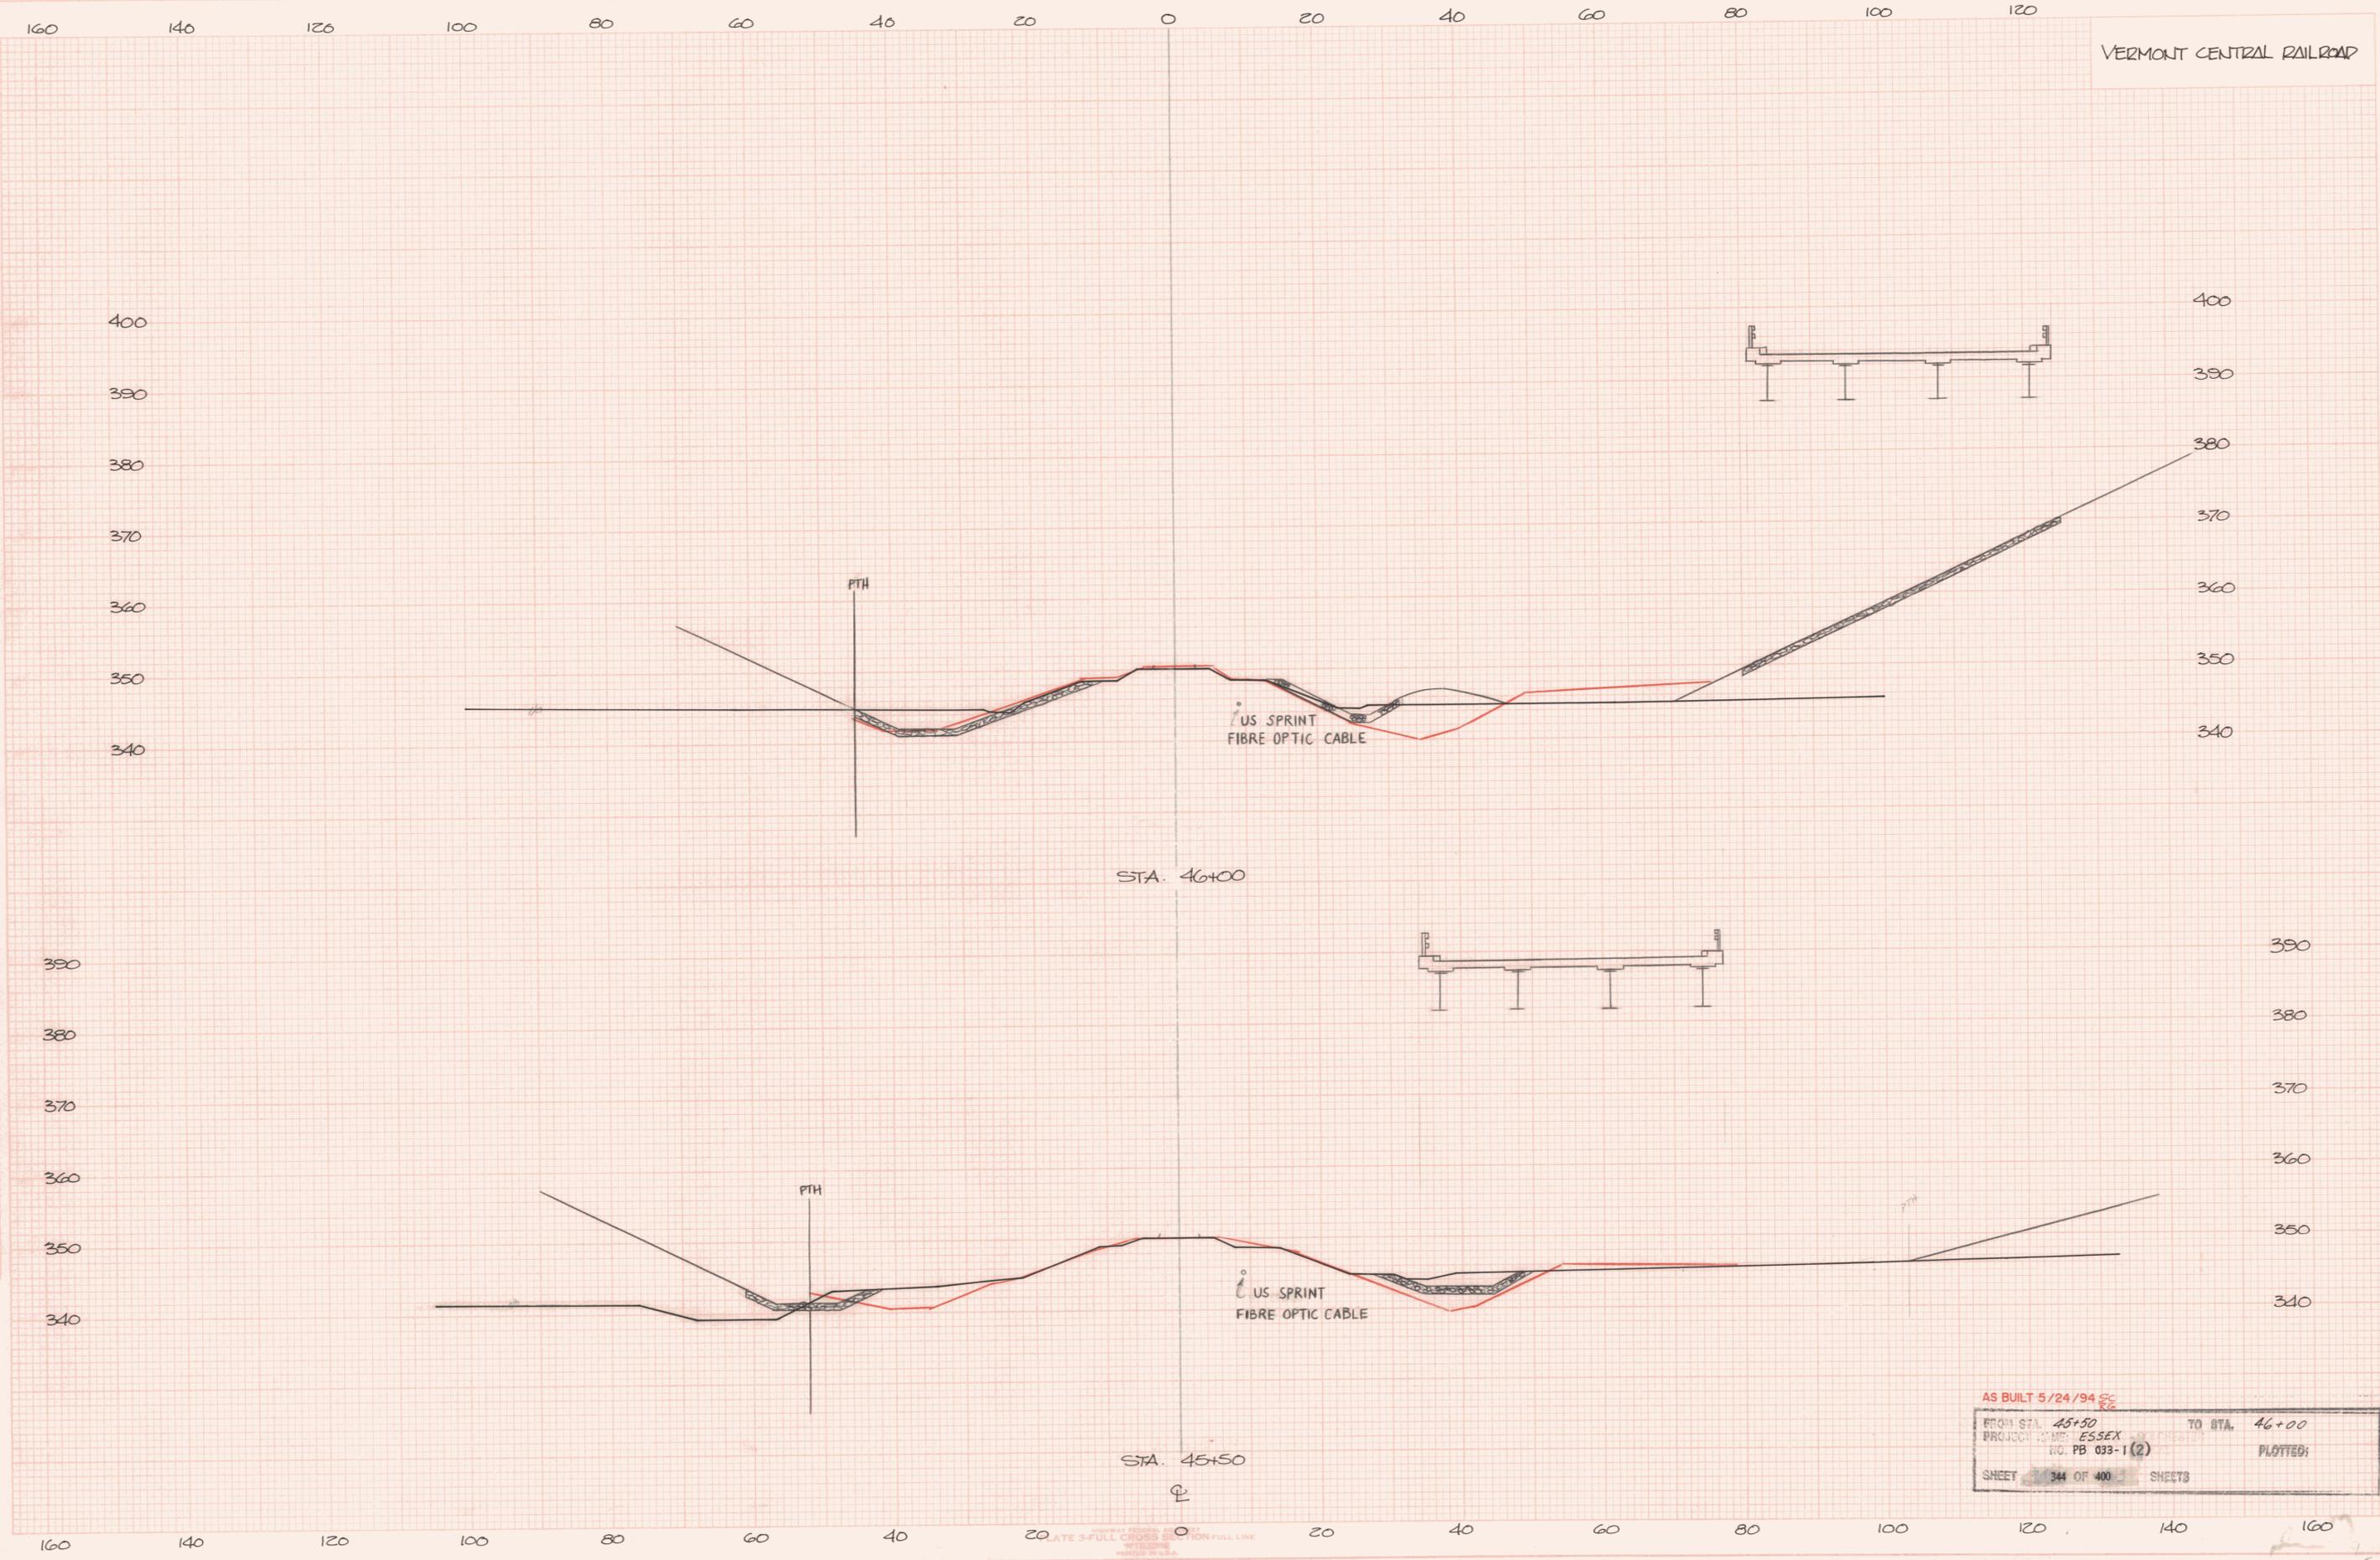

AS BUILT 5/24/94 <sup>SC</sup> <sub>EE</sub>  
 FROM STA. 45+50 TO STA. 46+00  
 PROJECT NO. ESSEX  
 NO. PB 033-1 (2) PLOTTED:  
 SHEET 344 OF 400 SHEETS