


FINAL SURVEY
SUPERVISOR
PLOTTED
NOTE BOOK
NO. 100
DATE

ORIGINAL SURVEY
SUPERVISOR
PLOTTED
NOTE BOOK
NO. 100
DATE

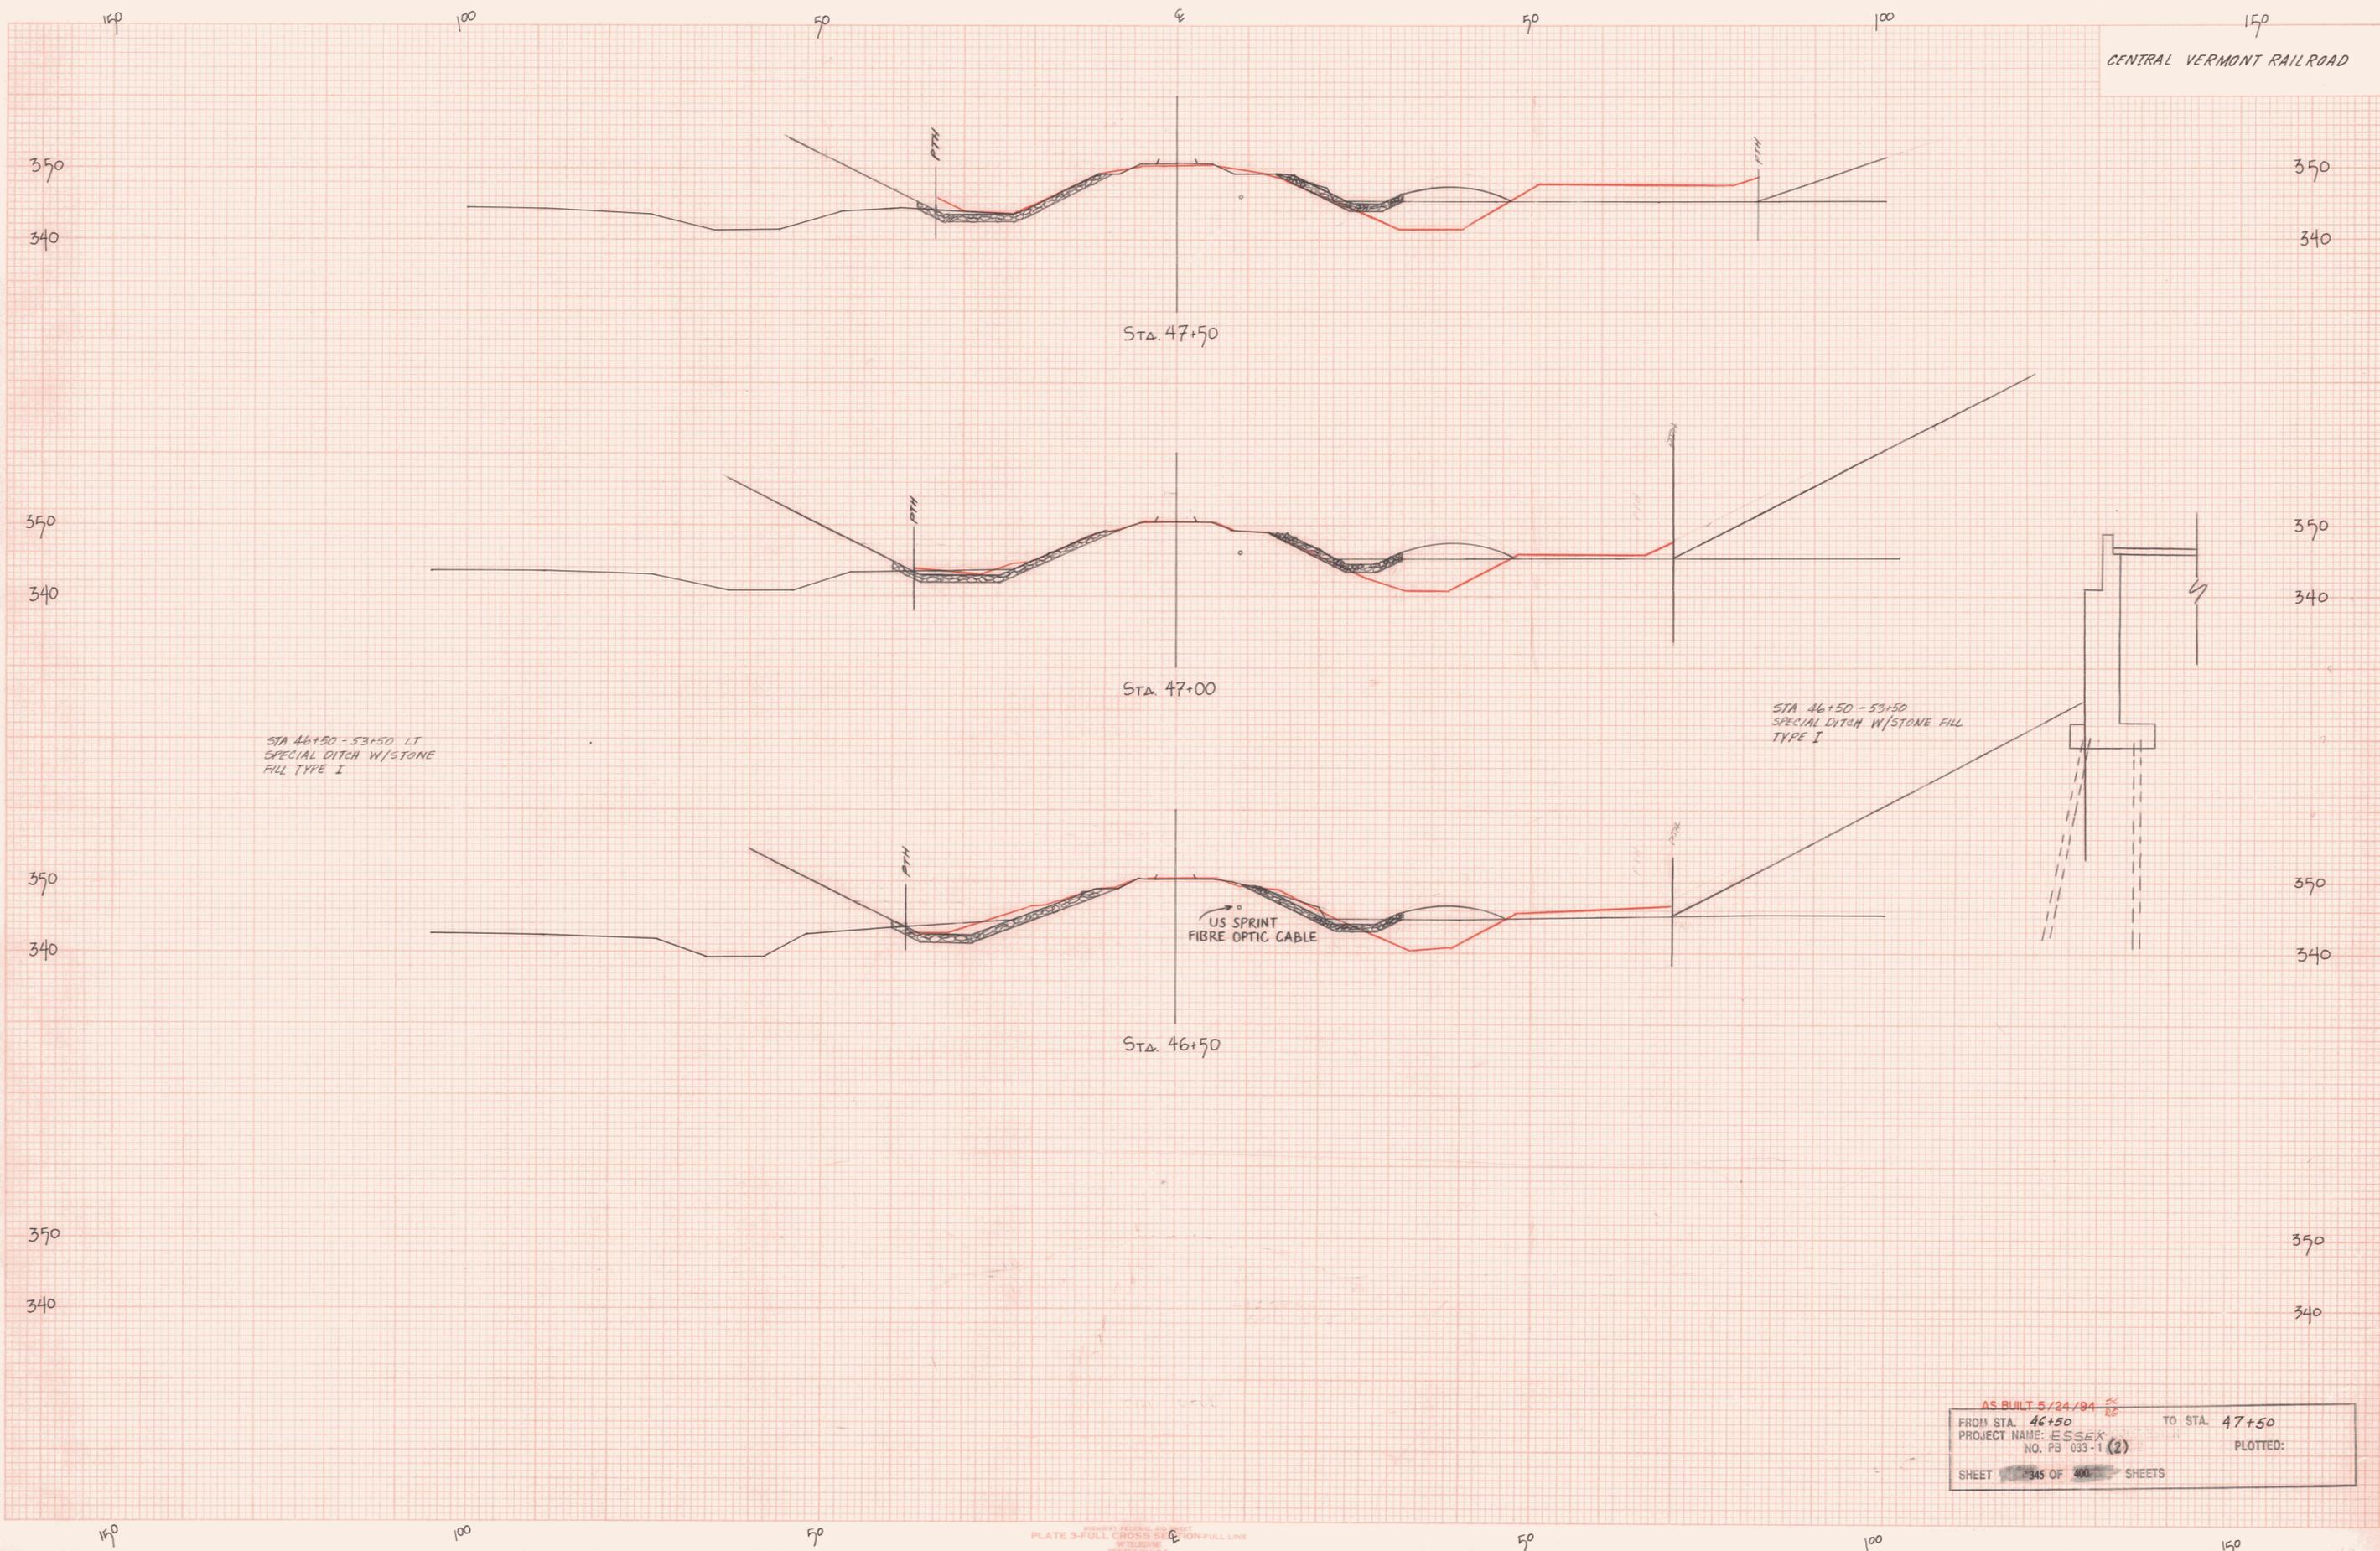

AS BUILT 5/24/94 ^{SC}/_{RS}

FROM STA. 46+50 TO STA. 47+50

PROJECT NAME: ESSEX

NO. PB 033-1 (2)

PLOTTED:

SHEET 345 OF 400 SHEETS