


DATE: _____ BY: _____
 ORIGINAL SURVEY: _____
 PLANNED: _____
 PLOTTED: _____
 NOTE BOOK: _____
 TEMPLATE: _____
 NO. _____
 AREA: _____
 CHECKED: _____

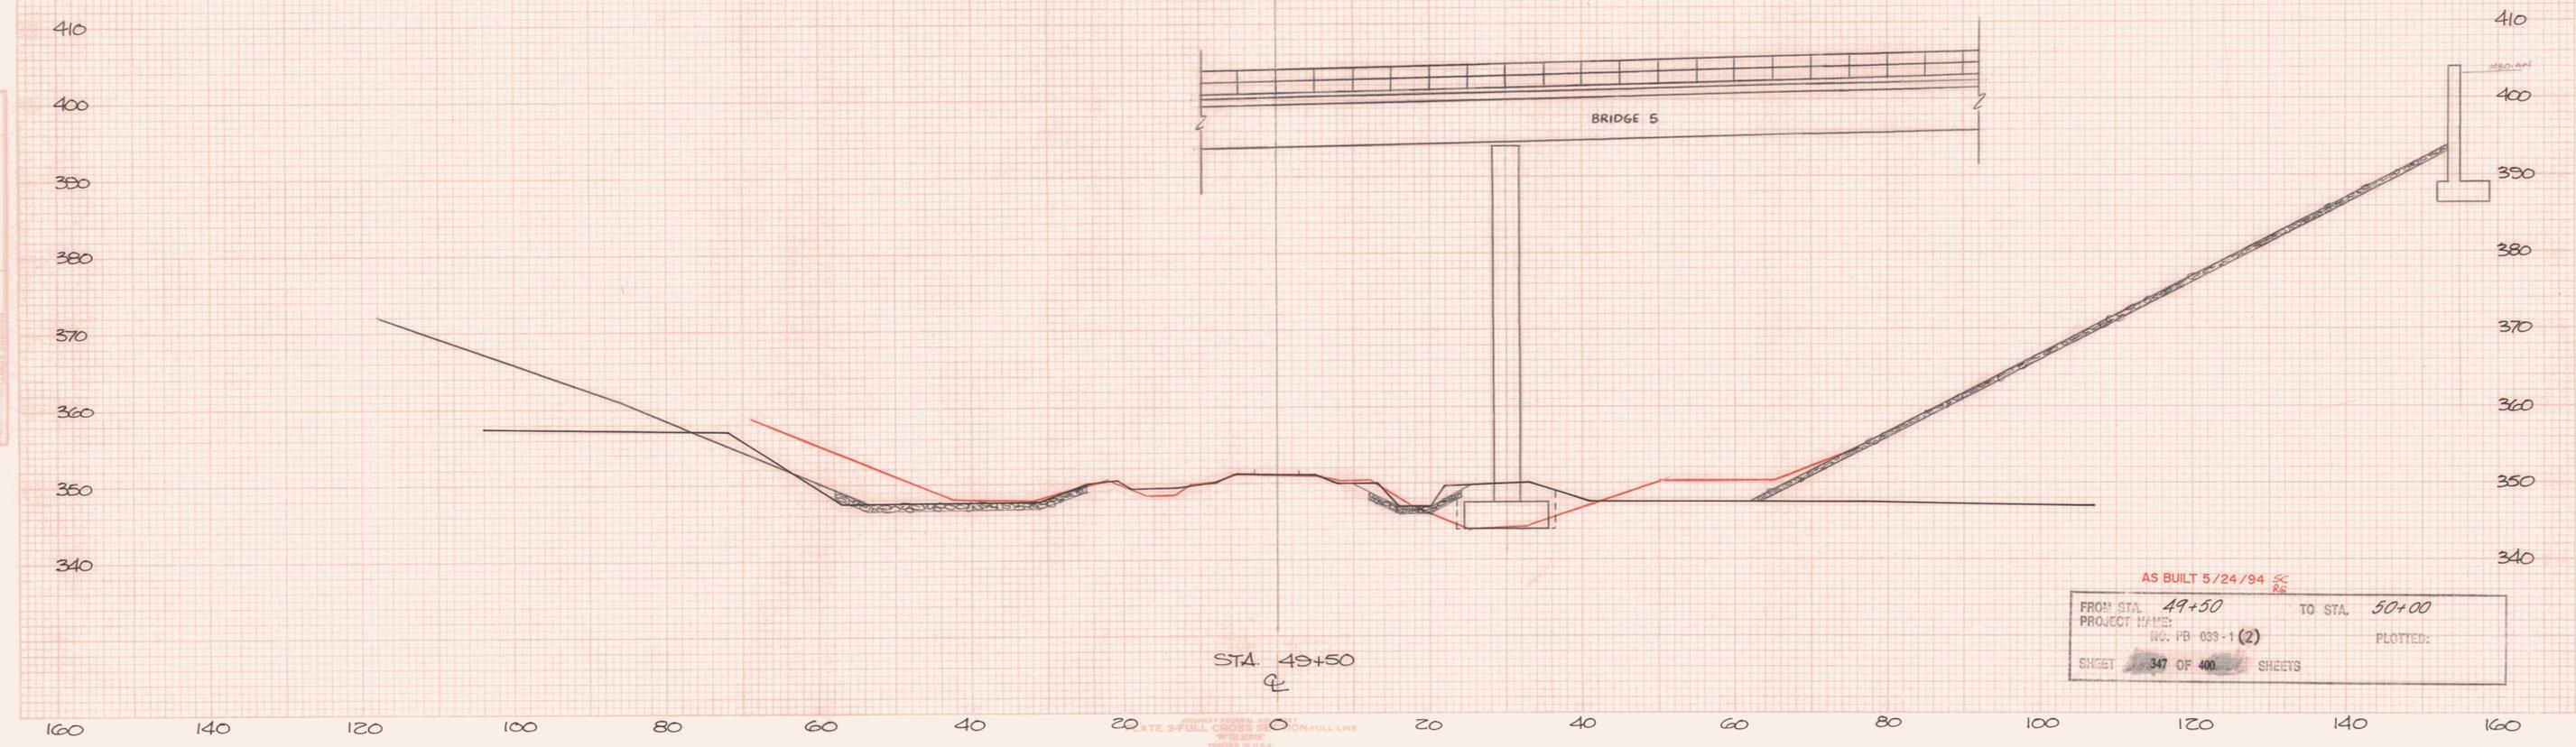

DATE: _____ BY: _____
 ORIGINAL SURVEY: _____
 PLANNED: _____
 PLOTTED: _____
 NOTE BOOK: _____
 TEMPLATE: _____
 NO. _____
 AREA: _____
 CHECKED: _____

AS BUILT 5/24/94 SC
 FROM STA. 49+50 TO STA. 50+00
 PROJECT NAME: _____
 NO. PB 033-1 (2) PLOTTED: _____
 SHEET 347 OF 400 SHEETS