

DATE: \_\_\_\_\_ BY: \_\_\_\_\_  
 ORIGINAL SURVEY: \_\_\_\_\_  
 PLATTED: \_\_\_\_\_  
 NOTE BOOK: \_\_\_\_\_  
 AREA: \_\_\_\_\_

DATE: \_\_\_\_\_ BY: \_\_\_\_\_  
 ORIGINAL SURVEY: \_\_\_\_\_  
 PLATTED: \_\_\_\_\_  
 NOTE BOOK: \_\_\_\_\_  
 AREA: \_\_\_\_\_

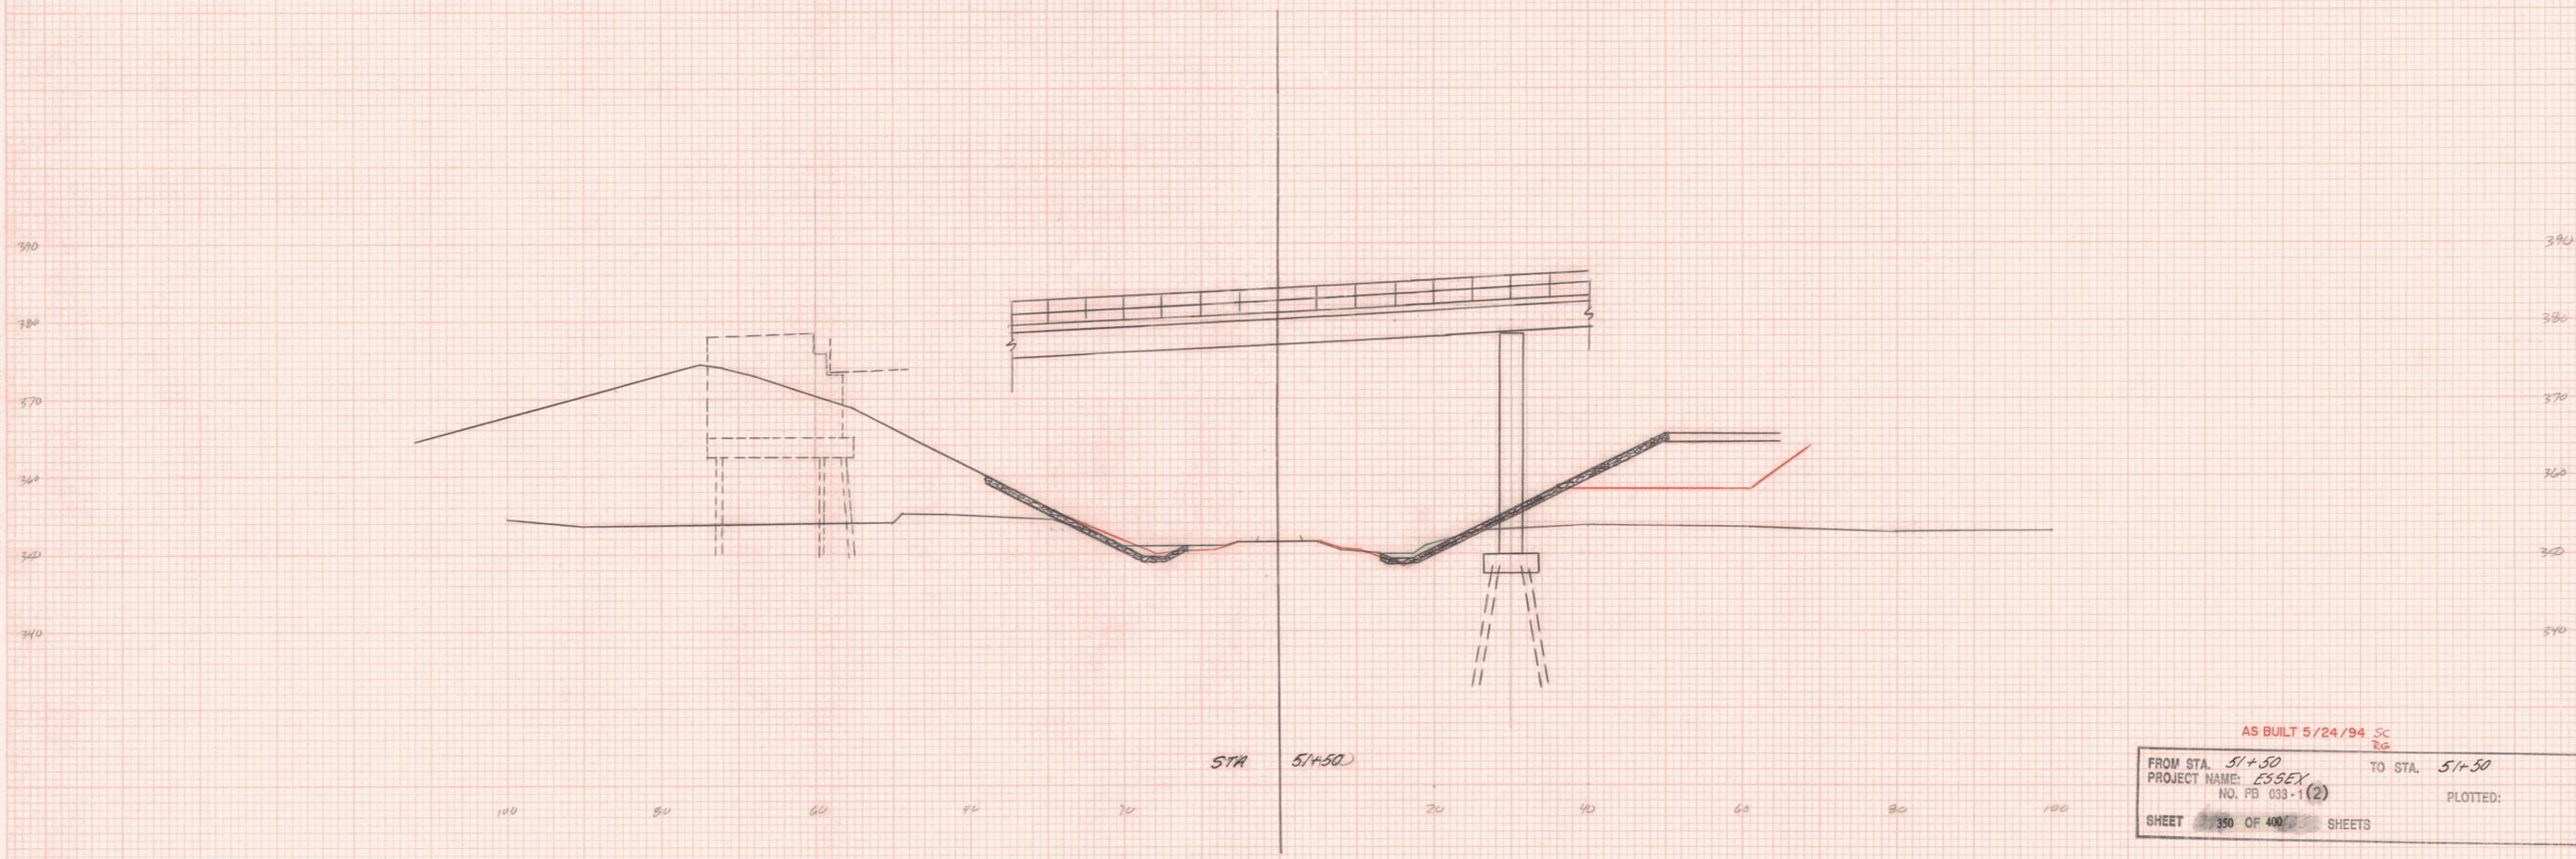


PLATE 3-FULL CROSS SECTION-FULL LINE  
 PRINTED IN U.S.A.

AS BUILT 5/24/94 SC  
 RG  
 FROM STA. 51+50 TO STA. 51+50  
 PROJECT NAME: ESSEX  
 NO. FB 033-1(2)  
 SHEET 350 OF 400 SHEETS  
 PLOTTED: