


¢

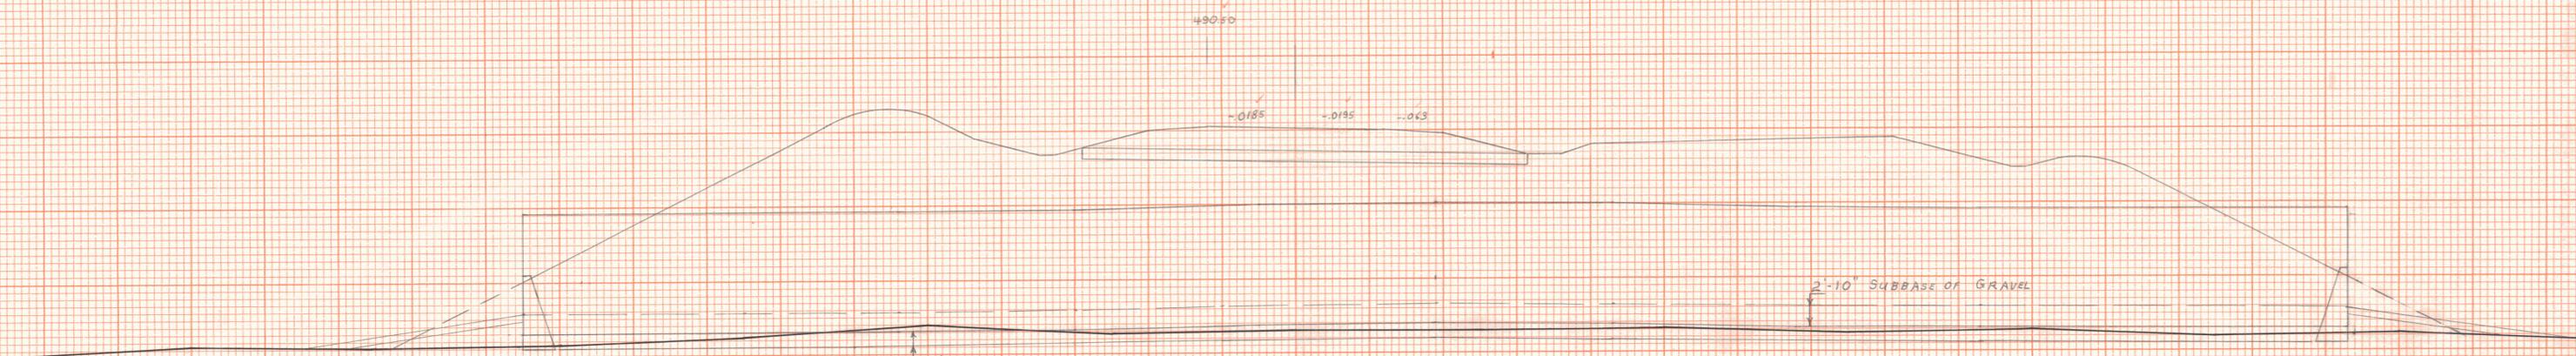

12" PIPE CAMBER	CORR.	FLOW TIME
48+95	0	463.00
49+0	0	.00
+25	0.06	.06
+50	0.20	.20
+75	0.42	.42
50+0	0.72	.72
+19	1.00	464.00
+25	0.91	463.91
+50	0.56	.56
+75	0.30	.30
51+0	0.12	.12
+25	0.02	.02
+43	0	469.00

490.50  
 -0.185 -0.185 -0.063

502+25

450

186" x 248" CGMPP  
 (0.138") (6"x2" CORR.)

2' GRANULAR BACKFILL FOR STRUCTURES

2'-10" SUBBASE OF GRAVEL

AS BUILT 5/24/94 RG  
 REVISED 6-25-91 RJR

WILLISTON-COLCHESTER  
 PB 033-1(2)  
 CHANNEL LINE @  
 W.B. 502+50

DZG  
 L.R.S.C. 5-91  
 Revised 353  
 SHEET 308 OF 400

PRINTED IN U.S.A.

25' RT. CHAN. LINE

"PERFECT" CROSS SECTION  
 10 x 10 - ONE INCH  
 EUGENE DIETZGEN CO.

50+0  
 W.B.  
 ¢

PRINTED IN U.S.A.

"PERFECT" CROSS SECTION  
 10 x 10 - ONE INCH  
 EUGENE DIETZGEN CO.