


¢

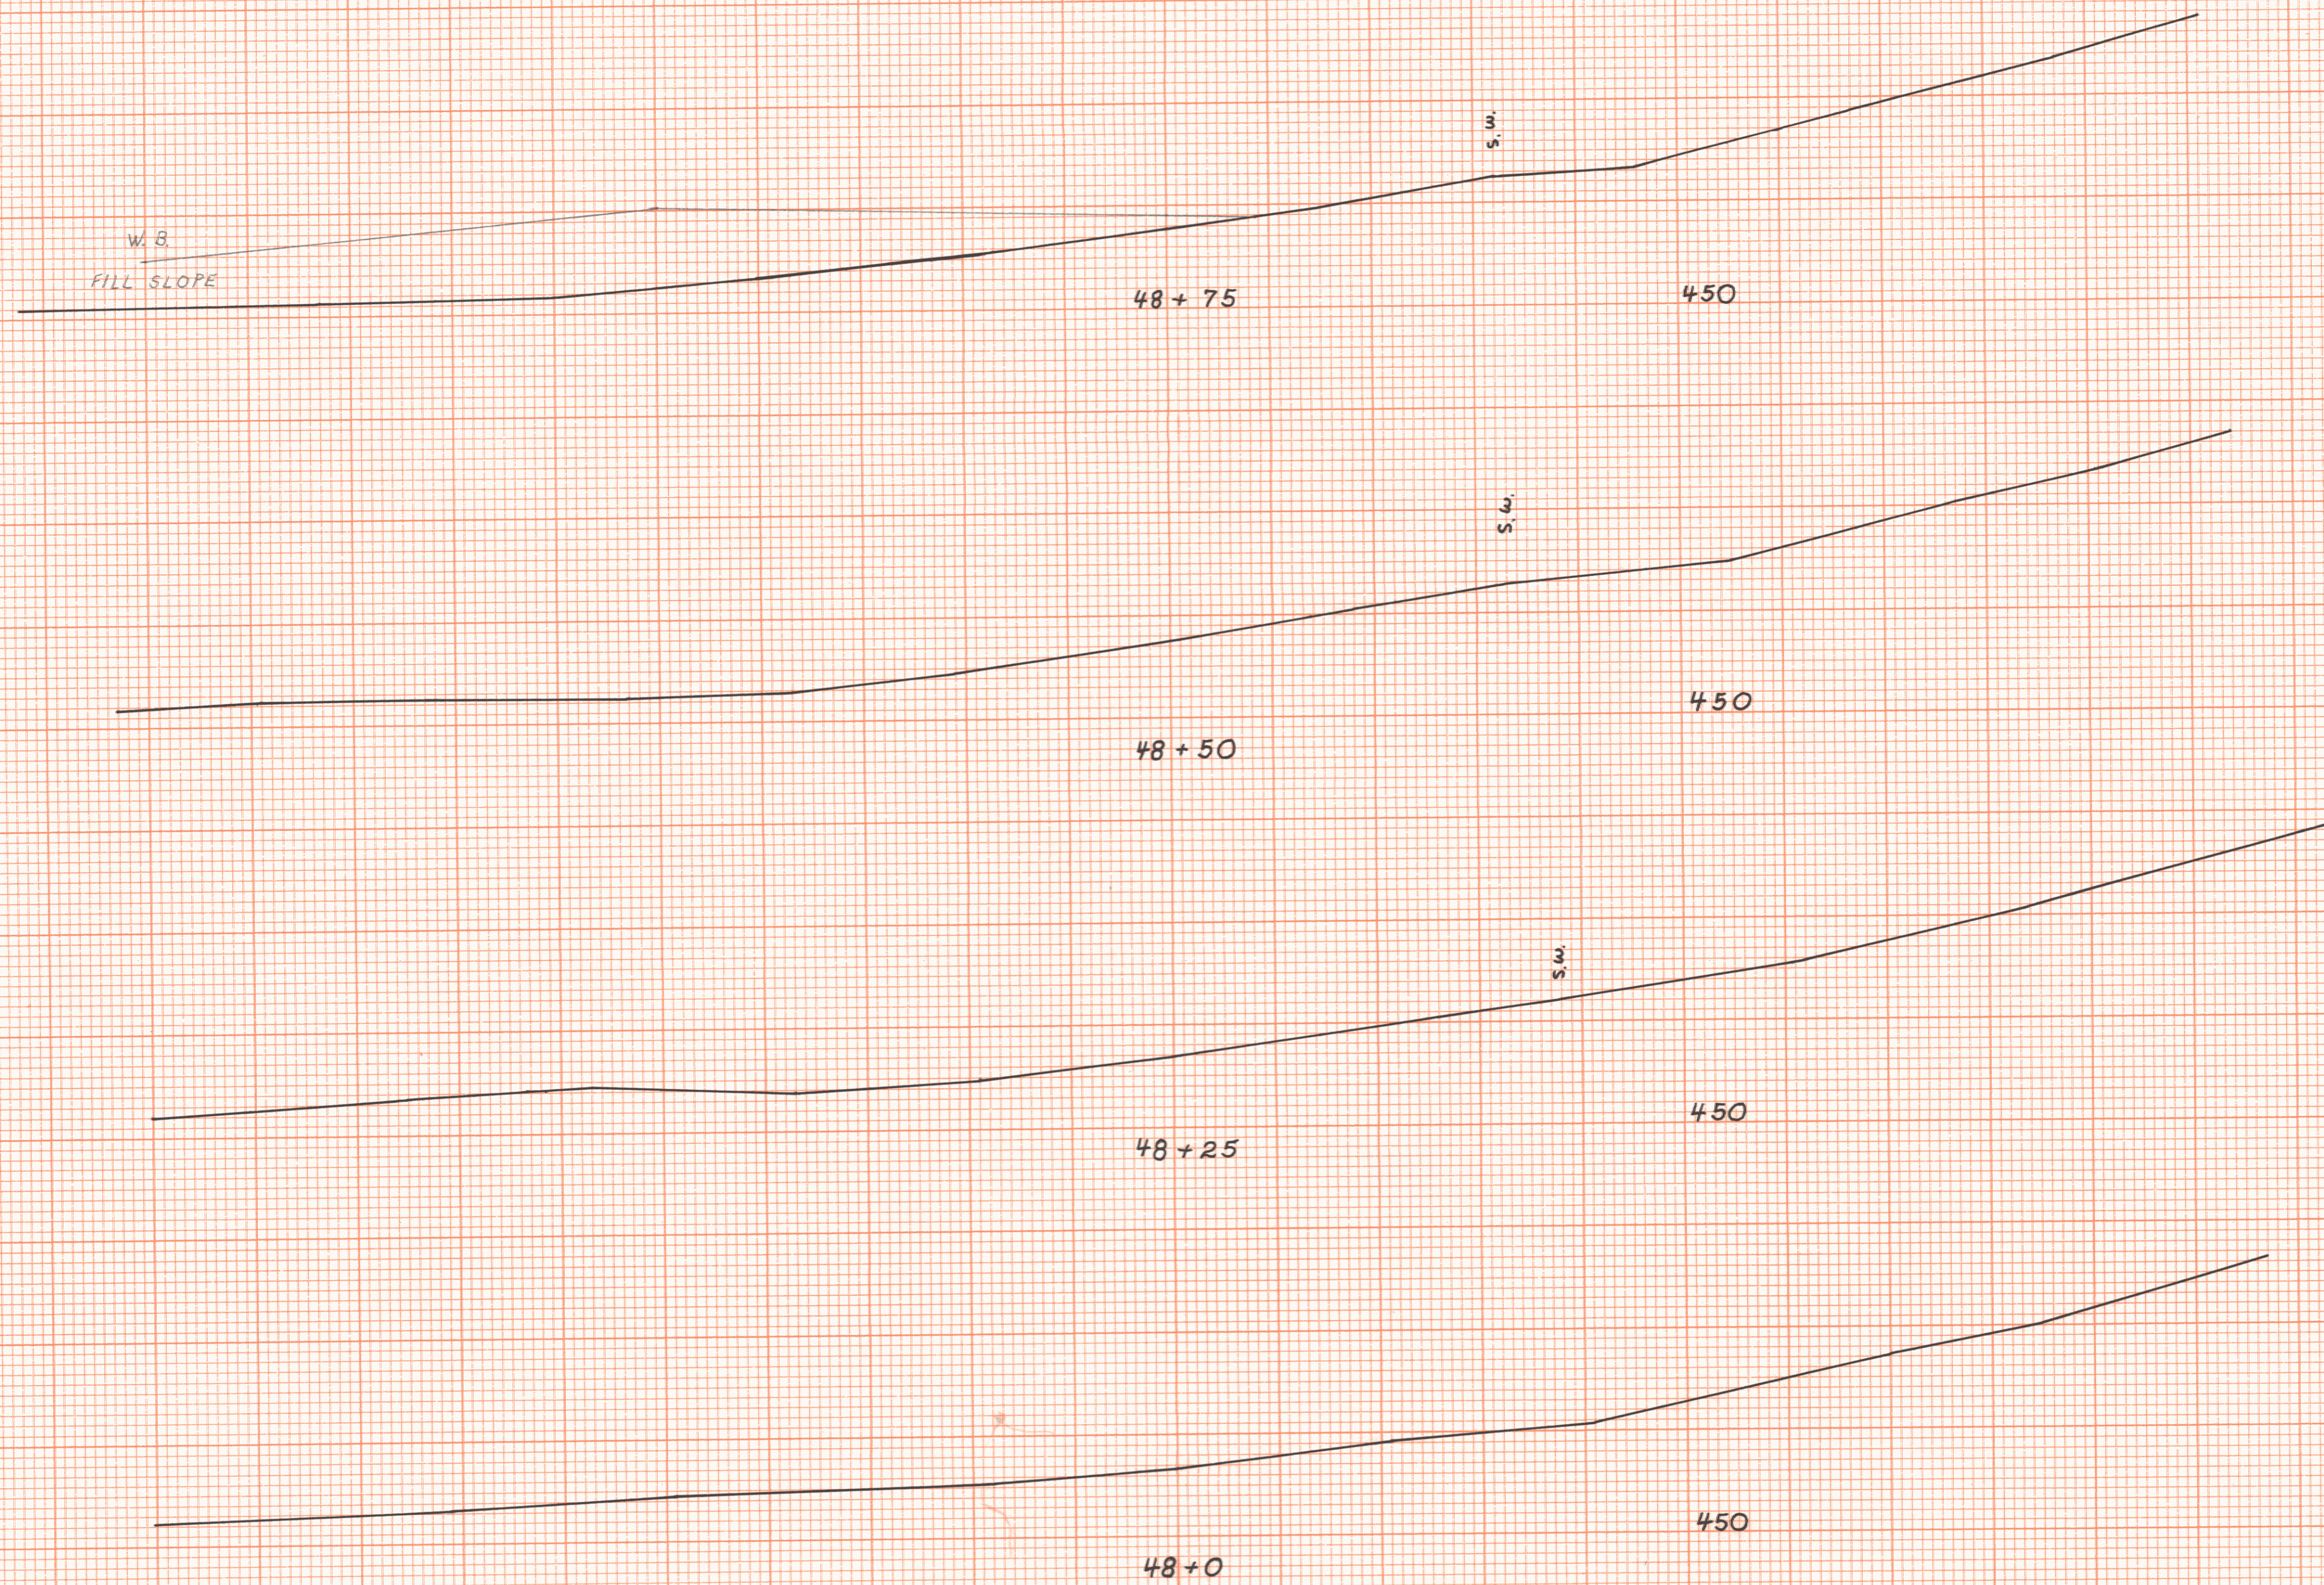

AS BUILT 5/24/99 SC
REVISED 6-25-91 RTR

WILLISTON - COLCHESTER
PB 033-1 (2)
CHANNEL LINE @
W.B. 502+50

DZG
L.R.S.C. 5-91

Revised
SHEET 354 OF 400

¢