


STRUCTURE NO. 8
 VT. RTE. 289 OVER INDIAN BROOK
 CHANNEL CROSS-SECTIONS
 6+65 - 7+65 1" = 5' H:V

DATE: _____
 BY: _____
 CHECKED: _____
 SURVEY NO.: _____
 NOTE BOOK: _____
 NO. _____

DATE: _____
 BY: _____
 CHECKED: _____
 SURVEY NO.: _____
 NOTE BOOK: _____
 NO. _____

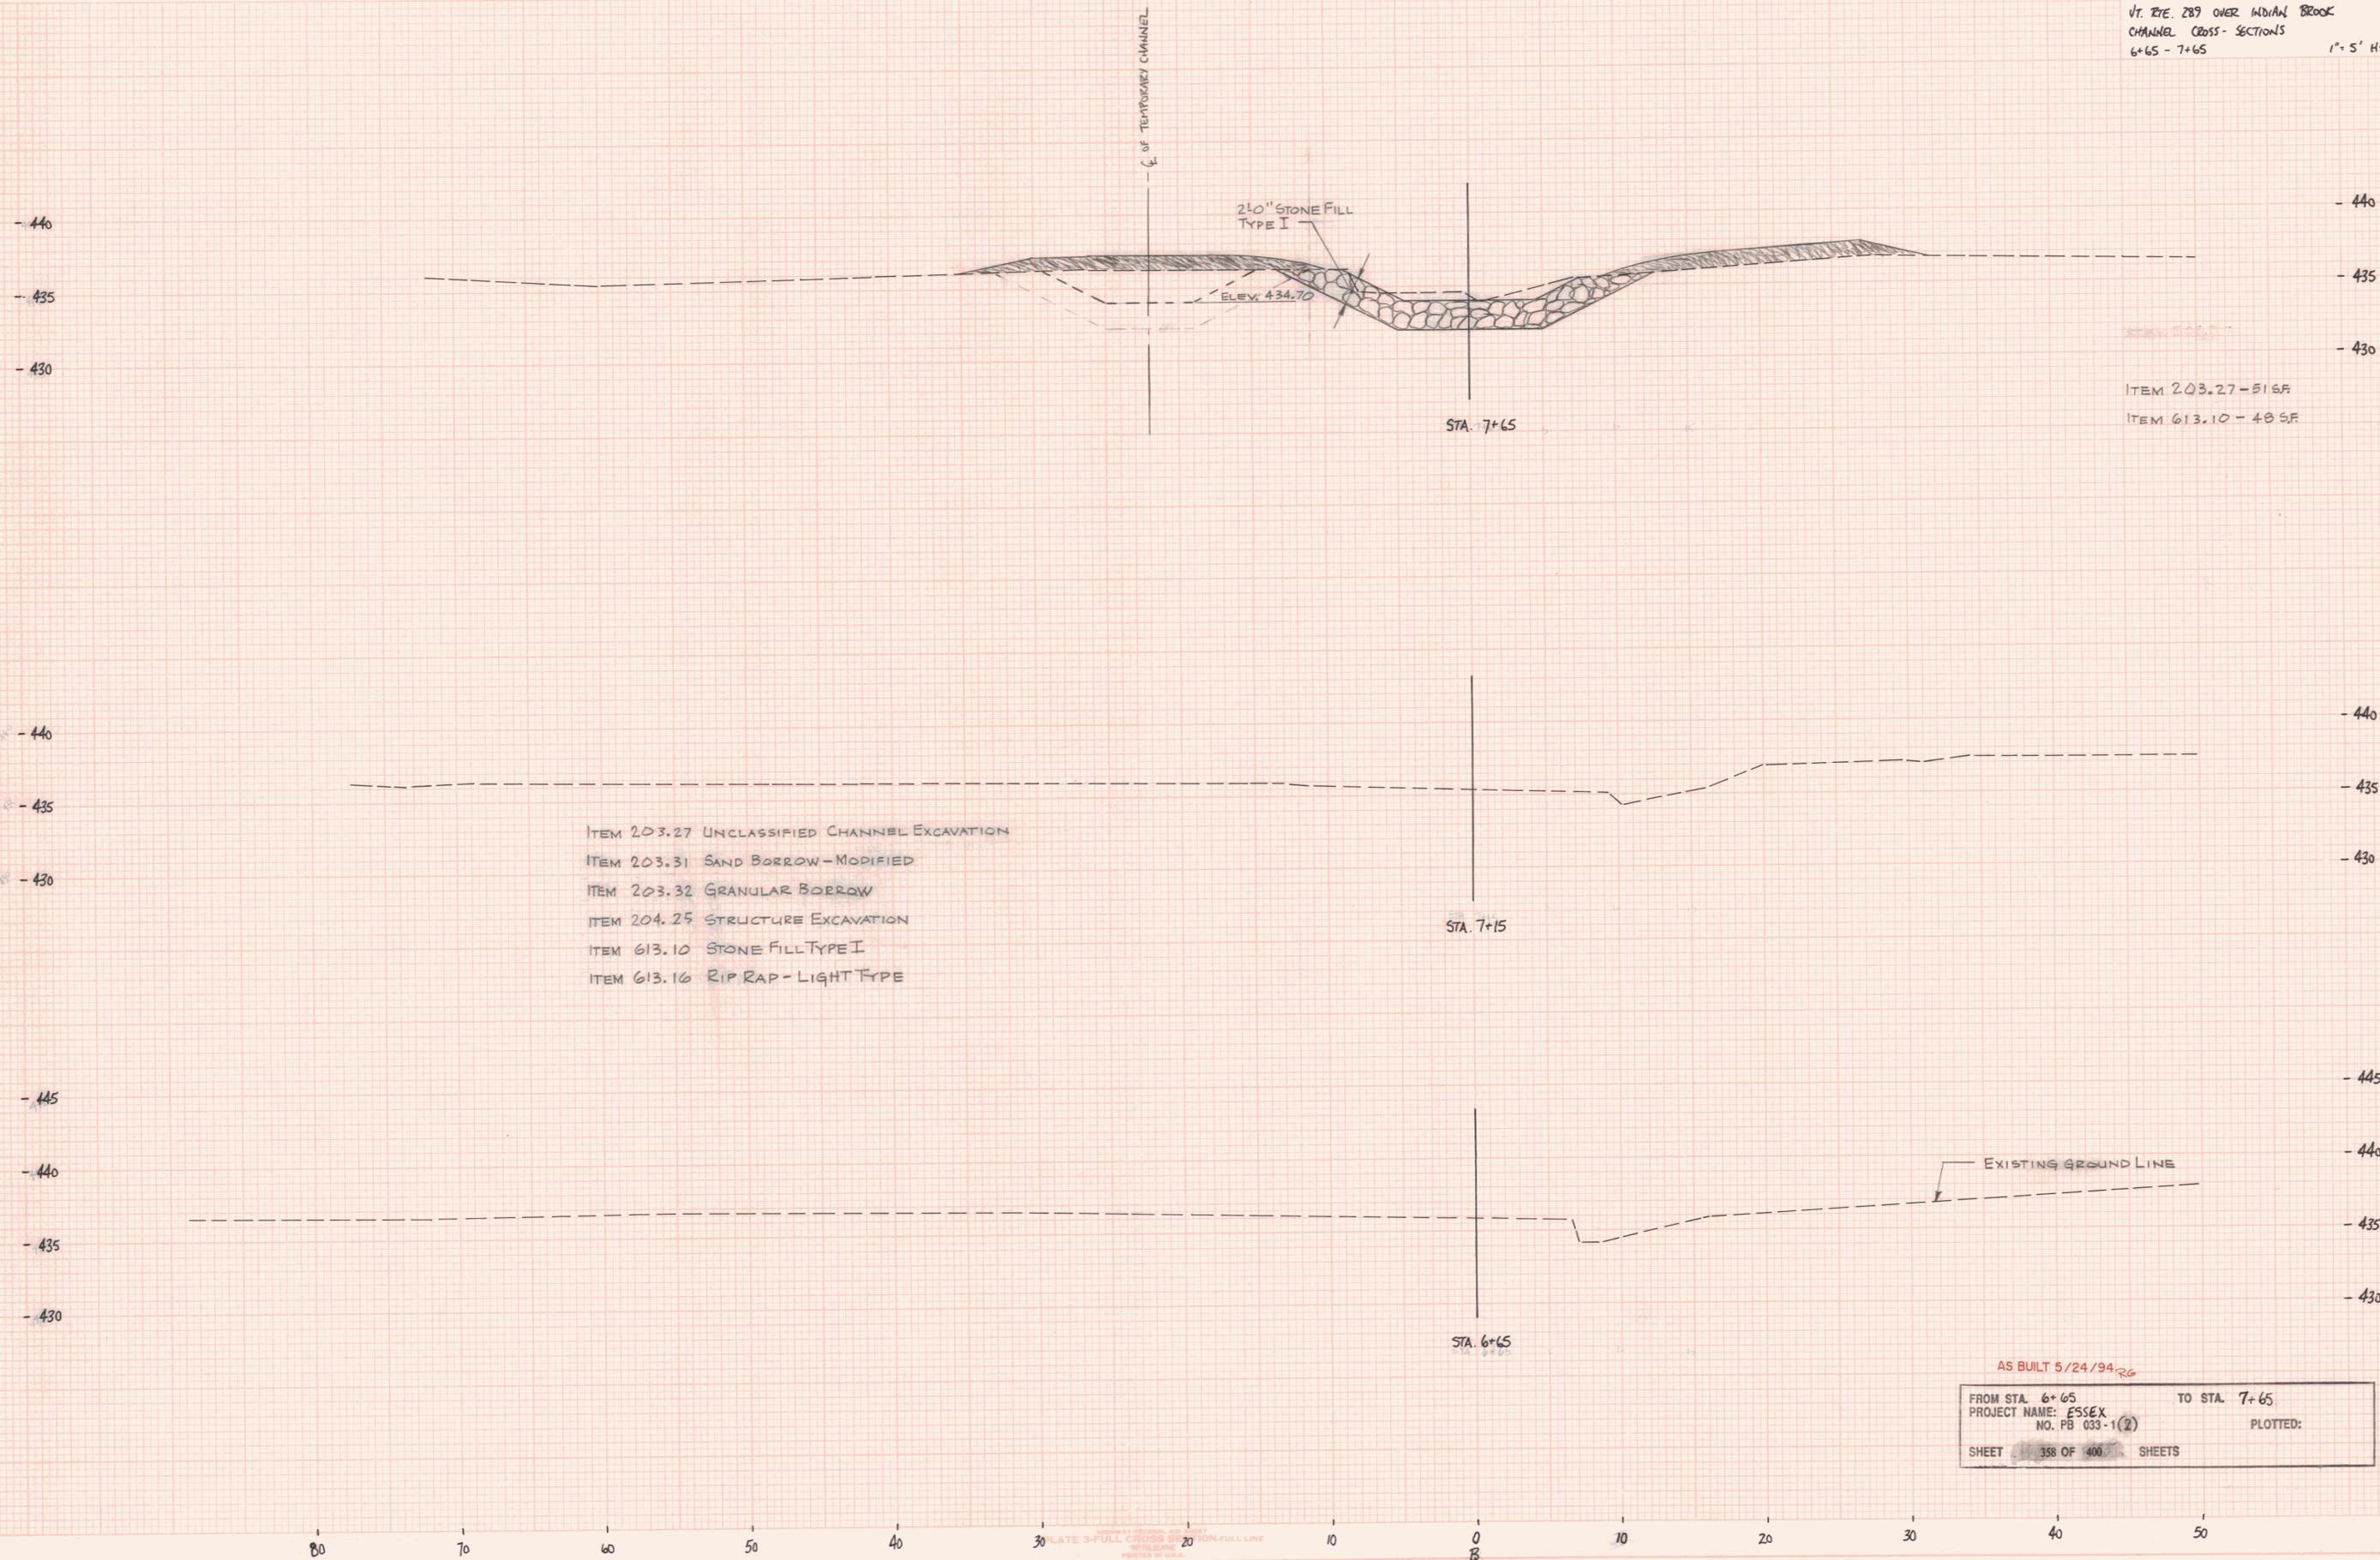

- ITEM 203.27 UNCLASSIFIED CHANNEL EXCAVATION
- ITEM 203.31 SAND BORROW - MODIFIED
- ITEM 203.32 GRANULAR BORROW
- ITEM 204.25 STRUCTURE EXCAVATION
- ITEM 613.10 STONE FILL TYPE I
- ITEM 613.16 RIP RAP - LIGHT TYPE

ITEM 203.27 - 51 SF
 ITEM 613.10 - 40 SF

AS BUILT 5/24/94 ²⁶

FROM STA. 6+65	TO STA. 7+65
PROJECT NAME: ESSEX	
NO. PB 033-1(2)	PLOTTED:
SHEET 338 OF 400 SHEETS	