




STRUCTURE No. 8
 VT. RTE. 289 OVER INDIAN BROOK
 CHANNEL CROSS-SECTIONS
 8+15 - 9+00 (1"=5' H:V)

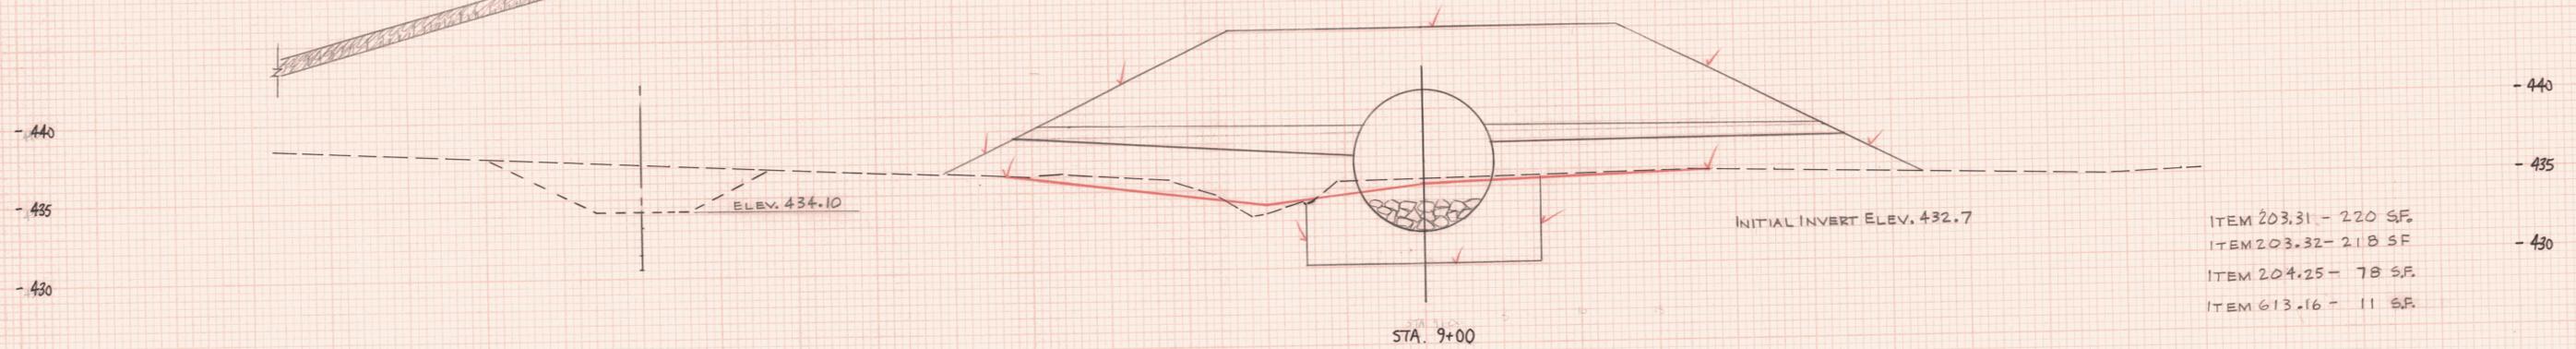

ITEM 203.31 - 220 SF
 ITEM 203.32 - 218 SF
 ITEM 204.25 - 78 SF
 ITEM 613.16 - 11 SF

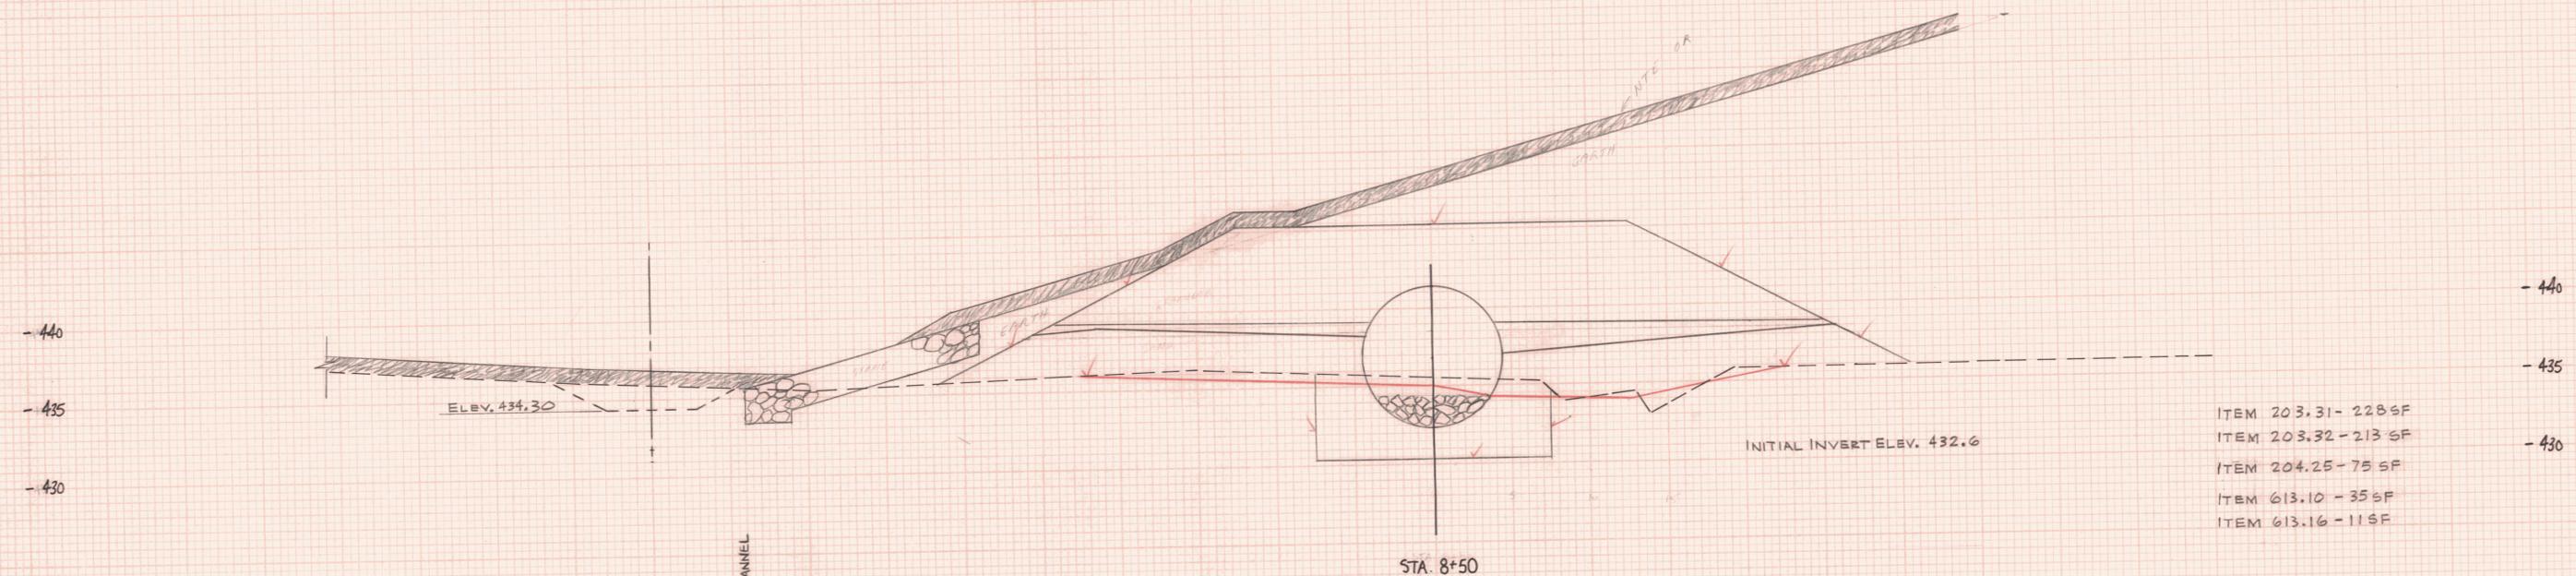

ITEM 203.31 - 228 SF
 ITEM 203.32 - 213 SF
 ITEM 204.25 - 75 SF
 ITEM 613.10 - 35 SF
 ITEM 613.16 - 11 SF

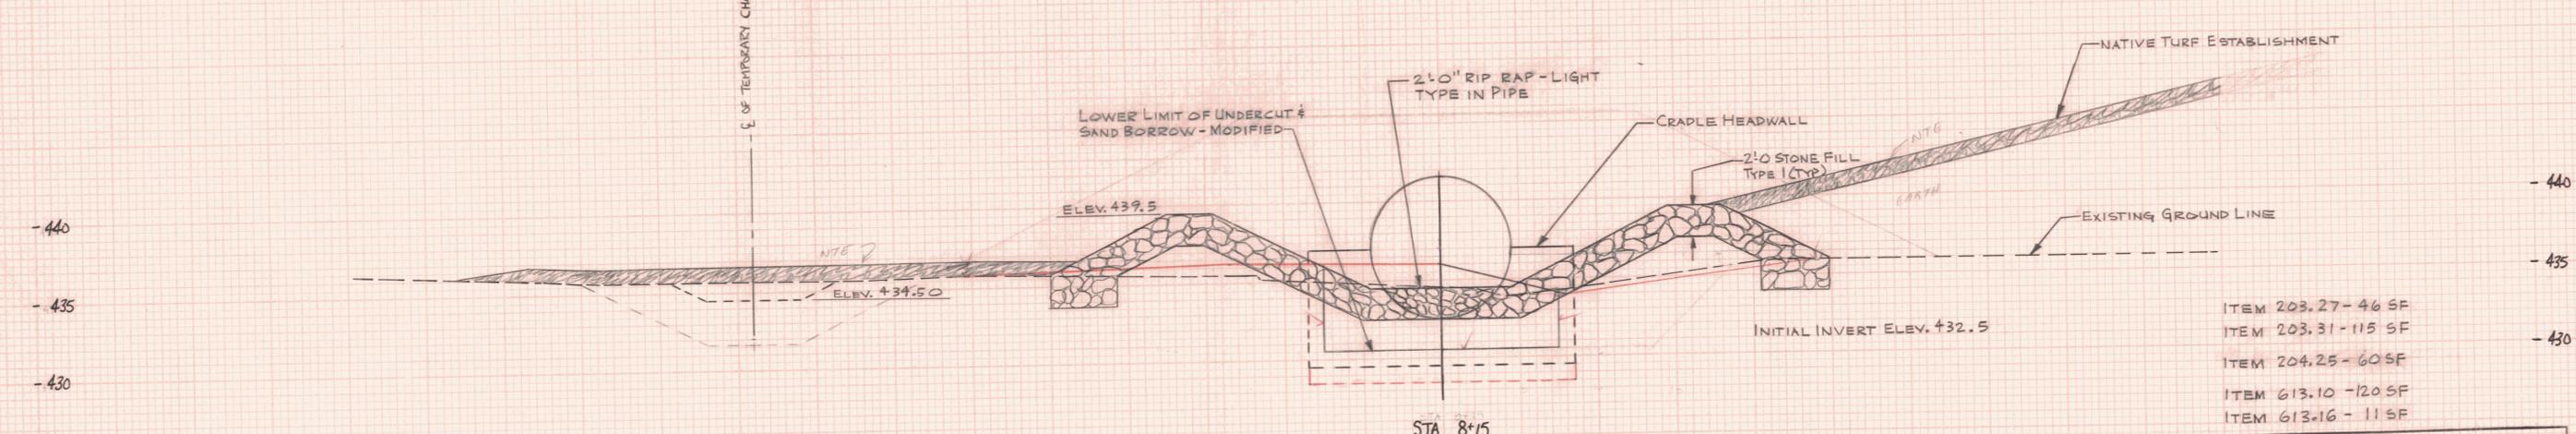

ITEM 203.27 - 46 SF
 ITEM 203.31 - 115 SF
 ITEM 204.25 - 60 SF
 ITEM 613.10 - 120 SF
 ITEM 613.16 - 11 SF

FROM STA. 8+15 TO STA. 9+00
 PROJECT NAME: ESSEX
 NO. PB 033-1(2) PLOTTED:
 SHEET 359 OF 400 SHEETS
 AS BUILT 5/24/94

BEGIN CULVERT STA. 8+14.50