



STRUCTURE No. 8  
 VT. RTE. 289 OVER INDIAN BROOK  
 CHANNEL CROSS-SECTION  
 9+50 - 10+50 1"=5' H:V

FINAL SURVEY  
 DATE: \_\_\_\_\_  
 BY: \_\_\_\_\_  
 CHECKED: \_\_\_\_\_  
 NO. \_\_\_\_\_

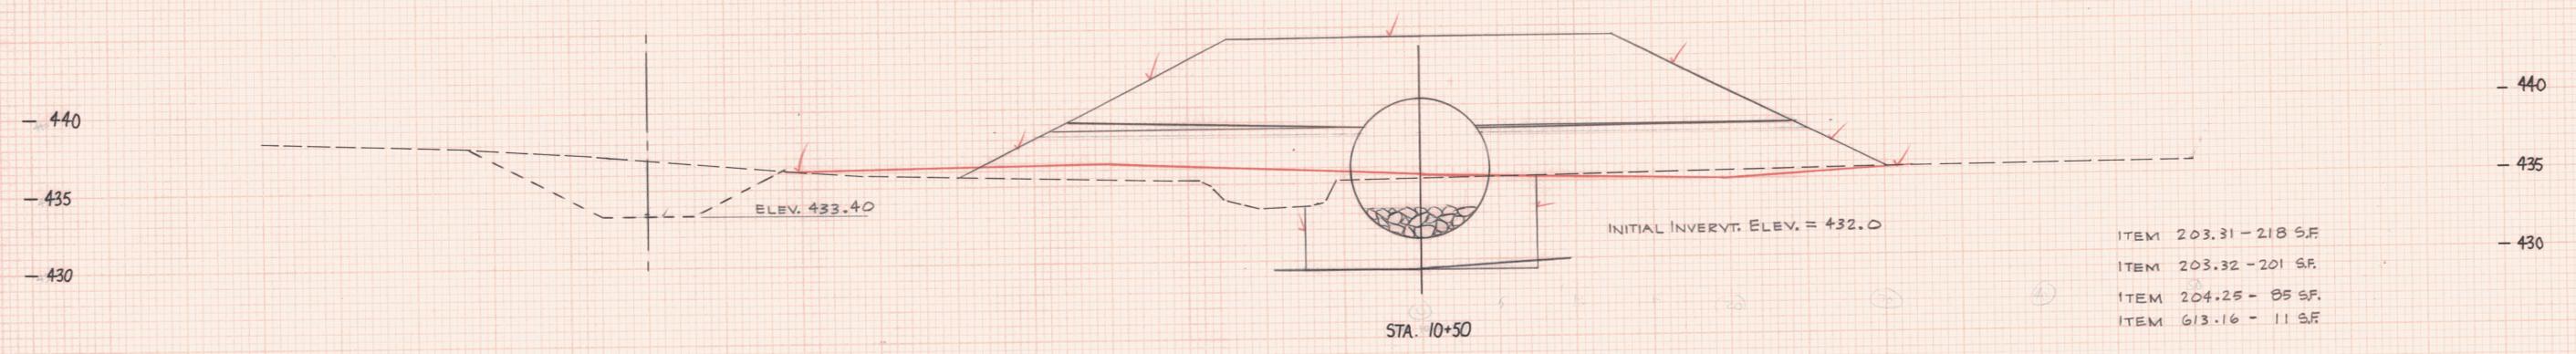


- ITEM 203.31 - 218 S.F.
- ITEM 203.32 - 201 S.F.
- ITEM 204.25 - 85 S.F.
- ITEM 613.16 - 11 S.F.

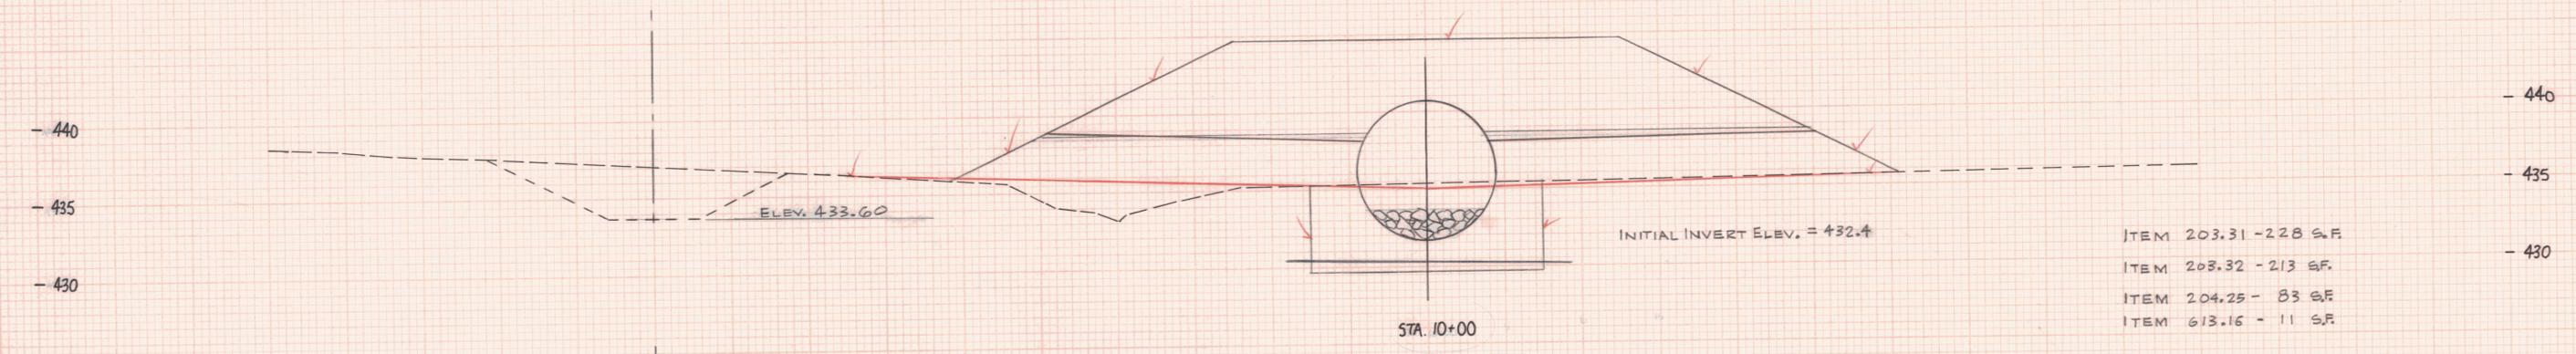

- ITEM 203.31 - 228 S.F.
- ITEM 203.32 - 213 S.F.
- ITEM 204.25 - 83 S.F.
- ITEM 613.16 - 11 S.F.

ORIGINAL SURVEY  
 DATE: \_\_\_\_\_  
 BY: \_\_\_\_\_  
 CHECKED: \_\_\_\_\_  
 NO. \_\_\_\_\_

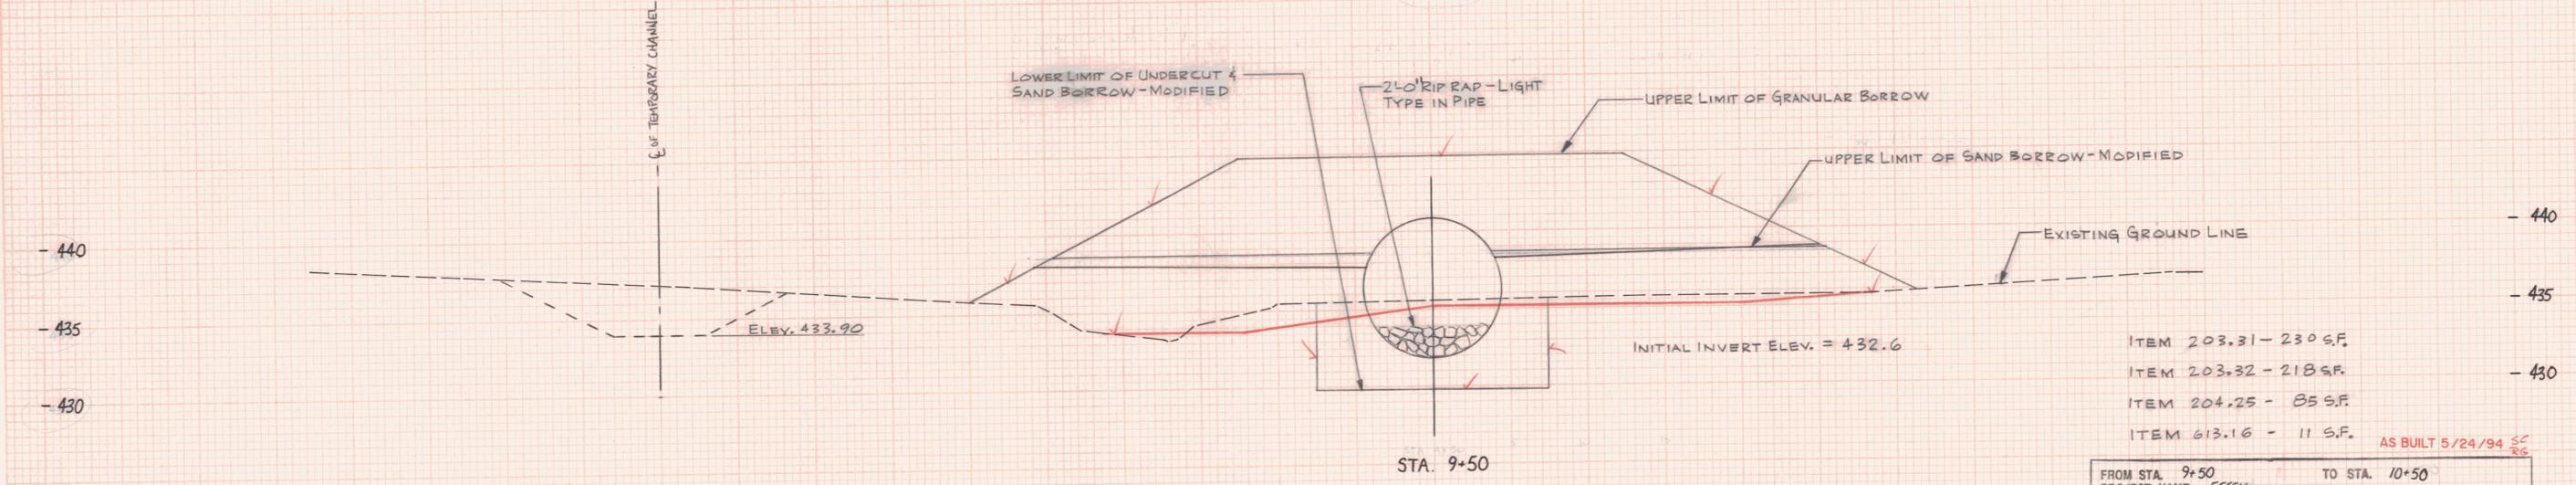

- ITEM 203.31 - 230 S.F.
- ITEM 203.32 - 218 S.F.
- ITEM 204.25 - 85 S.F.
- ITEM 613.16 - 11 S.F.

AS BUILT 5/24/94 SC  
 FROM STA. 9+50 TO STA. 10+50  
 PROJECT NAME: ESSEX  
 NO. PB 033-1 (2) PLOTTED:  
 SHEET 360 OF 400 SHEETS

GENERAL NOTES:  
 PLATE 3-FULL CROSS SECTION FULL LINE  
 HYDRAULIC ENGINEERING  
 PRINTED IN U.S.A.