
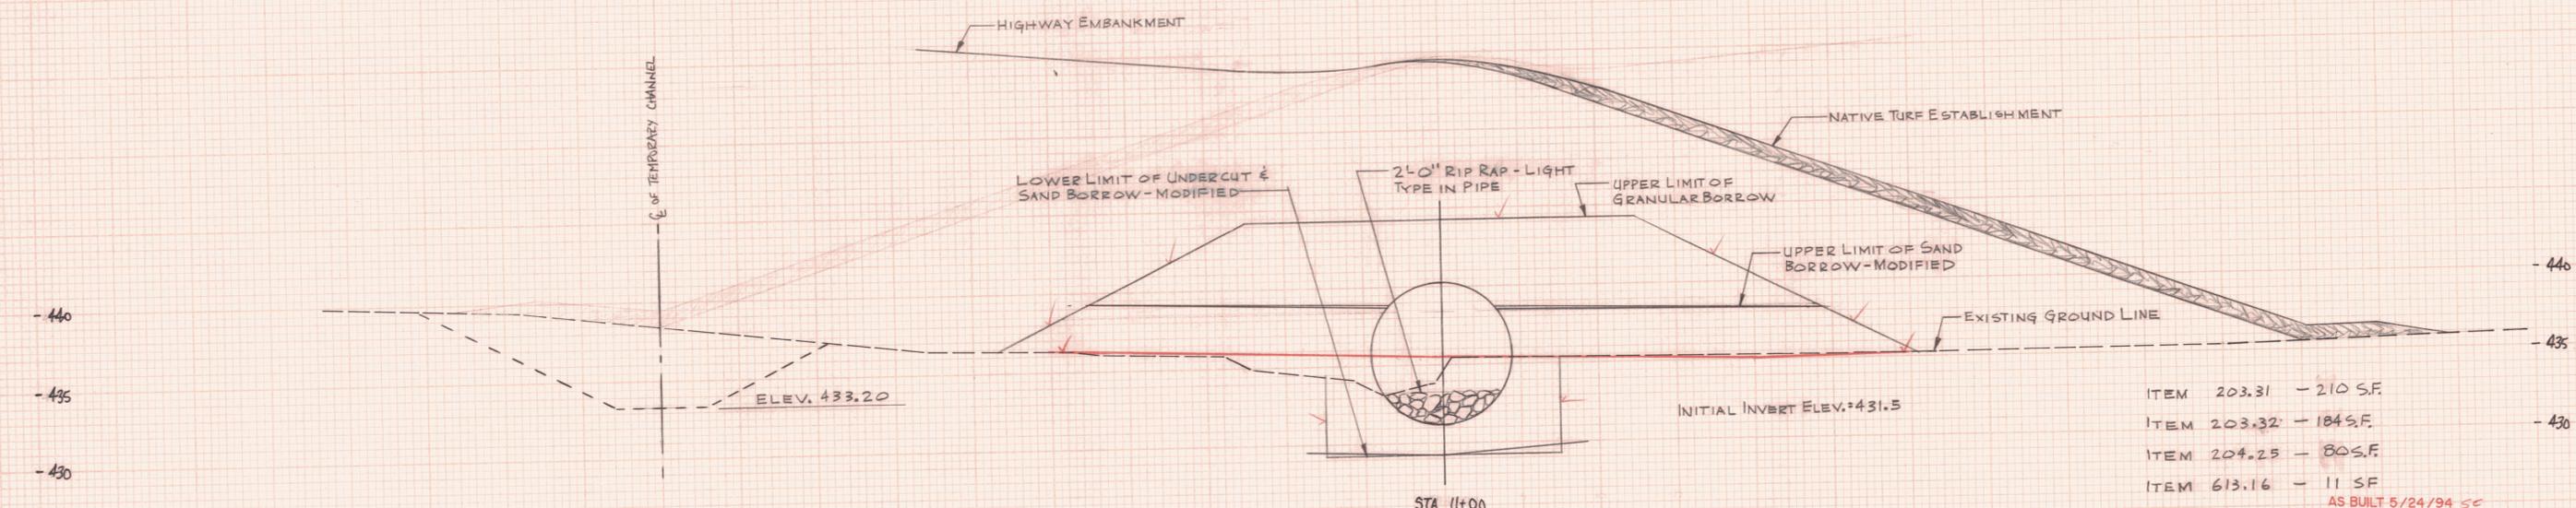
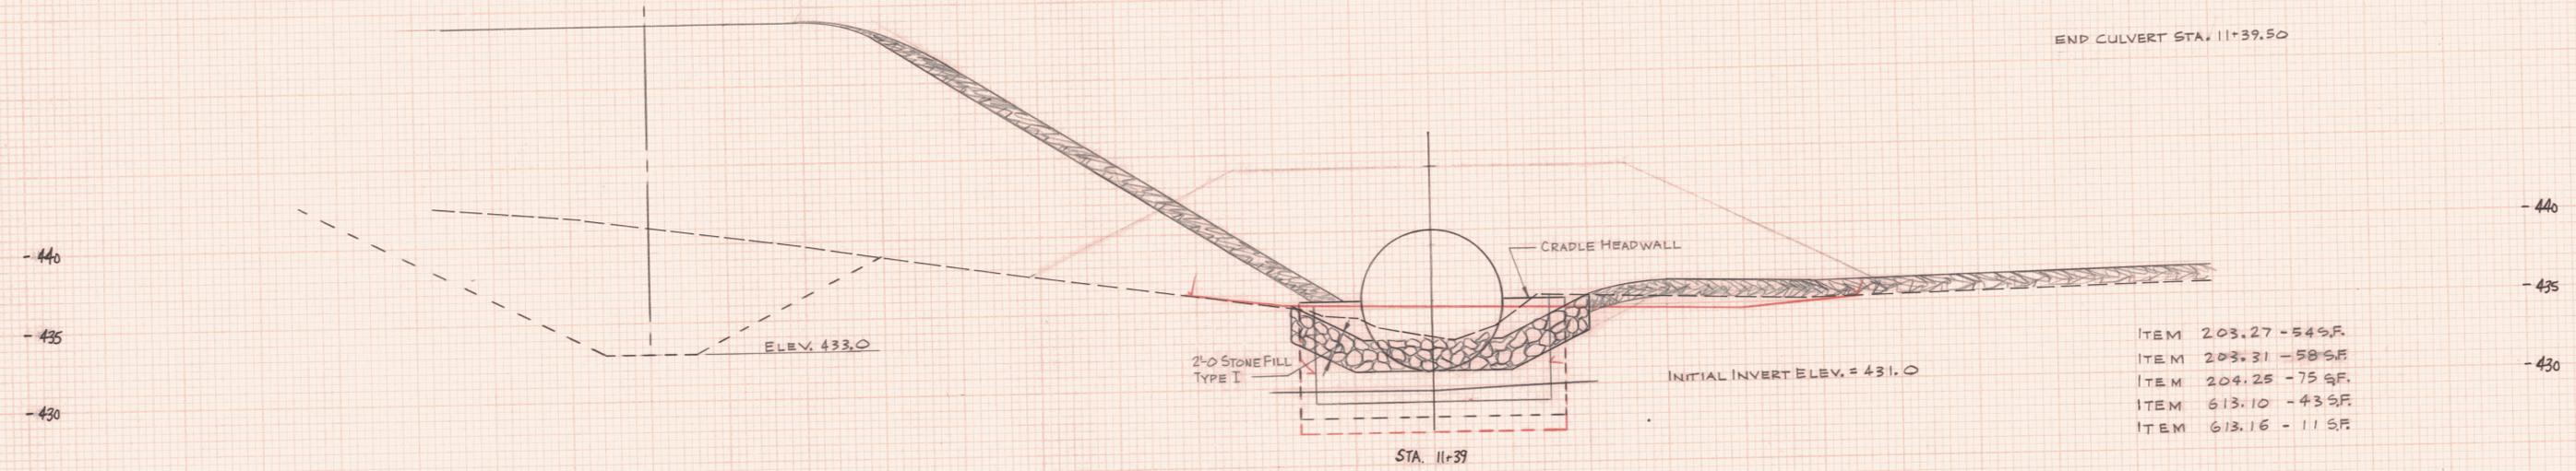


STRUCTURE No. 8
 VT. RTE. 289 OVER INDIAN BROOK
 CHANNEL CROSS-SECTIONS
 11+00 - 11+89 1" = 5' H:V

FINAL SURVEY
 DATE: _____
 BY: _____
 CHECKED: _____
 NO. _____

ORIGINAL SURVEY
 DATE: _____
 BY: _____
 CHECKED: _____
 NO. _____

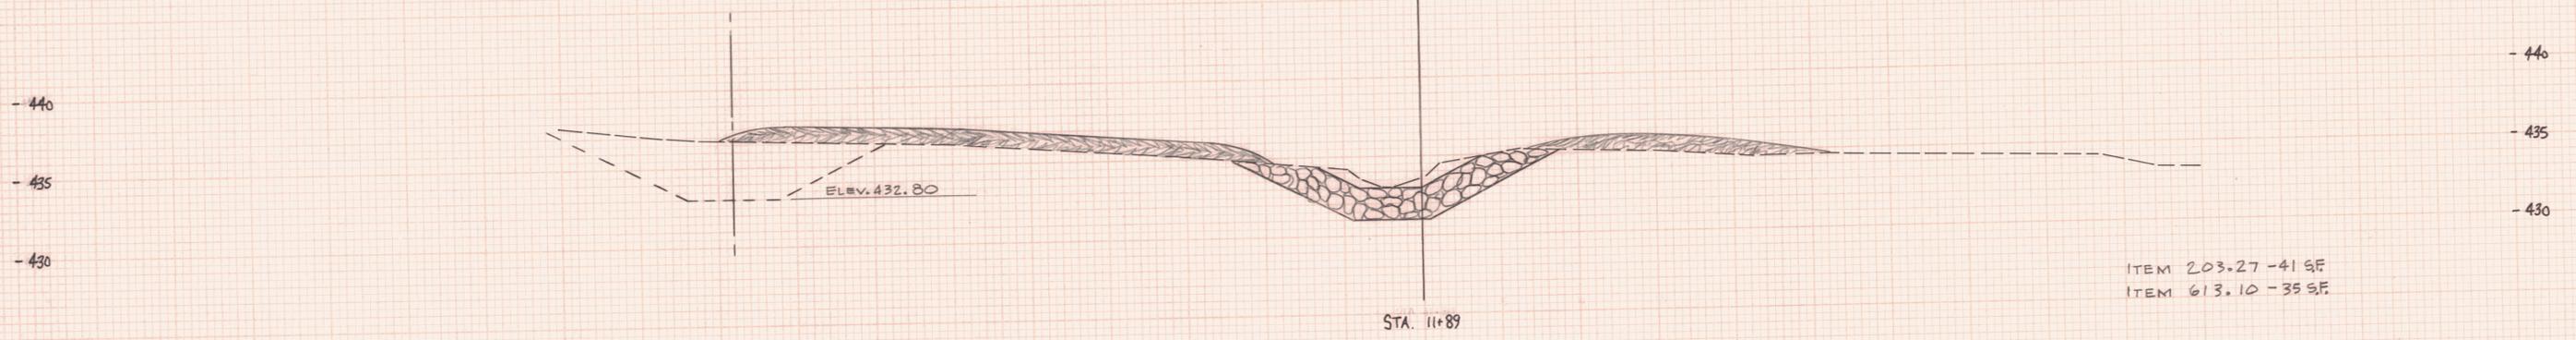

AS BUILT 5/24/94 SC SF
 FROM STA. 11+00 TO STA. 11+89
 PROJECT NAME: ESSEX NO. PB 033-1(2) PLOTTED:
 SHEET 361 OF 400 SHEETS