
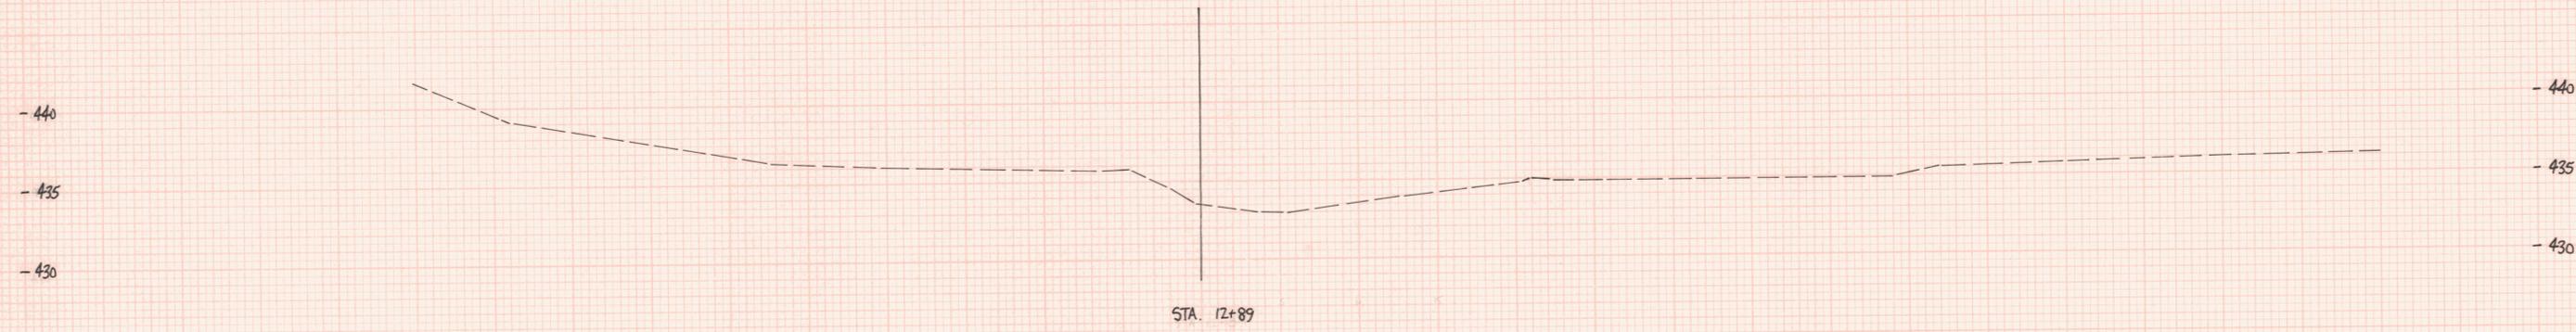


STRUCTURE No. 8  
 VT. RTE. 289 OVER HOWAN BROOK  
 CHANNEL CROSS-SECTIONS  
 12+39 - 13+39 1" = 5' H:V

FINAL SURVEY  
 BY: [blank]  
 DATE: [blank]  
 CHECKED BY: [blank]  
 DATE: [blank]

ORIGINAL SURVEY  
 BY: [blank]  
 DATE: [blank]  
 CHECKED BY: [blank]  
 DATE: [blank]

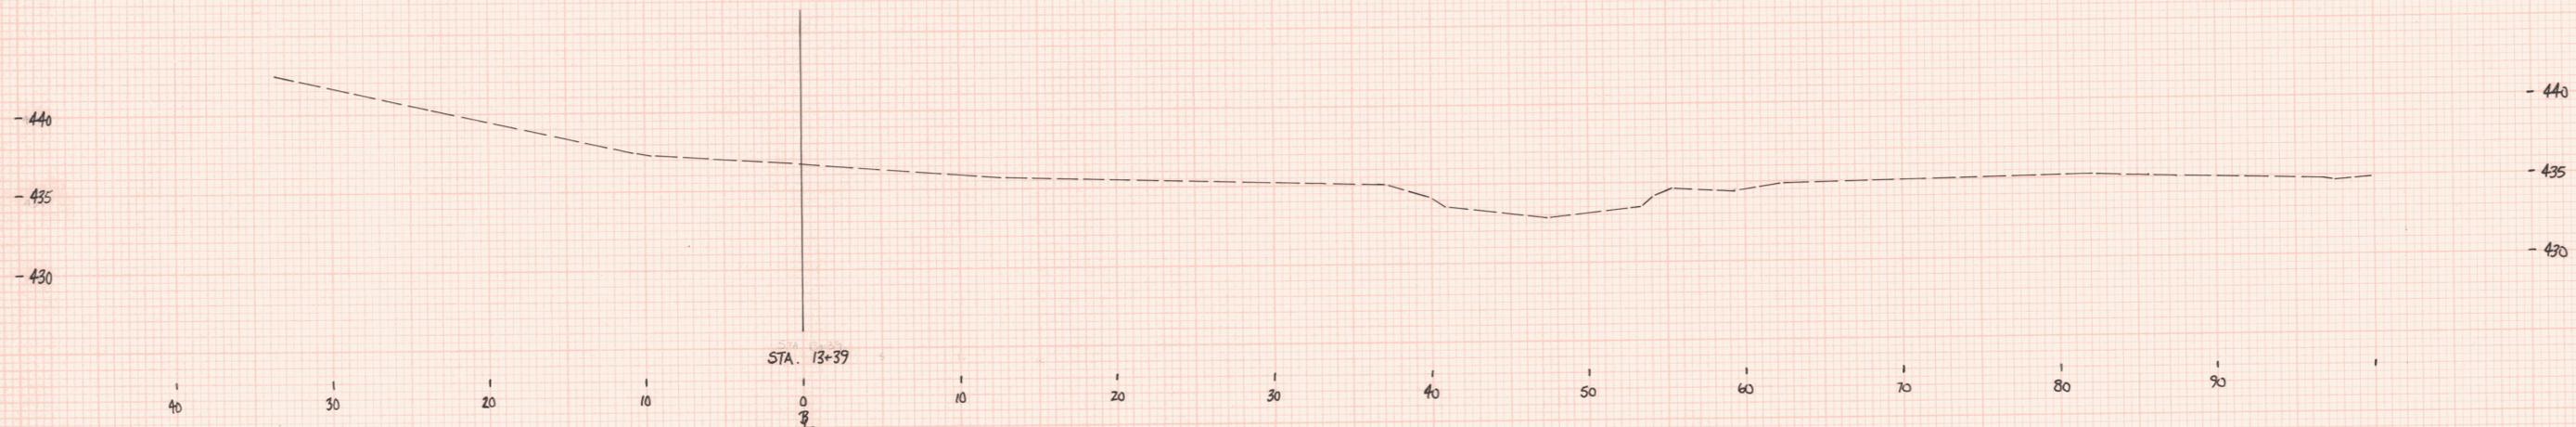

BUILT AS DESIGNED 5/24/94 <sup>RF</sup>

FROM STA. 12+39	TO STA. 13+39
PROJECT NAME: ESSEX	
NO. PB 039-1(2)	PLOTTED:
SHEET 362 OF 400 SHEETS	

PLATE 3-PUR CROSS SECTION-FULL L  
 MADE IN U.S.A.