


STRUCTURE NO. 10  
 OUTLET CROSS-SECTIONS  
 STA 9+20 TO 9+30

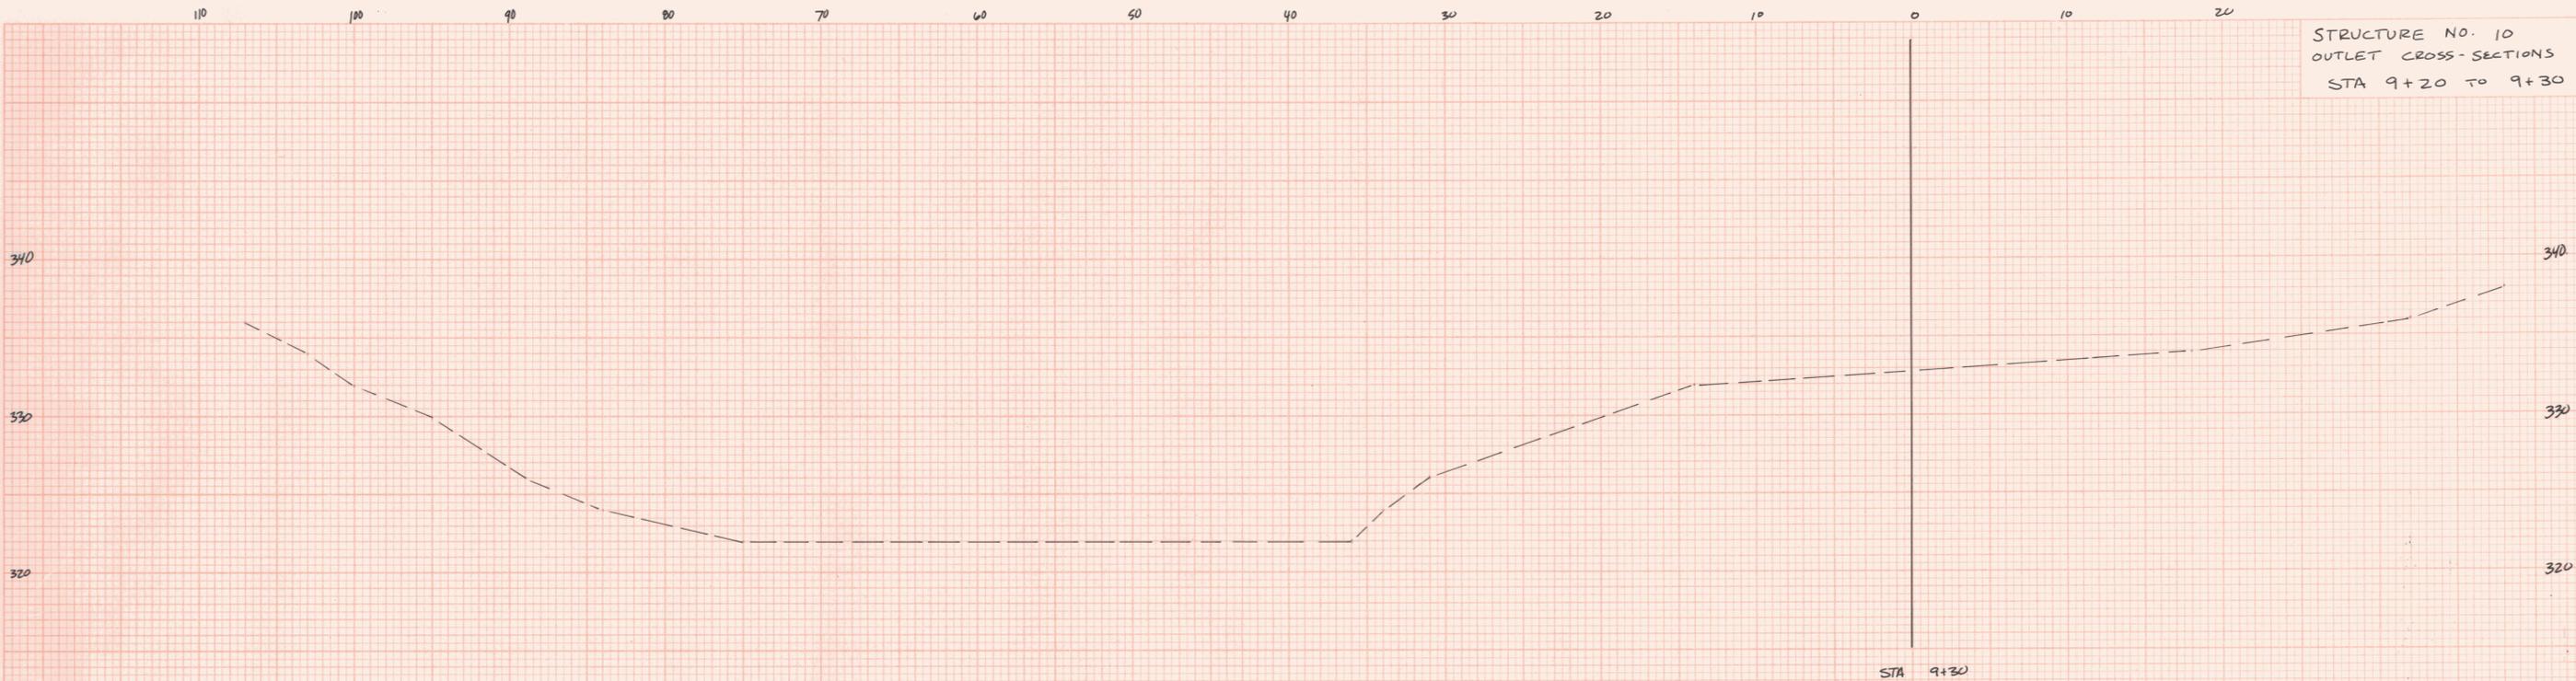

BUILT AS DESIGNED 5/24/94<sup>RG</sup>  
 FROM STA. 9+20 TO STA. 9+30  
 PROJECT NAME: ESSEX  
 NO. PB 039-1(2)  
 SHEET 364 OF 400 SHEETS  
 PLOTTED:

FINAL SURVEY  
 DATE: \_\_\_\_\_  
 BY: \_\_\_\_\_  
 ORIGINAL SURVEY  
 DATE: \_\_\_\_\_  
 BY: \_\_\_\_\_  
 NOTE BOOK NO. \_\_\_\_\_  
 AREA CHECKED \_\_\_\_\_

ORIGINAL SURVEY  
 DATE: \_\_\_\_\_  
 BY: \_\_\_\_\_  
 ORIGINAL SURVEY  
 DATE: \_\_\_\_\_  
 BY: \_\_\_\_\_  
 NOTE BOOK NO. \_\_\_\_\_  
 AREA CHECKED \_\_\_\_\_

PLATE 3-FULL CROSS SECTION-FULL LINE  
 PRINTED IN U.S.A.