


STRUCTURE NO. 10
 OUTLET CROSS-SECTIONS
 STA 9+40 TO 9+50

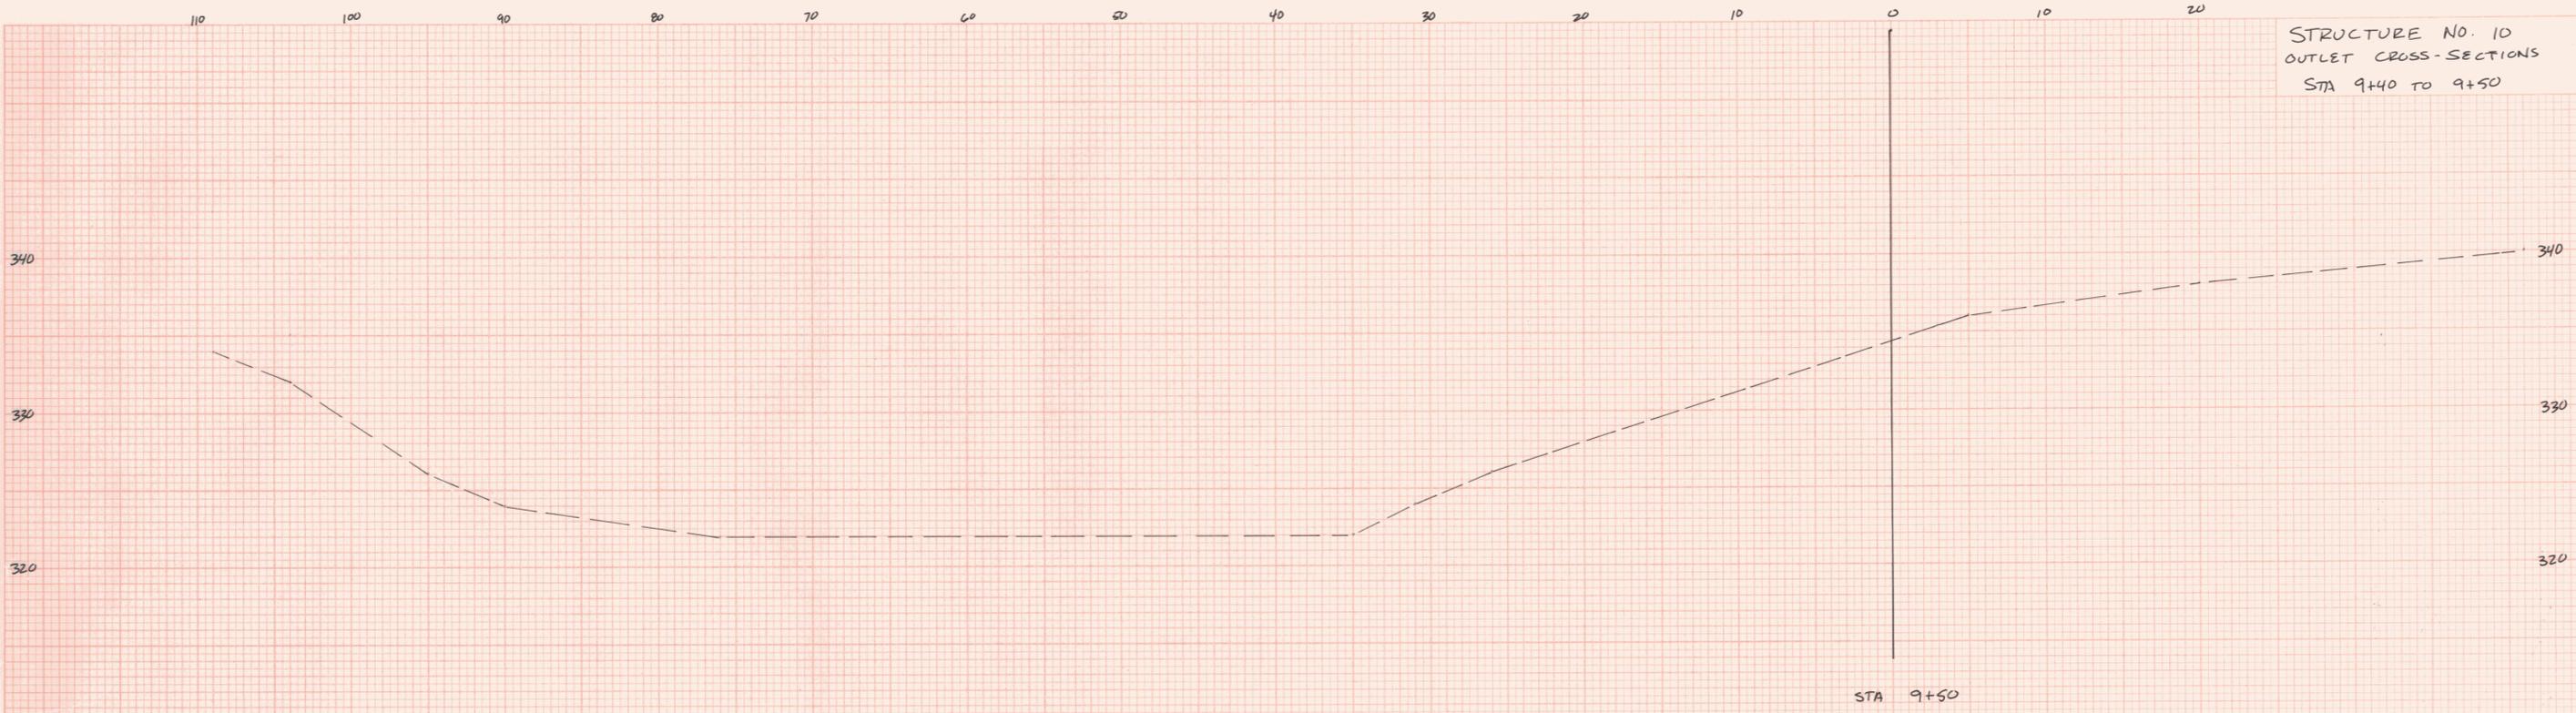

FINAL SURVEY
 DATE: _____
 BY: _____
 CHECKED: _____
 DATE: _____
 NO. _____

ORIGINAL SURVEY
 DATE: _____
 BY: _____
 CHECKED: _____
 DATE: _____
 NO. _____

BUILT AS DESIGNED 5/24/94 ^{RG}
 FROM STA. 9+40 TO STA. 9+50
 PROJECT NAME: ESSEX
 NO. PB 033-1(2) PLOTTED:
 SHEET 365 OF 400 SHEETS