


STRUCTURE NO. 10  
 OUTLET / PIPE CROSS-SECTIONS  
 STA 10+0 TO 10+50

ITEM 203.27 - 0  
 ITEM 203.32 - 74 FT<sup>2</sup>  
 ITEM 204.25 - 127 FT<sup>2</sup>  
 ITEM 613.11 - 0

DATE \_\_\_\_\_ BY \_\_\_\_\_  
 REVISIONS  
 1. \_\_\_\_\_  
 2. \_\_\_\_\_  
DATE \_\_\_\_\_ BY \_\_\_\_\_  
 REVISIONS  
 1. \_\_\_\_\_  
 2. \_\_\_\_\_  
 3. \_\_\_\_\_  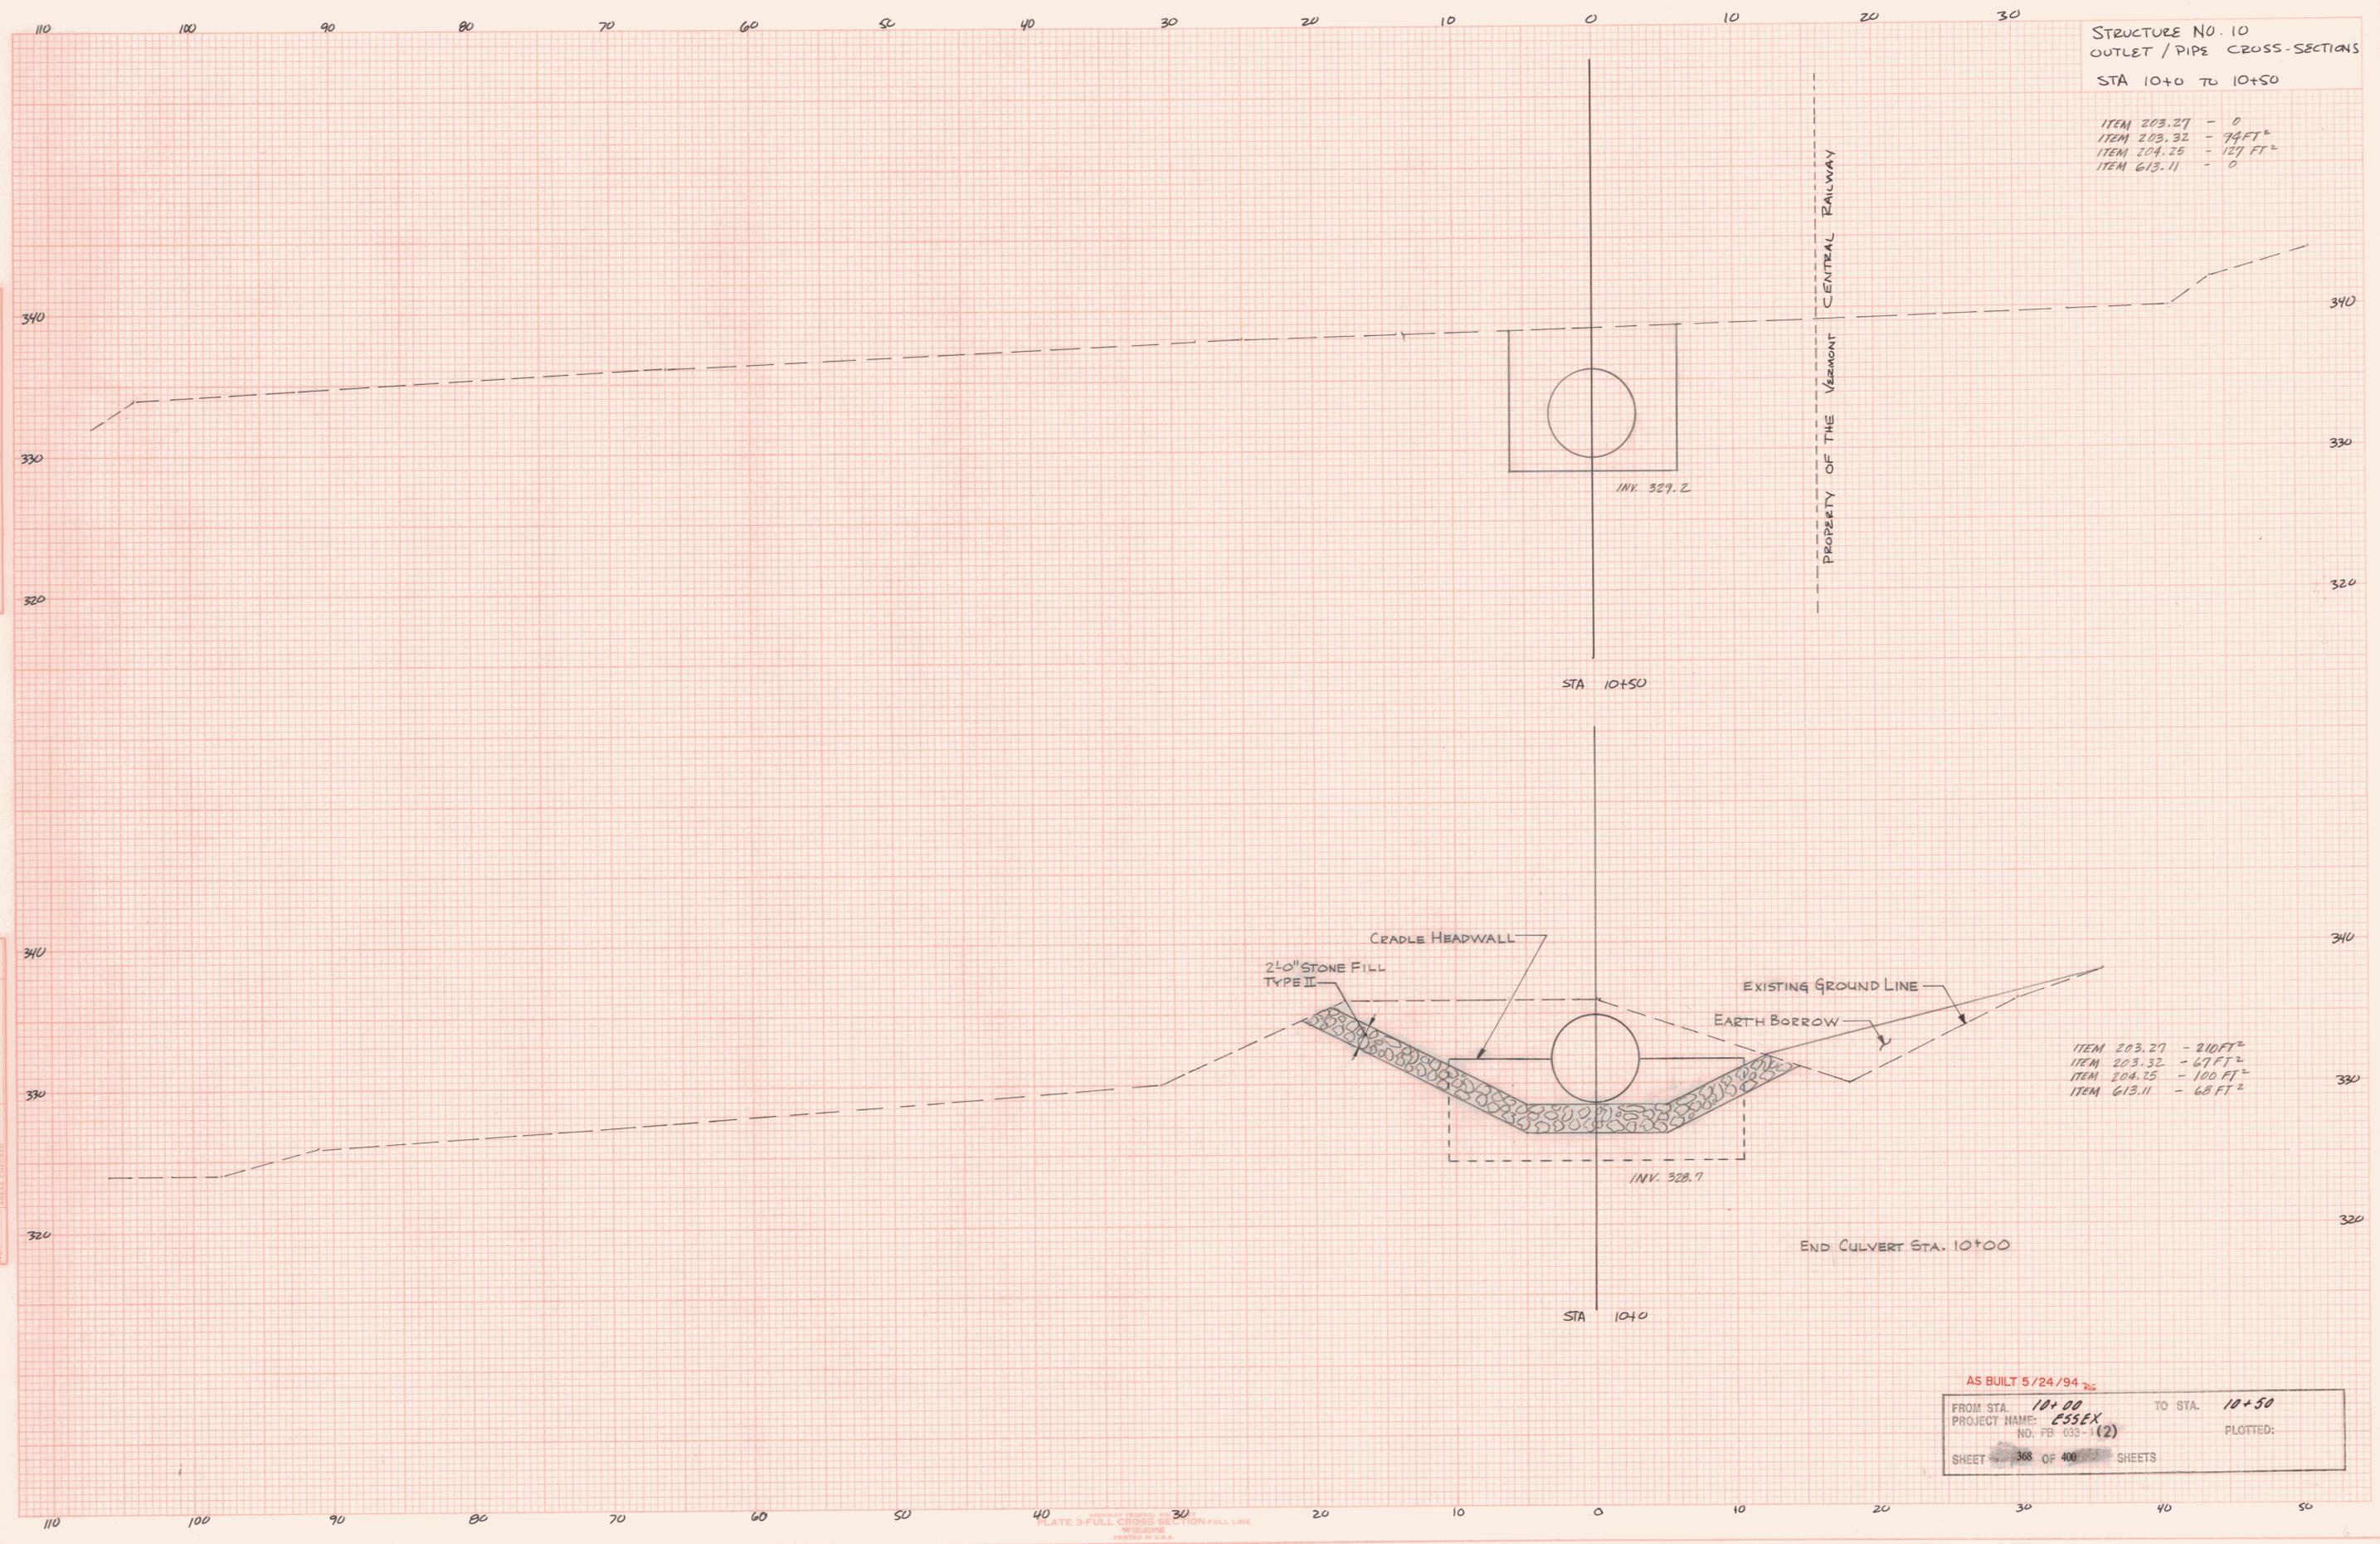
ITEM 203.27 - 210 FT<sup>2</sup>  
 ITEM 203.32 - 67 FT<sup>2</sup>  
 ITEM 204.25 - 100 FT<sup>2</sup>  
 ITEM 613.11 - 68 FT<sup>2</sup>

AS BUILT 5/24/94  
 FROM STA. 10+00 TO STA. 10+50  
 PROJECT NAME: ESSEX  
 NO. PB 033- (2)  
 SHEET 308 OF 400 SHEETS  
 PLOTTED: