


STRUCTURE NO. 10
INLET CROSS-SECTIONS
STA 14+35 TO 14+45

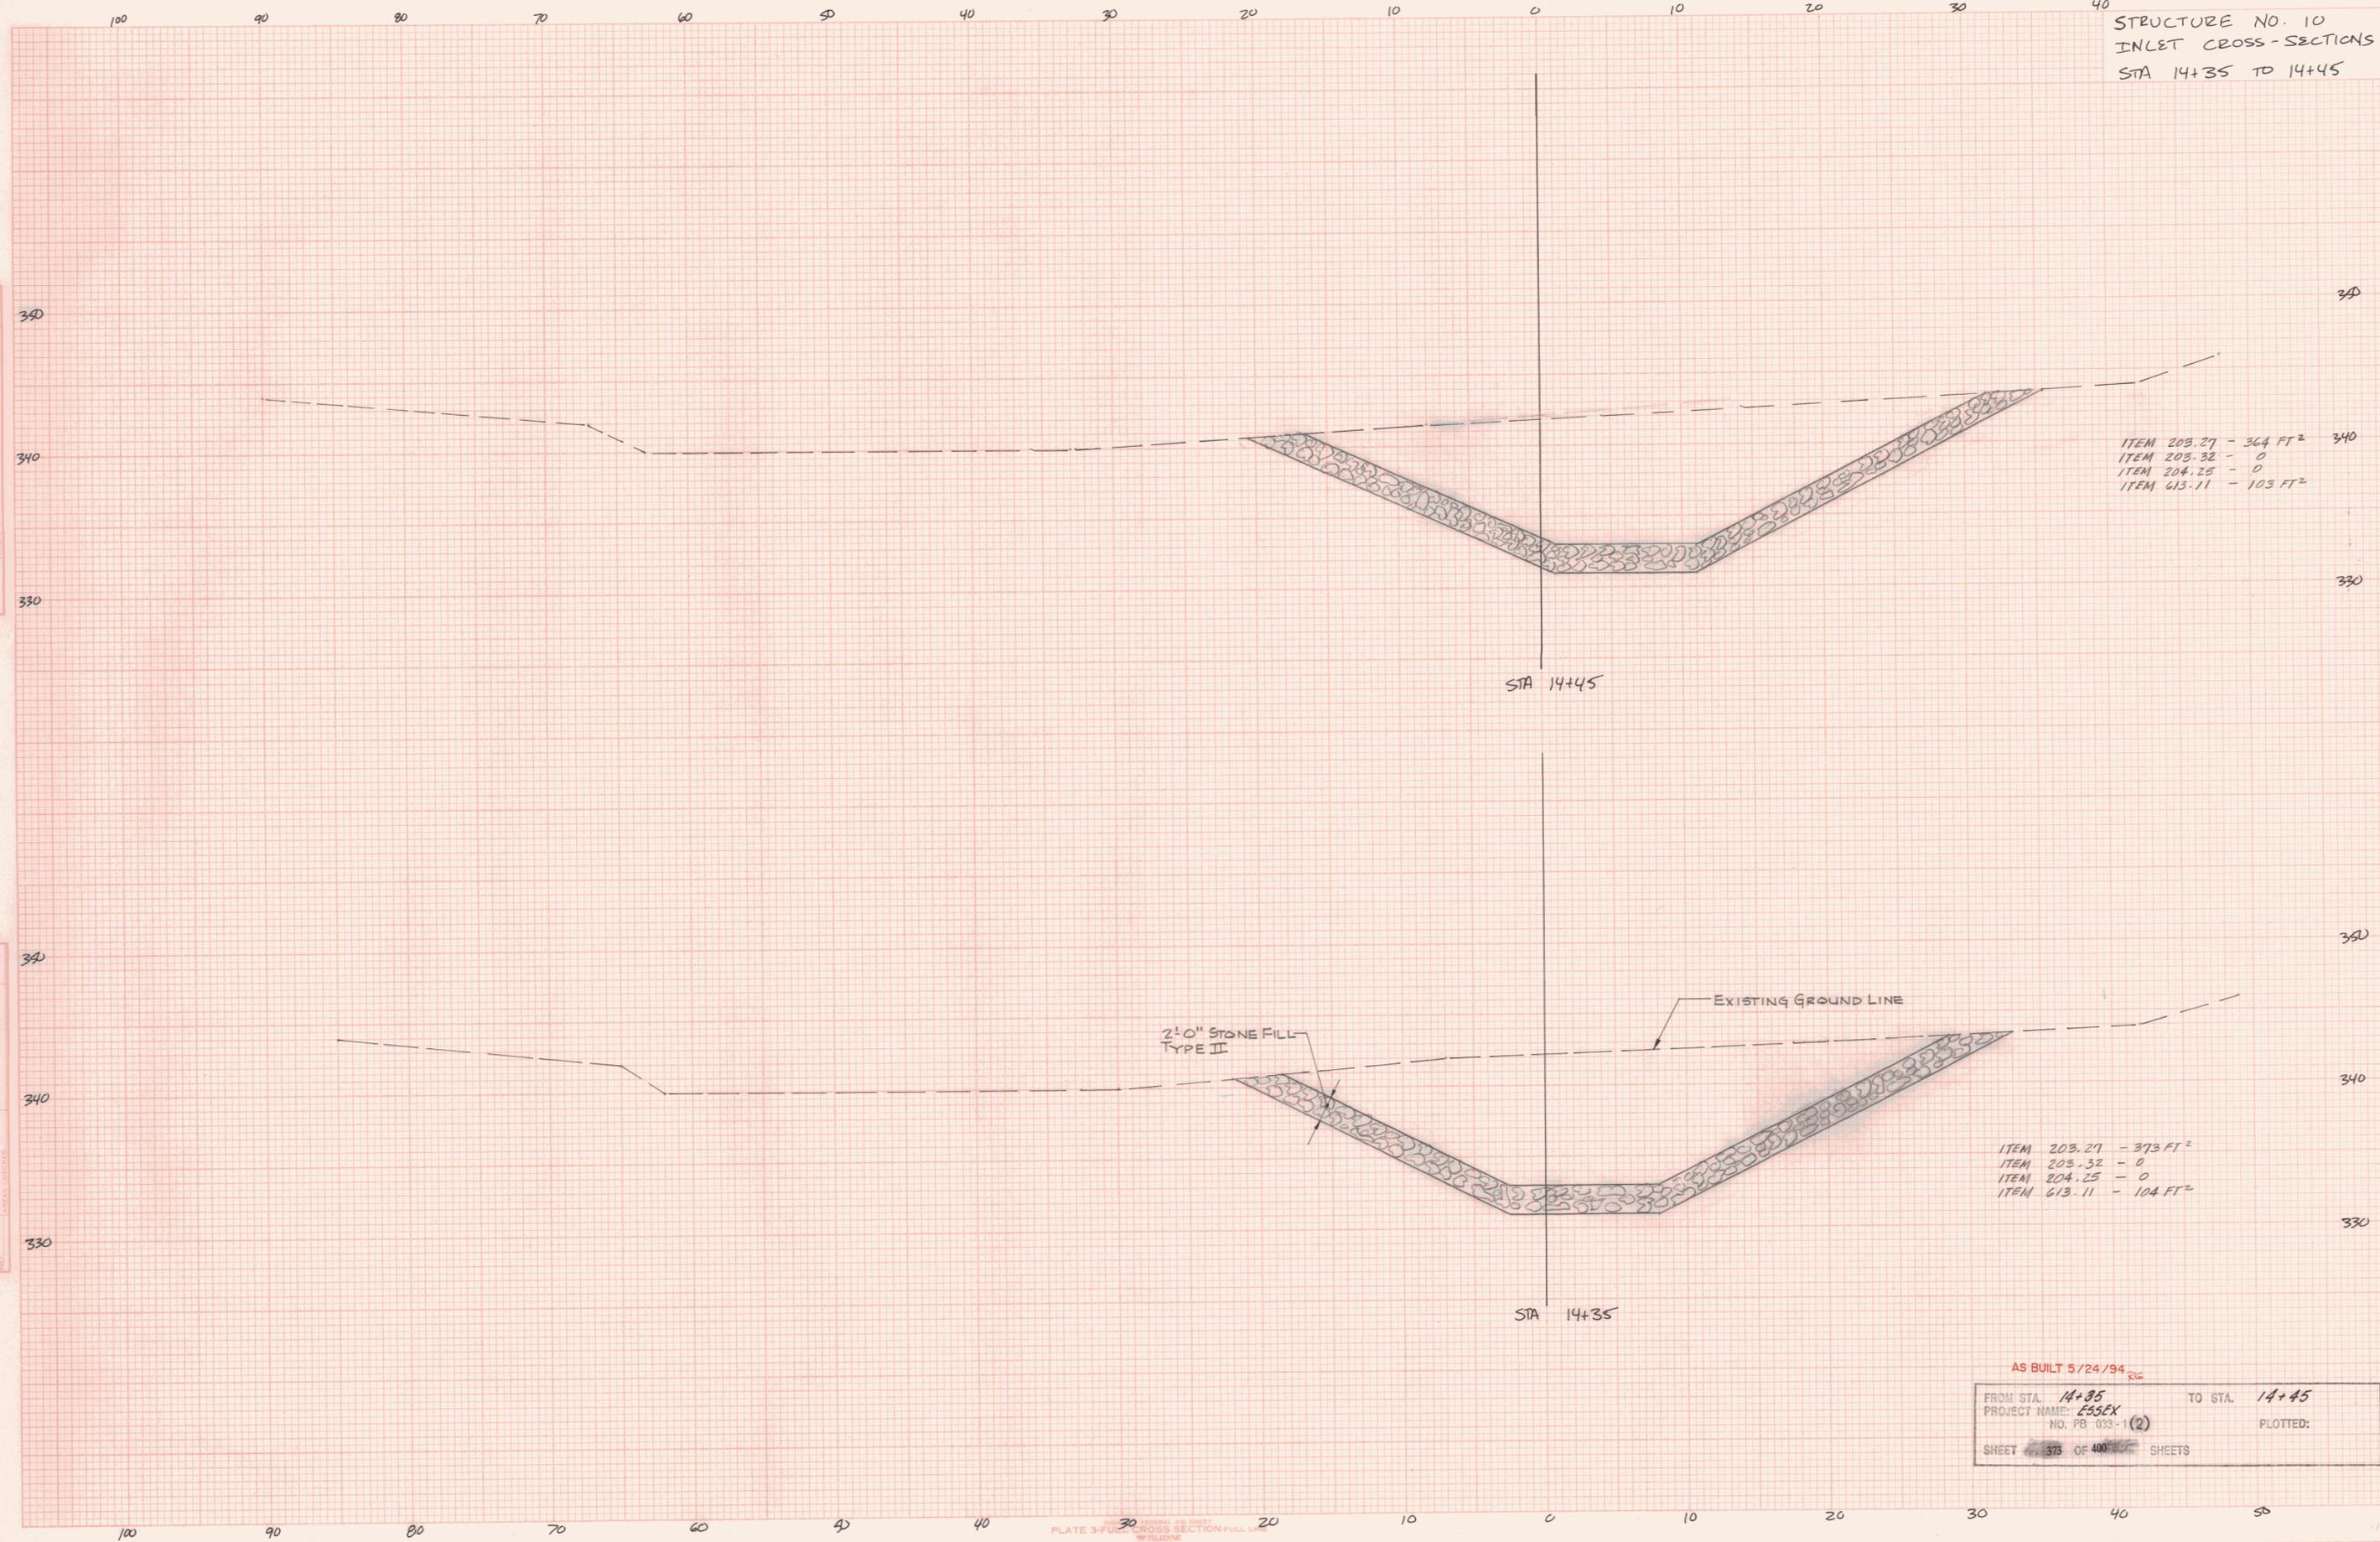

DATE
BY
FINAL SURVEY
BLANKETED
SURVEY
NOTE BOOK
TEMP. PLATE
NO.
AREA CHECKED

DATE
BY
ORIGINAL SURVEY
BLANKETED
SURVEY
NOTE BOOK
TEMP. PLATE
NO.
AREA CHECKED

AS BUILT 5/24/94
 FROM STA. 14+35 TO STA. 14+45
 PROJECT NAME: ESSEX
 NO. PB 033-1 (2) PLOTTED:
 SHEET 375 OF 400 SHEETS