


STRUCTURE NO. 10
INLET CROSS-SECTIONS
STA 15+35 TO 15+45

DATE: _____ BY: _____
FINAL SURVEY: _____
SURVEY: _____
NOTE BOOK: _____
NO. _____

DATE: _____ BY: _____
ORIGINAL SURVEY: _____
SURVEY: _____
NOTE BOOK: _____
NO. _____

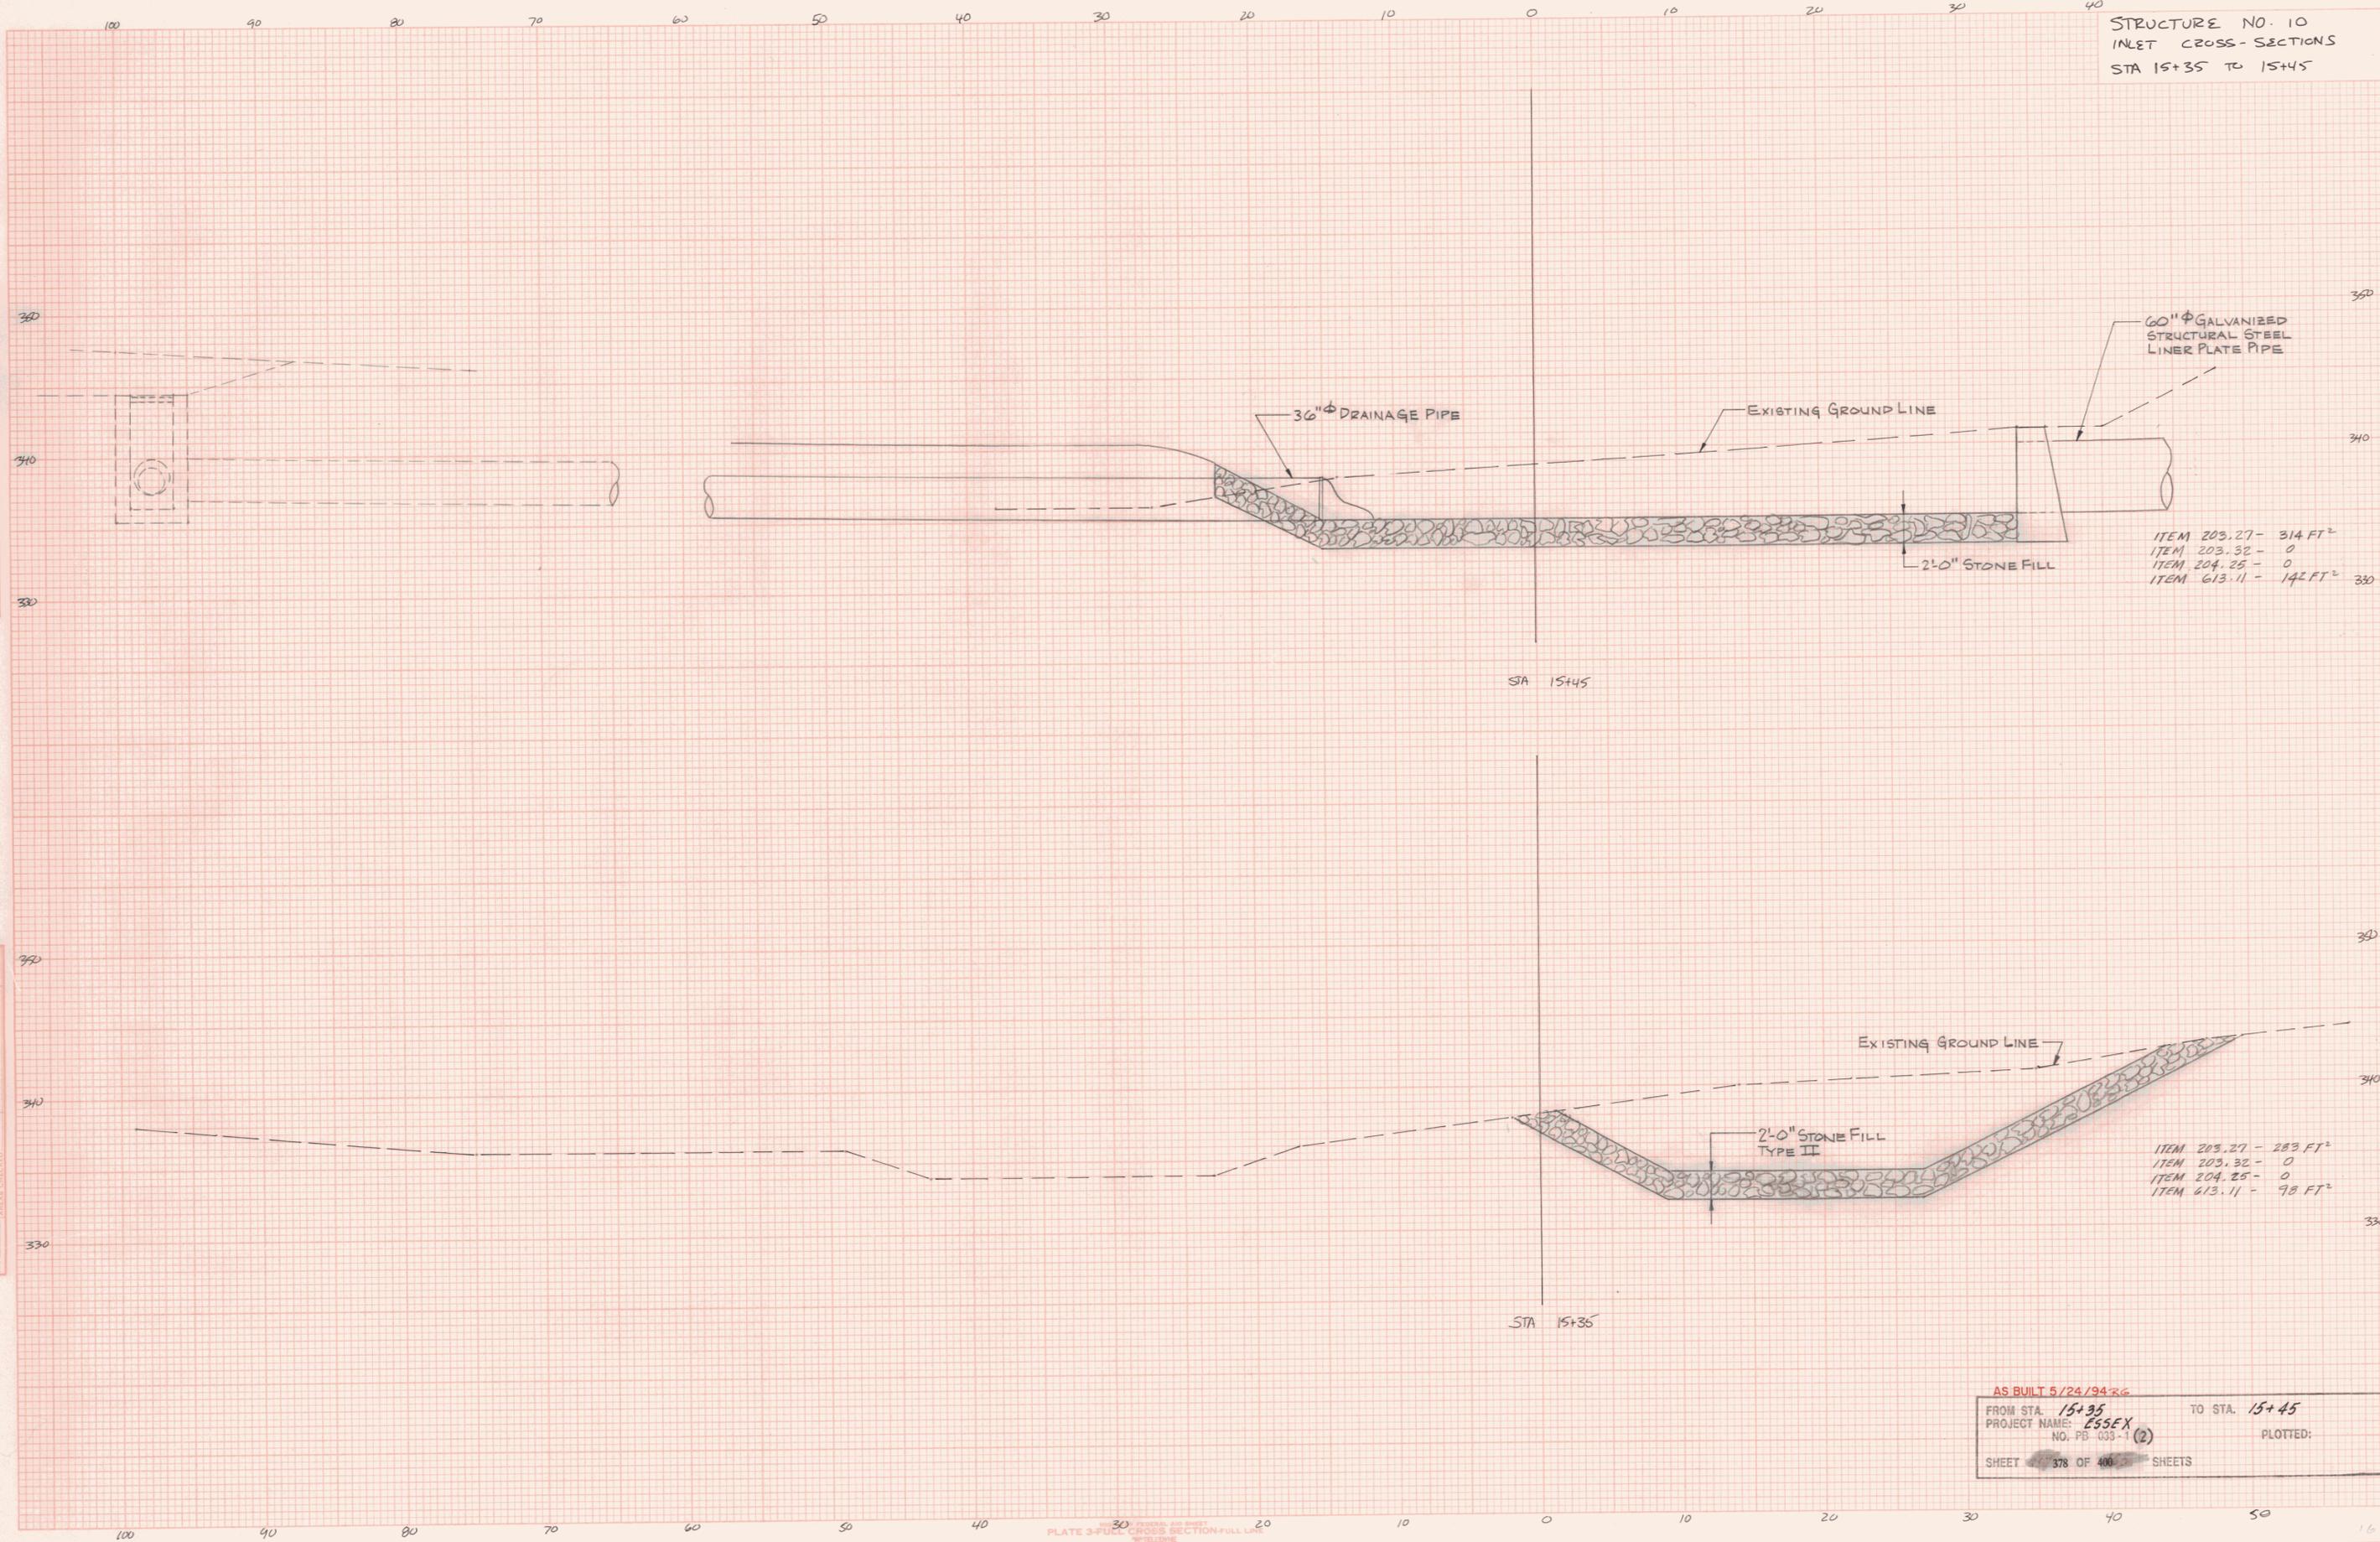

ITEM 203.27 - 314 FT²
ITEM 203.32 - 0
ITEM 204.25 - 0
ITEM 613.11 - 142 FT²

ITEM 203.27 - 283 FT²
ITEM 203.32 - 0
ITEM 204.25 - 0
ITEM 613.11 - 98 FT²

AS BUILT 5/24/94-RG
FROM STA. 15+35 TO STA. 15+45
PROJECT NAME: ESSEX
NO. PB 033-1 (2) PLOTTED:
SHEET 378 OF 400 SHEETS