


STRUCTURE NO. 10  
 INLET CROSS-SECTIONS  
 STA 15+55 TO 15+65

DATE \_\_\_\_\_  
 BY \_\_\_\_\_  
 FINAL SURVEY  
 SURVEYED \_\_\_\_\_  
 PLOTTED \_\_\_\_\_  
 NOTE BOOK NO. \_\_\_\_\_  
 TEMPLATE NO. \_\_\_\_\_  
 AREA CHECKED \_\_\_\_\_

DATE \_\_\_\_\_  
 BY \_\_\_\_\_  
 ORIGINAL SURVEY  
 SURVEYED \_\_\_\_\_  
 PLOTTED \_\_\_\_\_  
 NOTE BOOK NO. \_\_\_\_\_  
 TEMPLATE NO. \_\_\_\_\_  
 AREA CHECKED \_\_\_\_\_

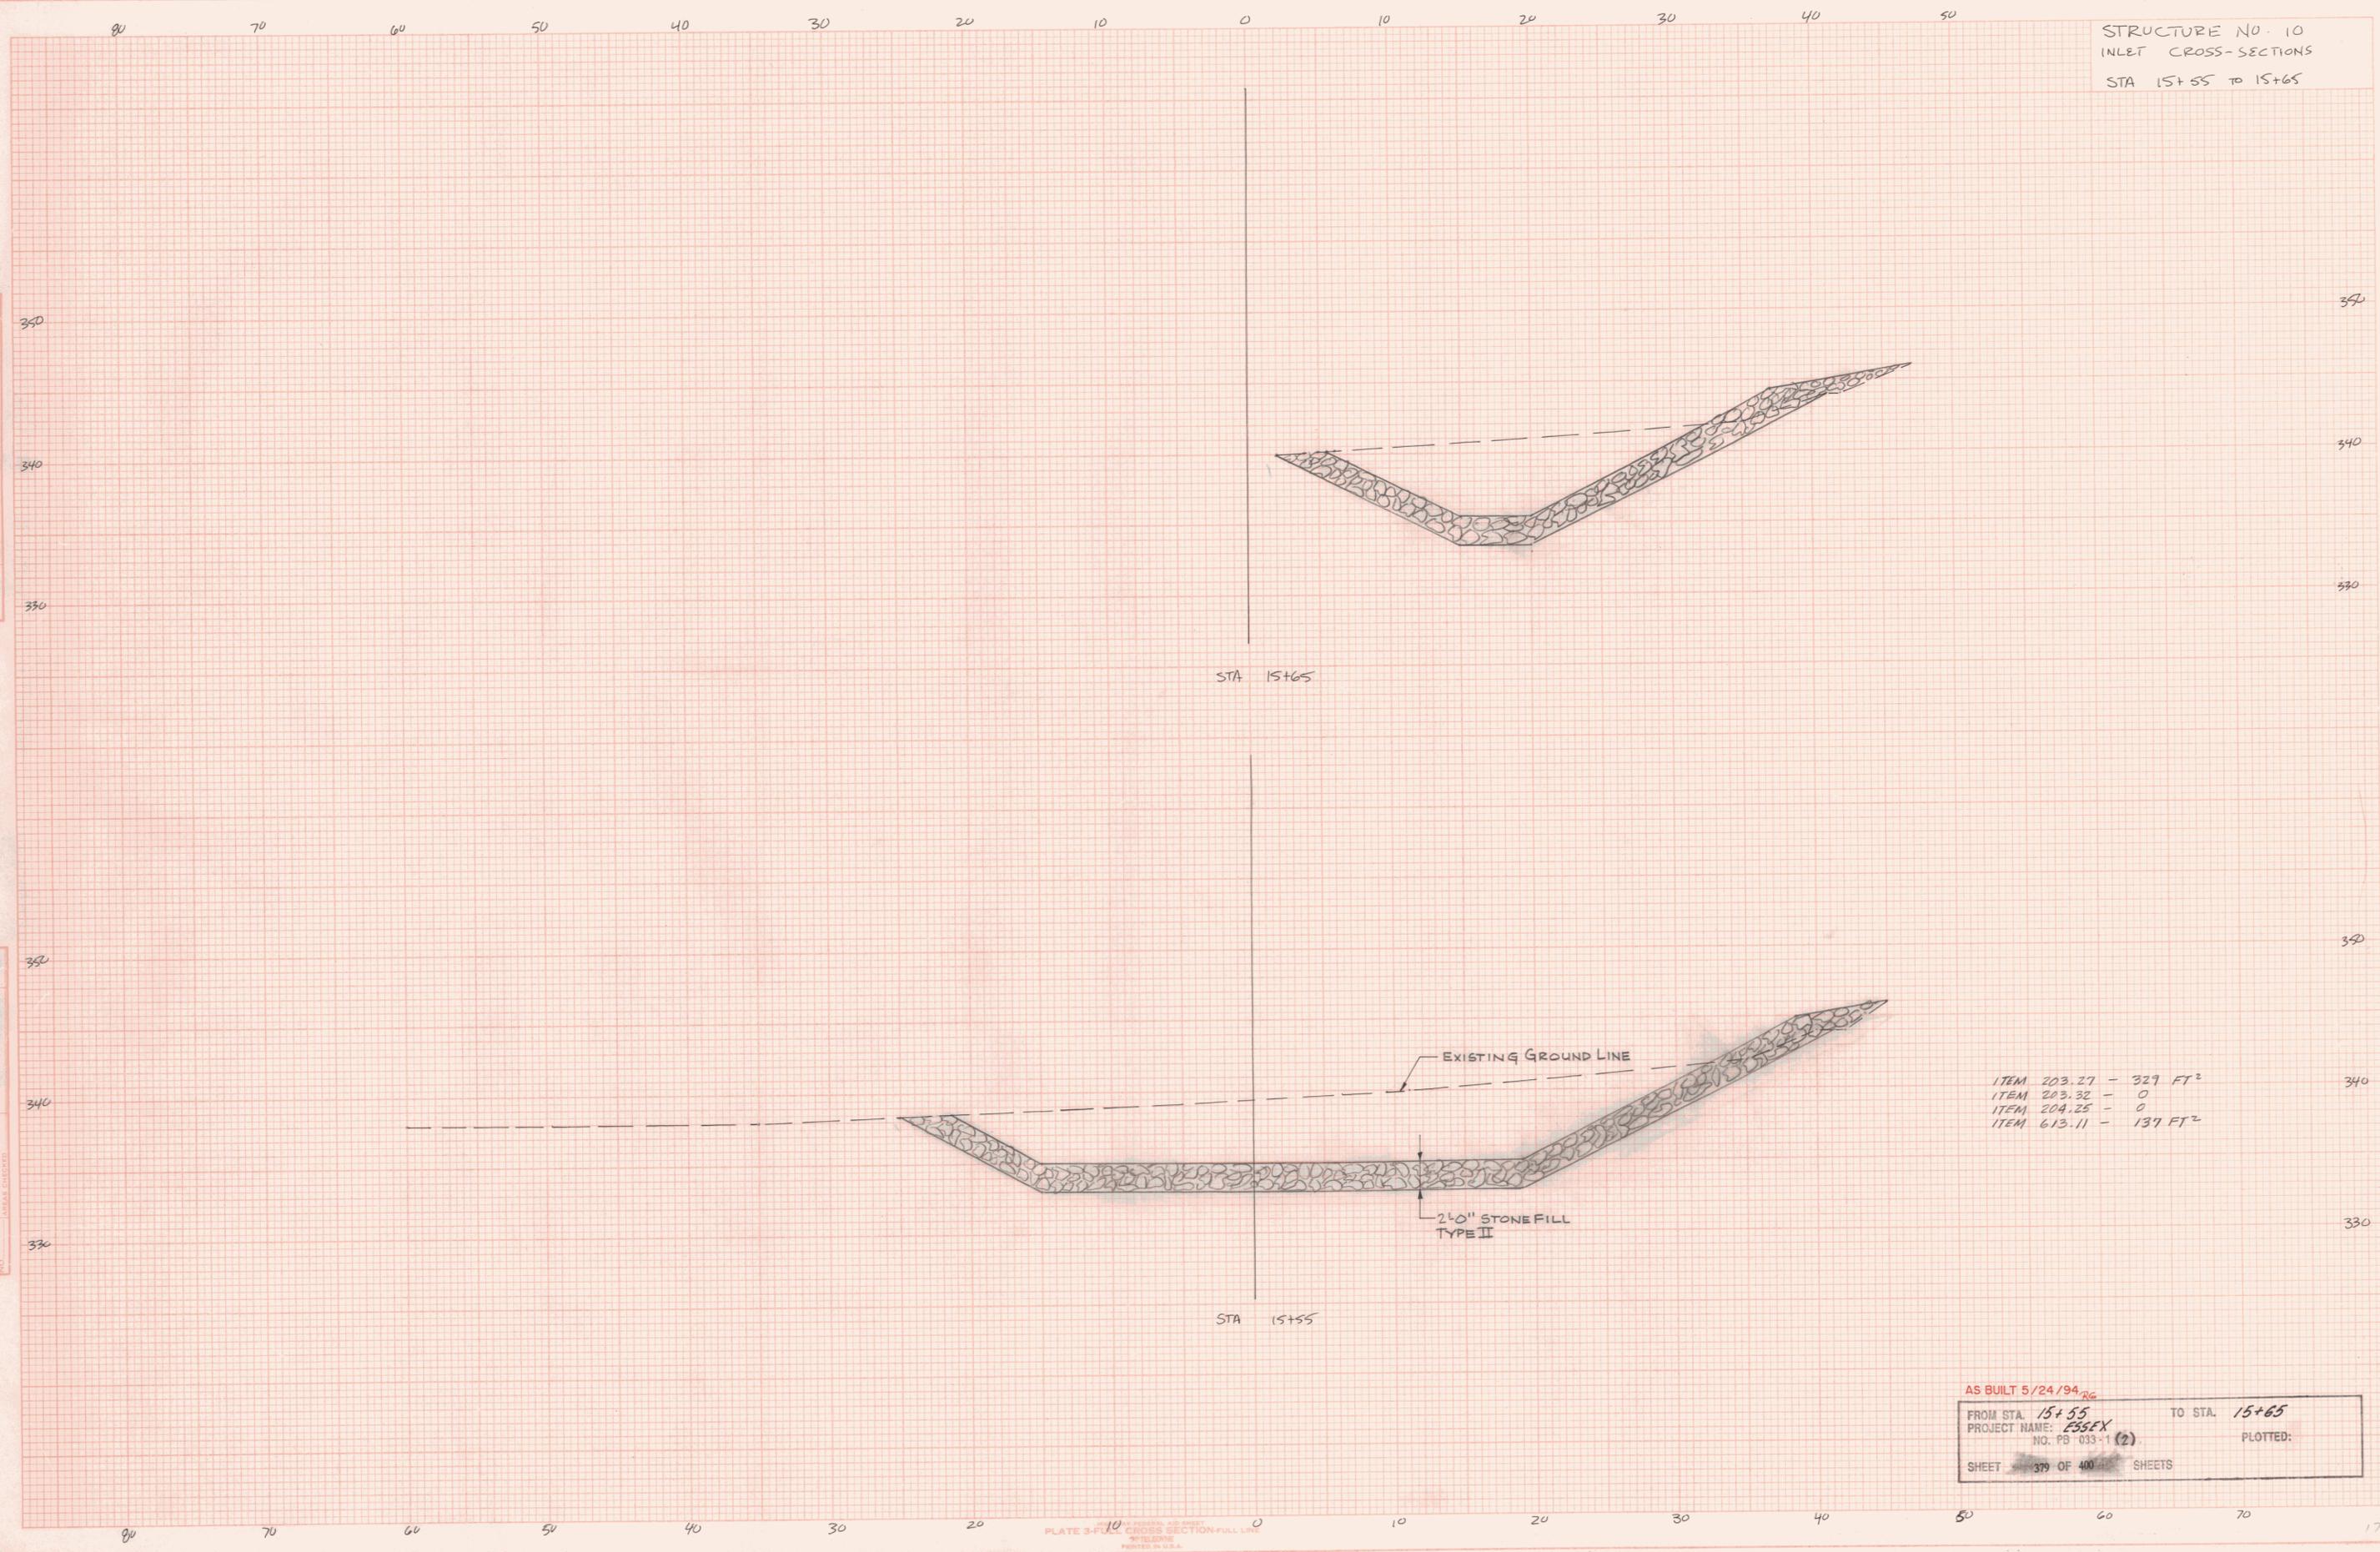

ITEM 203.27 - 329 FT<sup>2</sup>  
 ITEM 203.32 - 0  
 ITEM 204.25 - 0  
 ITEM 613.11 - 137 FT<sup>2</sup>

AS BUILT 5/24/94<sub>RG</sub>  
 FROM STA. 15+55 TO STA. 15+65  
 PROJECT NAME: ESSEX  
 NO. PB 033-1 (2) PLOTTED:  
 SHEET 379 OF 400 SHEETS