

TYPICAL DOWNSTREAM LEVEL LIP EL. 358.0', EXCEPT IN AREA ADJACENT TO NORTHERN ARCHAEOLOGICAL SITE. SEE CROSS-SECTION 1+00 THIS SHEET AND SHEET WM 101.


NOTE: ALL LEVEL SPREADER NON-STONEFILL SIDE SLOPES SHALL BE 1V:3H

NOTE: ALL LEVEL SPREADER STONE FILL SIDE SLOPES SHALL BE 1V:2H

NOTE: RAMP A INFORMATION IS NOT ILLUSTRATED ON THESE CROSS-SECTIONS. REFER TO MAIN LINE CROSS-SECTIONS FOR ALL APPROPRIATE RAMP AND MAINLINE INFORMATION

AS BUILT 5/24/94

DATUM  
 VERTICAL NGVD 1929  
 HORIZONTAL

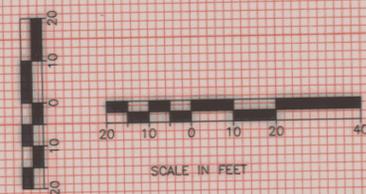

 engineering    planning    management    development	CHITTENDEN COUNTY CIRCUMFERENTIAL HIGHWAY		DRAWN BY TJD	DATE APRIL 1991
	VERMONT ROUTE 289 WILLISTON-COLCHESTER PB 033-1(2) CVRR WETLAND CROSS SECTIONS		CHECKED BY 	PROJ. NO. R11304PC
			PROJ. ENG. JUT	DRAW. NO. 7567
			SHEET 383 OF 400 WM 103	