


NOTE: SEE BRIDGE SHEET BR10 AND 1103 STRUCTURE #11 PLAN AND DETAILS.

AS BUILT 5/24/94

DATUM
 VERTICAL NGVD 1929
 HORIZONTAL

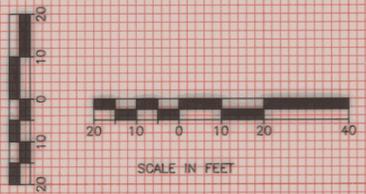

DuBois & King
 INC.
 engineering planning management development

CHITTENDEN COUNTY
 CIRCUMFERENTIAL HIGHWAY
 VERMONT ROUTE 289
 WILLISTON-COLCHESTER PB 033-1(2)
 CVRR WETLAND CROSS SECTIONS

DRAWN BY EBS	DATE APRIL 1991
CHECKED BY JKB	PROJ. NO. R11304PC
PROJ. ENG. JUT	DRAW. NO. 7568
SHEET 384 OF 400 WM 104	