

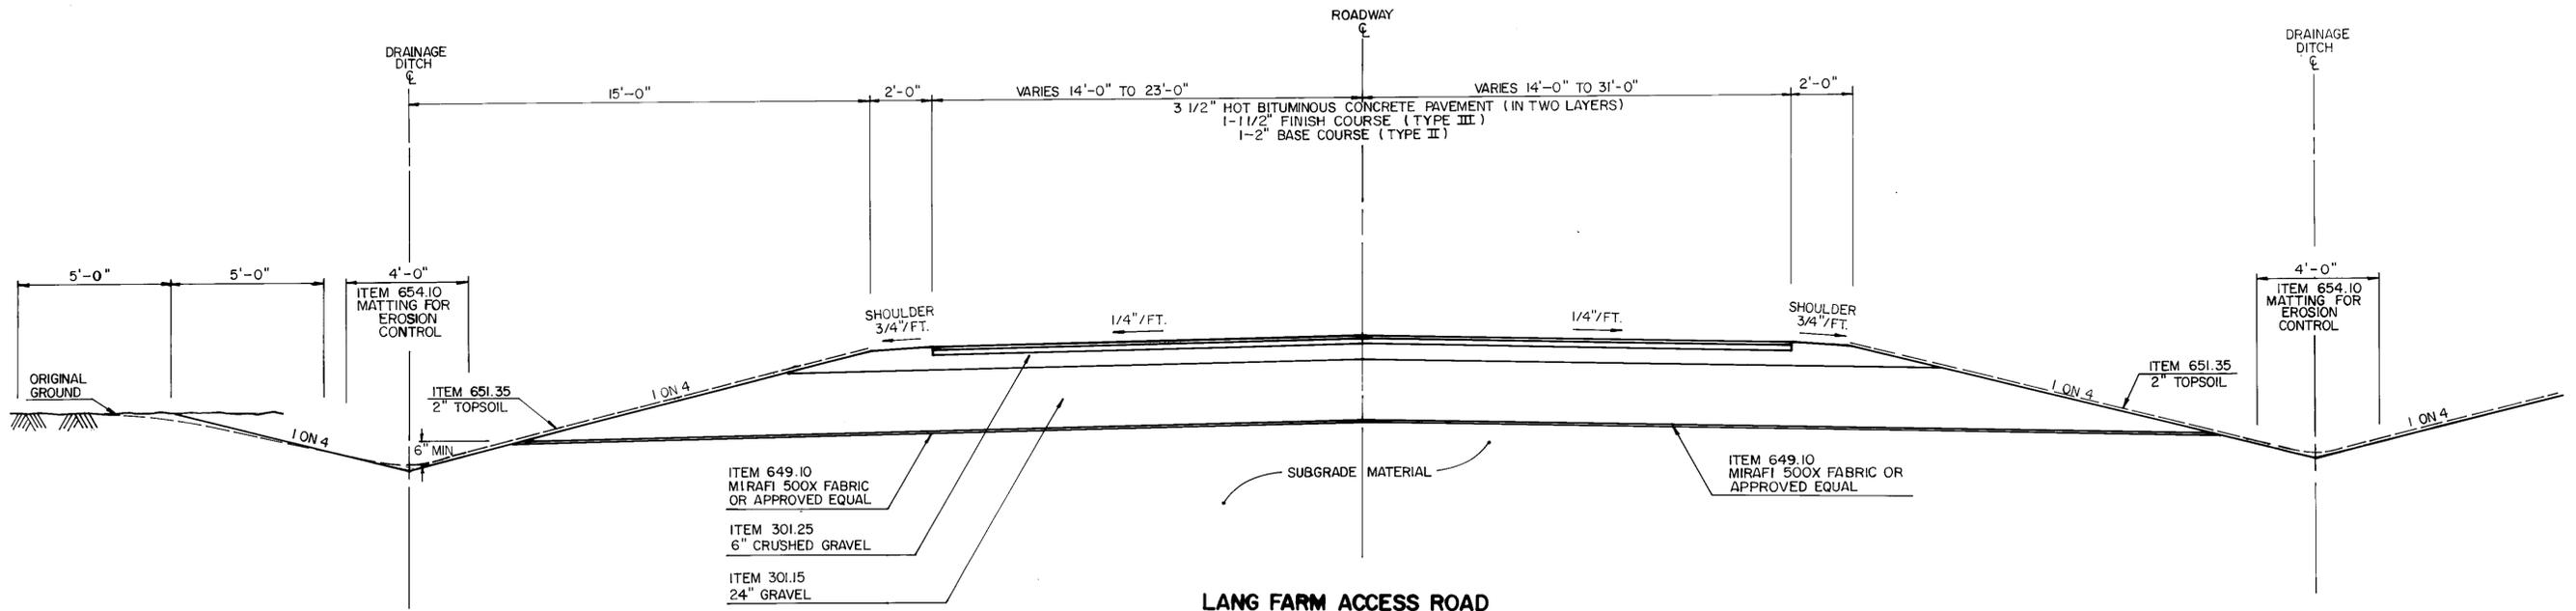


PLAN	SURVEYED	DATE
	ALIGNED CHECKED	
NOTE BOOK NO.	BY	
	DATE	

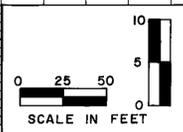

LANG FARM ACCESS ROAD TYPICAL SECTION
APPROX SCALE: 3/8"=1'-0"

PROFILE	SURVEYED	DATE
	GRADES CHECKED	
NOTE BOOK NO.	BY	
	DATE	

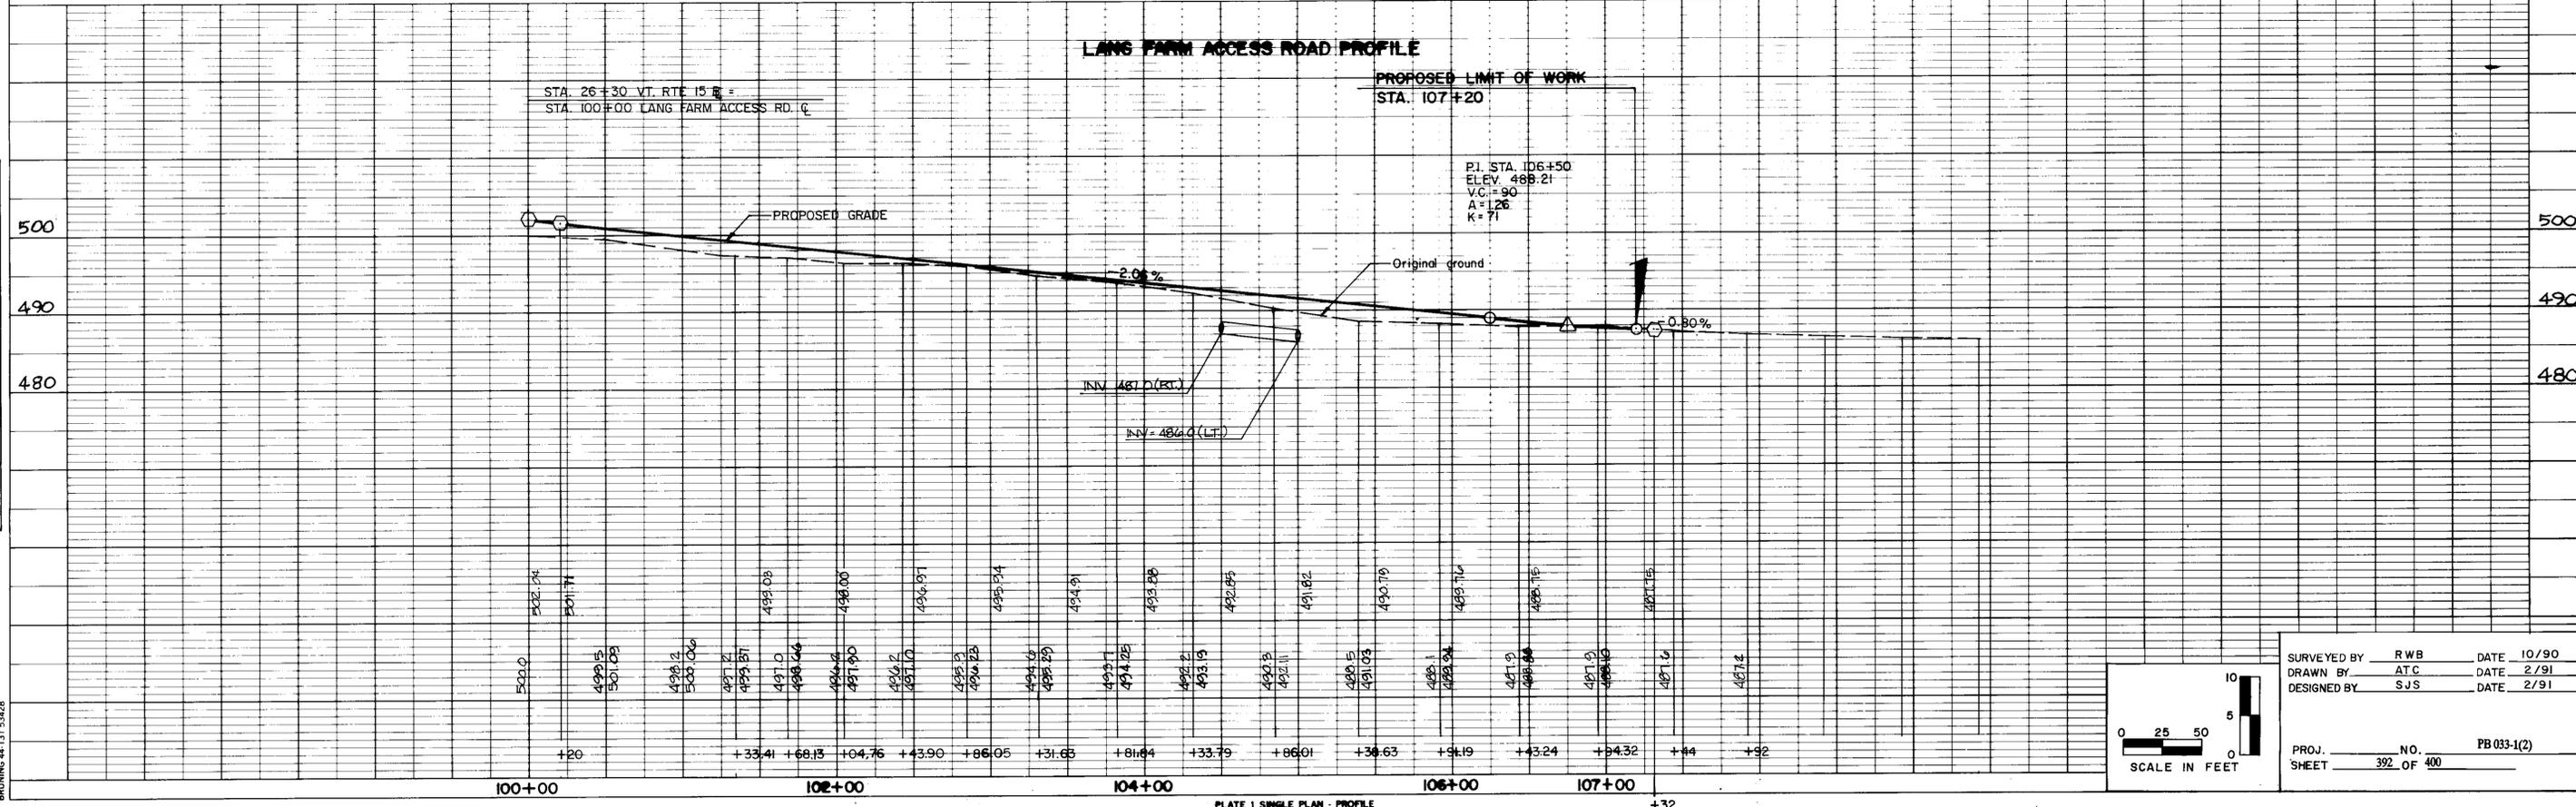

SURVEYED BY	RWB	DATE	10/90
DRAWN BY	ATC	DATE	2/91
DESIGNED BY	SJS	DATE	2/91
PROJ. NO.	PB 033-1(2)		
SHEET	392 OF 400		